

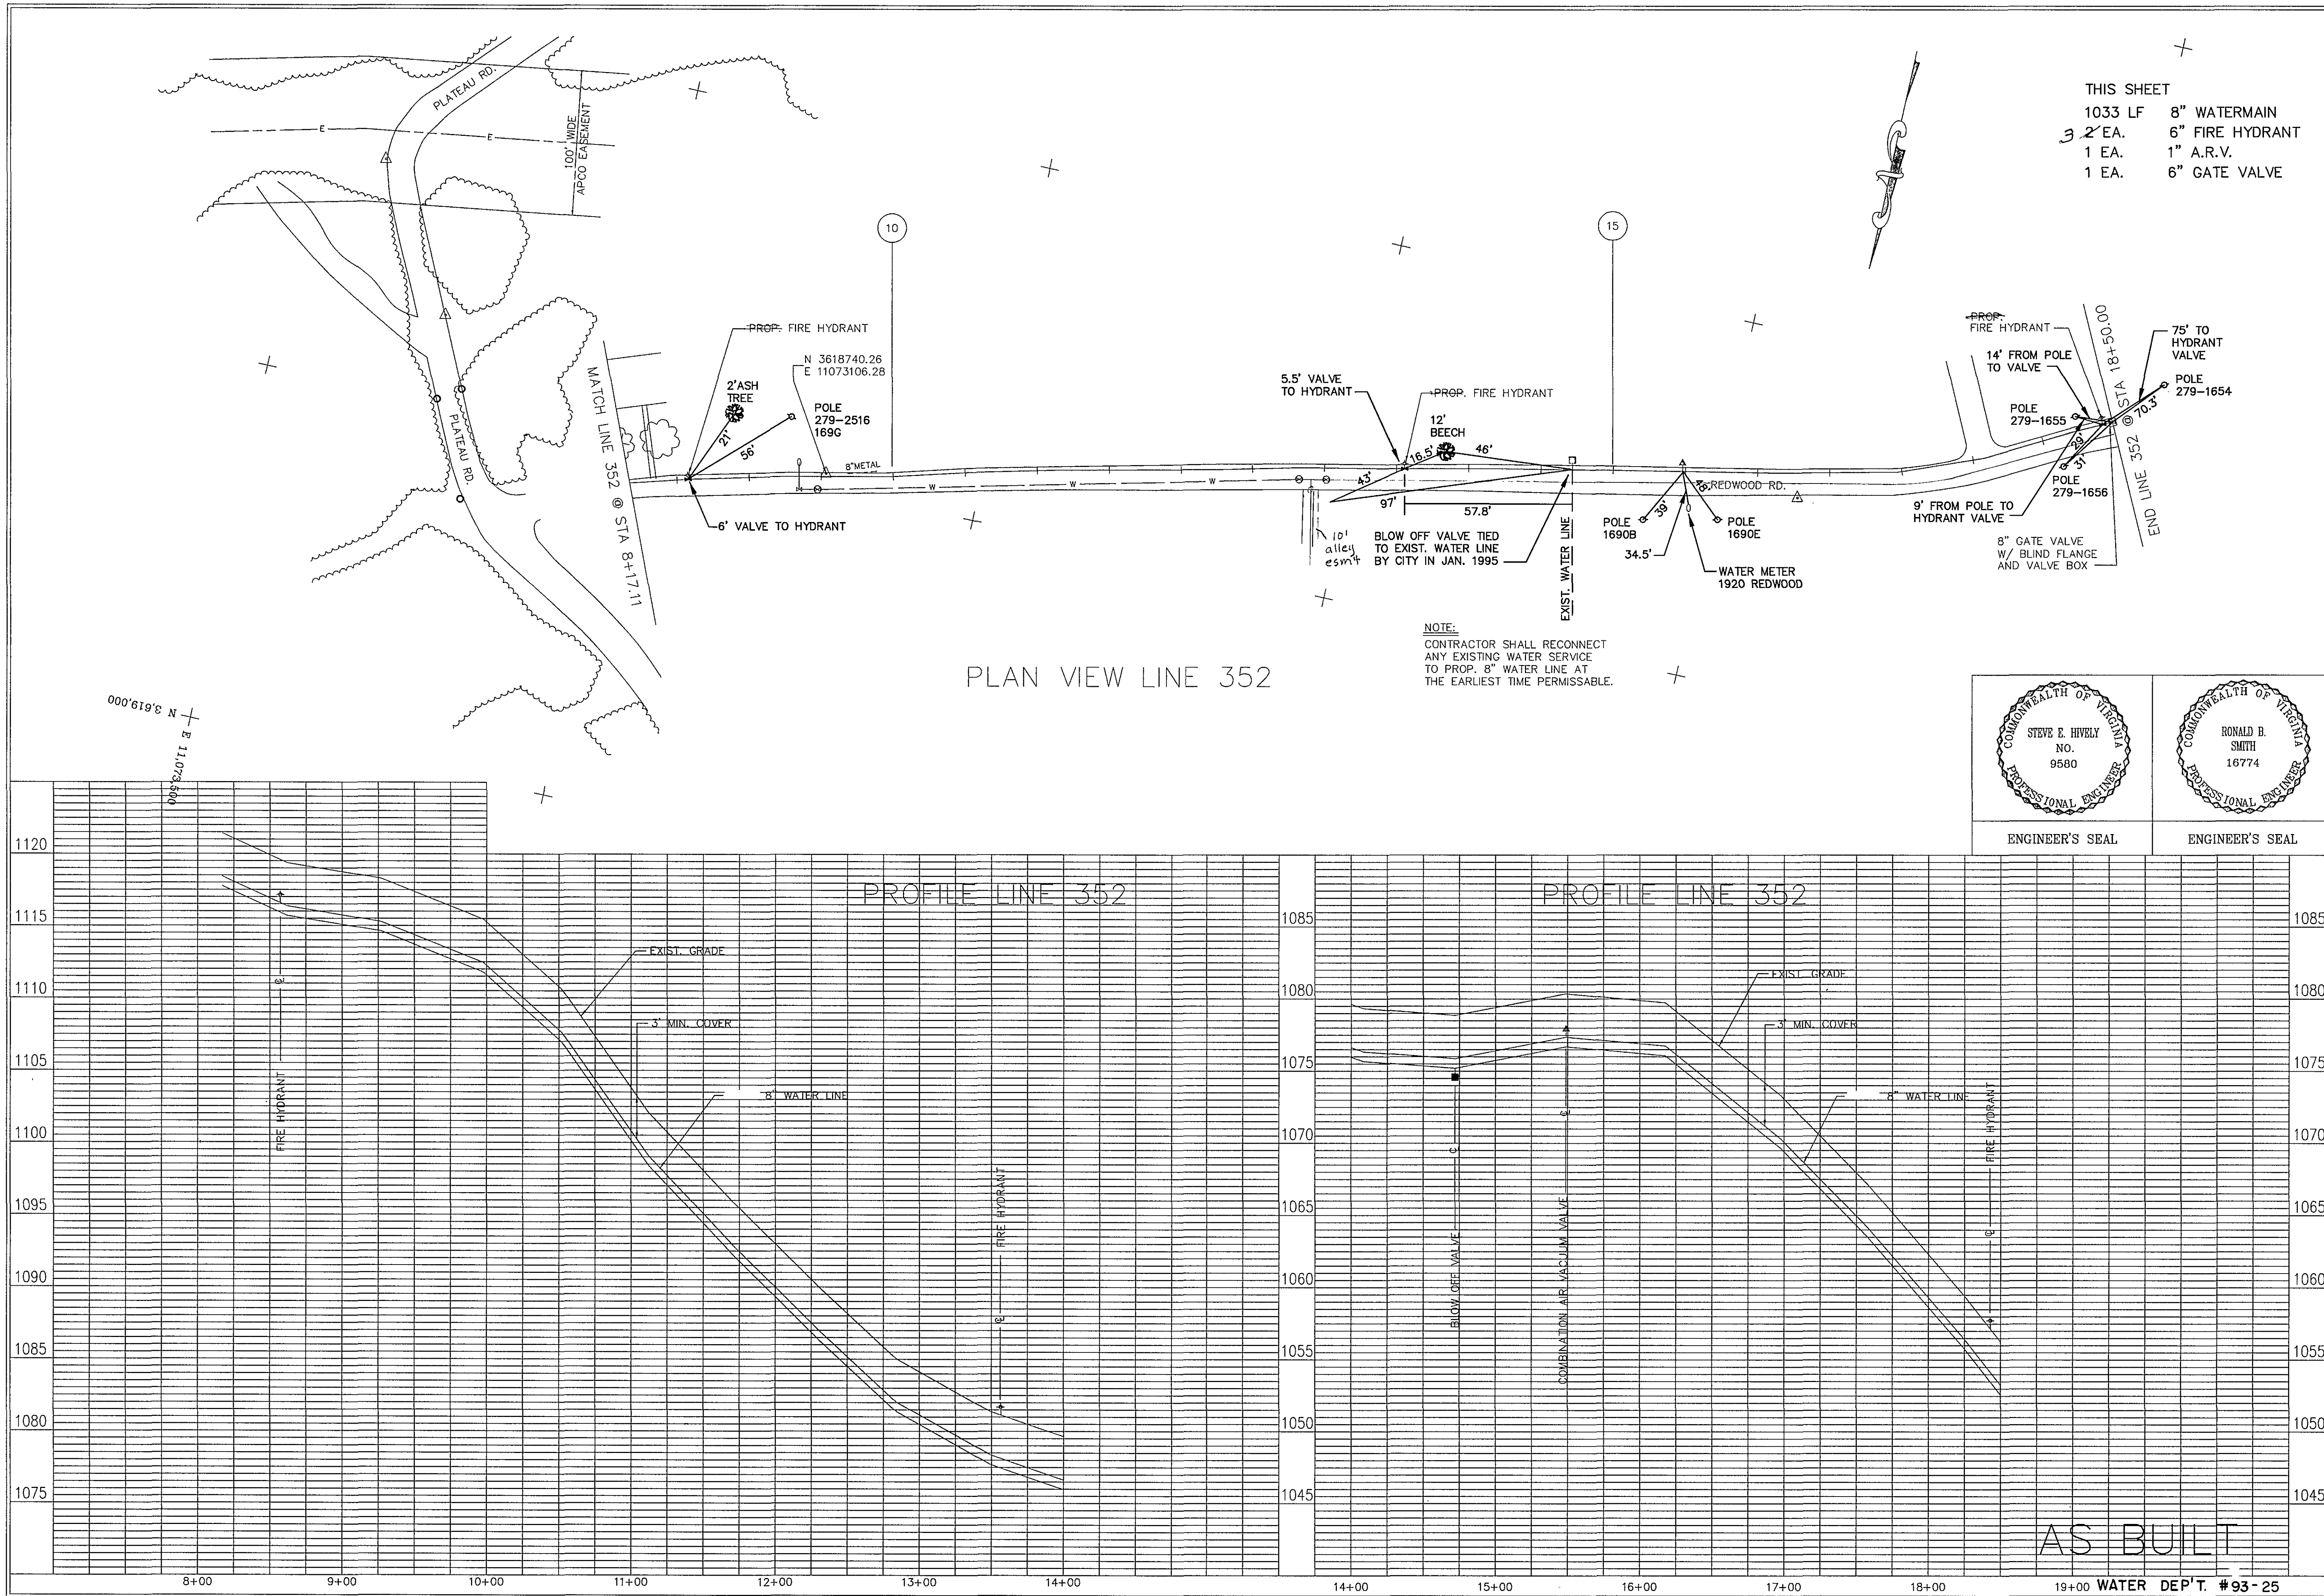


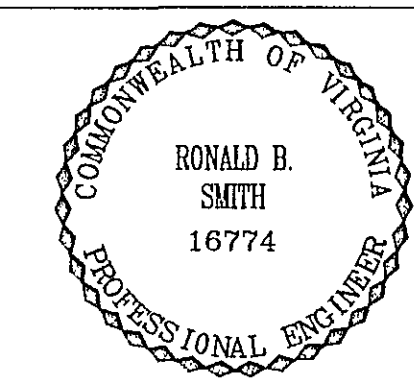

THIS SHEET
1033 LF 8" WATERMAIN
3 2' EA. 6" FIRE HYDRANT
1 EA. 1" A.R.V.
1 EA. 6" GATE VALVE

NOTE:
CONTRACTOR SHALL RECONNECT
ANY EXISTING WATER SERVICE
TO PROP. 8" WATER LINE AT
THE EARLIEST TIME PERMISSABLE.

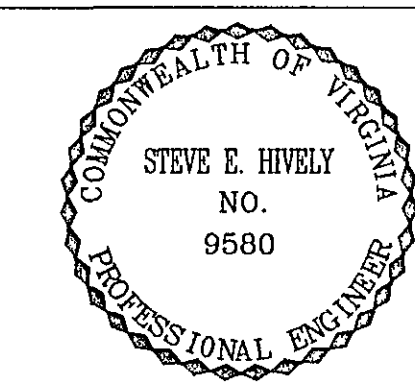

ENGINEER'S SEAL

ENGINEER'S SEAL

Architects
Engineers
Planners
Surveyors
Dewberry & Davis
5238 Valleypointe Parkway, Suite One-B
Roanoke, Virginia 24019
703 862-7725

Carvins Cove, Phase II
City of Roanoke
Roanoke, Virginia

CONTRACT "C2"
END LINE 352
STA 8+17.11 - 18+50.00

Drawn By REH/ACF
Designed By RBS
Checked By SEH
Date MARCH 93
Scale V: 1" = 5'
H: 1" = 50'
Plan Number MTP-2
Zoned NONE
Sheet 16 of 25
File Number C1160

AS BUILT

WATER DEP'T. #93-25