



THIS SHEET
1197 LF 24" WATERMAIN

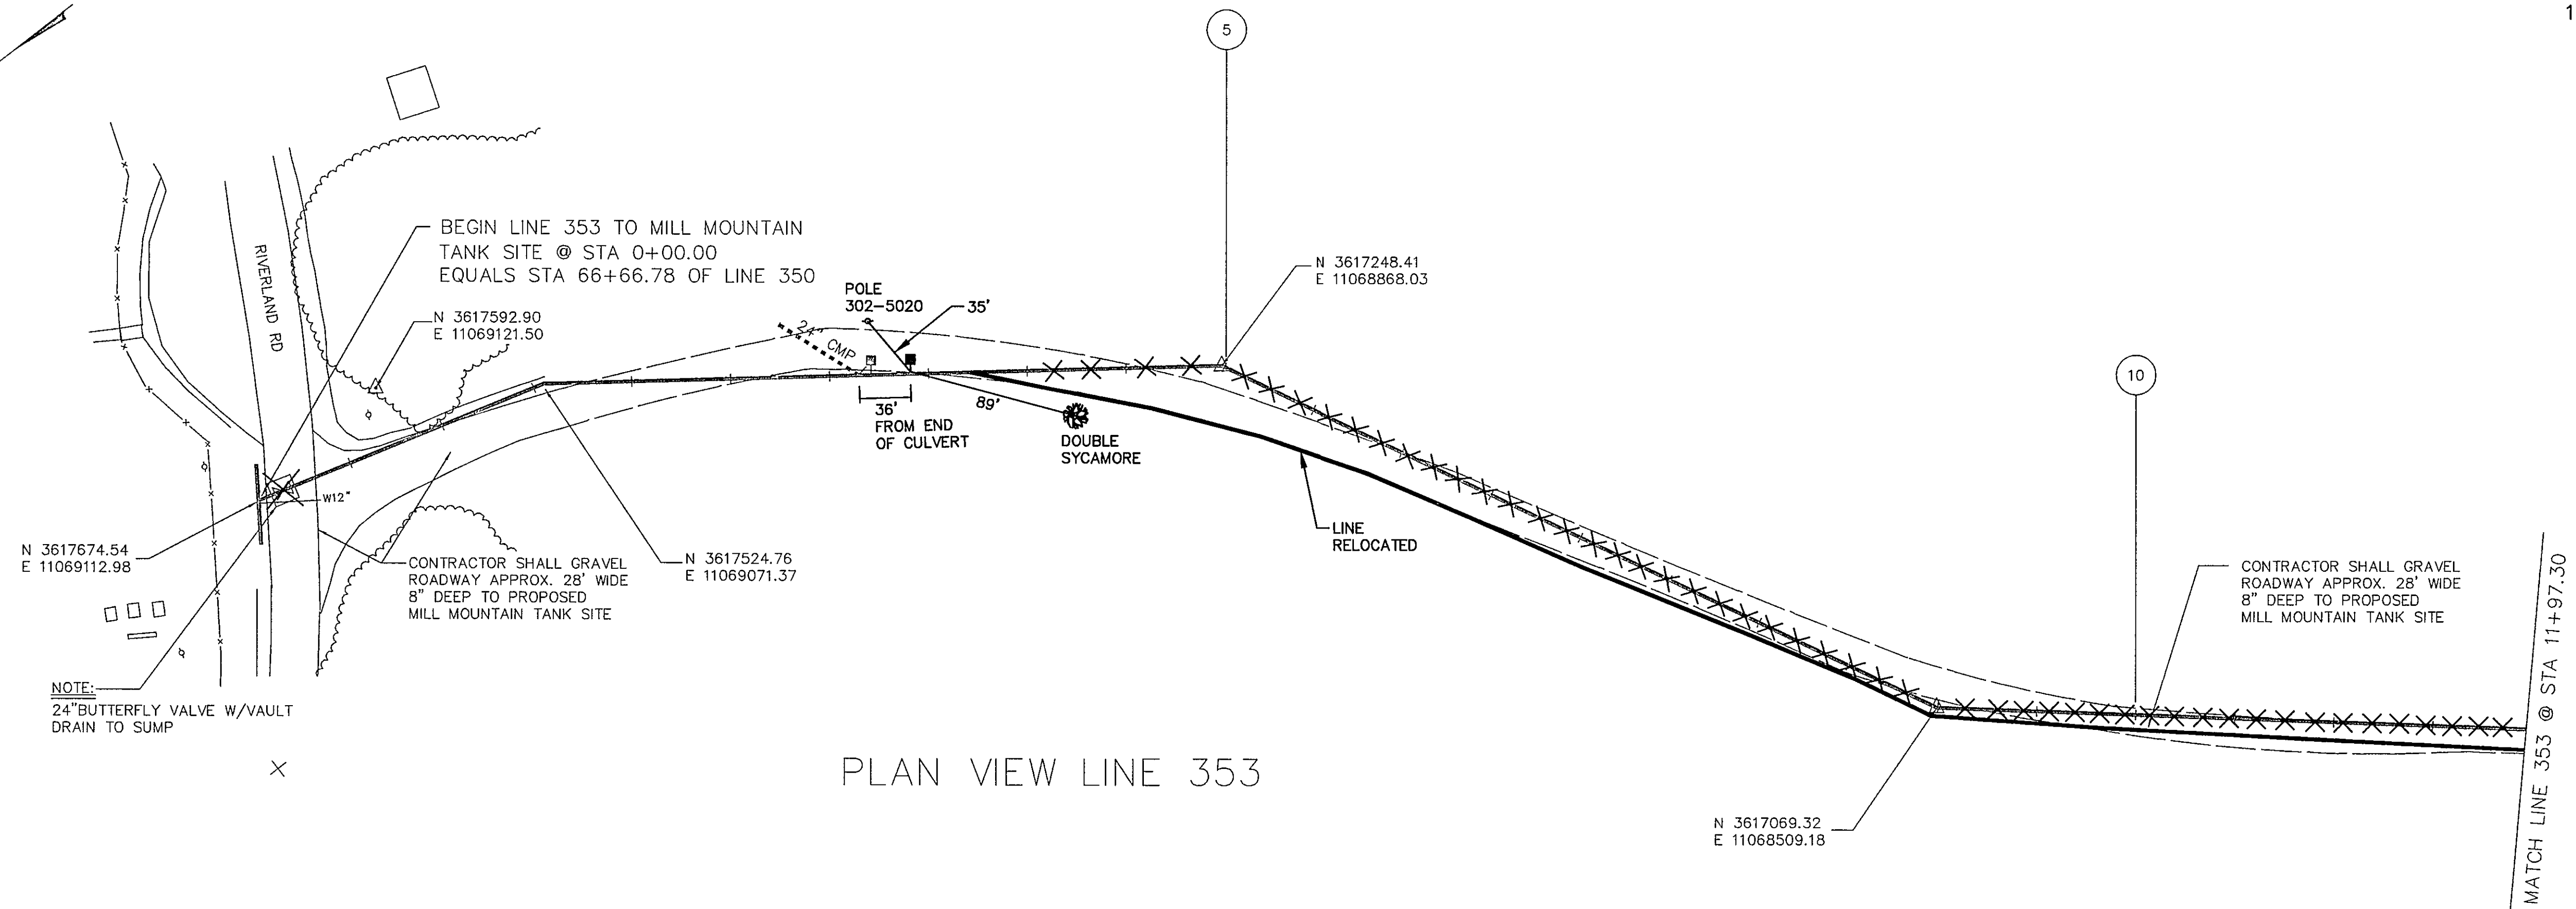

PLAN VIEW LINE 353

COMMONWEALTH OF VIRGINIA
RONALD B. SMITH
16774
ENGINEER'S SEAL

COMMONWEALTH OF VIRGINIA
STEVE E. HVELY
NO. 9580
ENGINEER'S SEAL

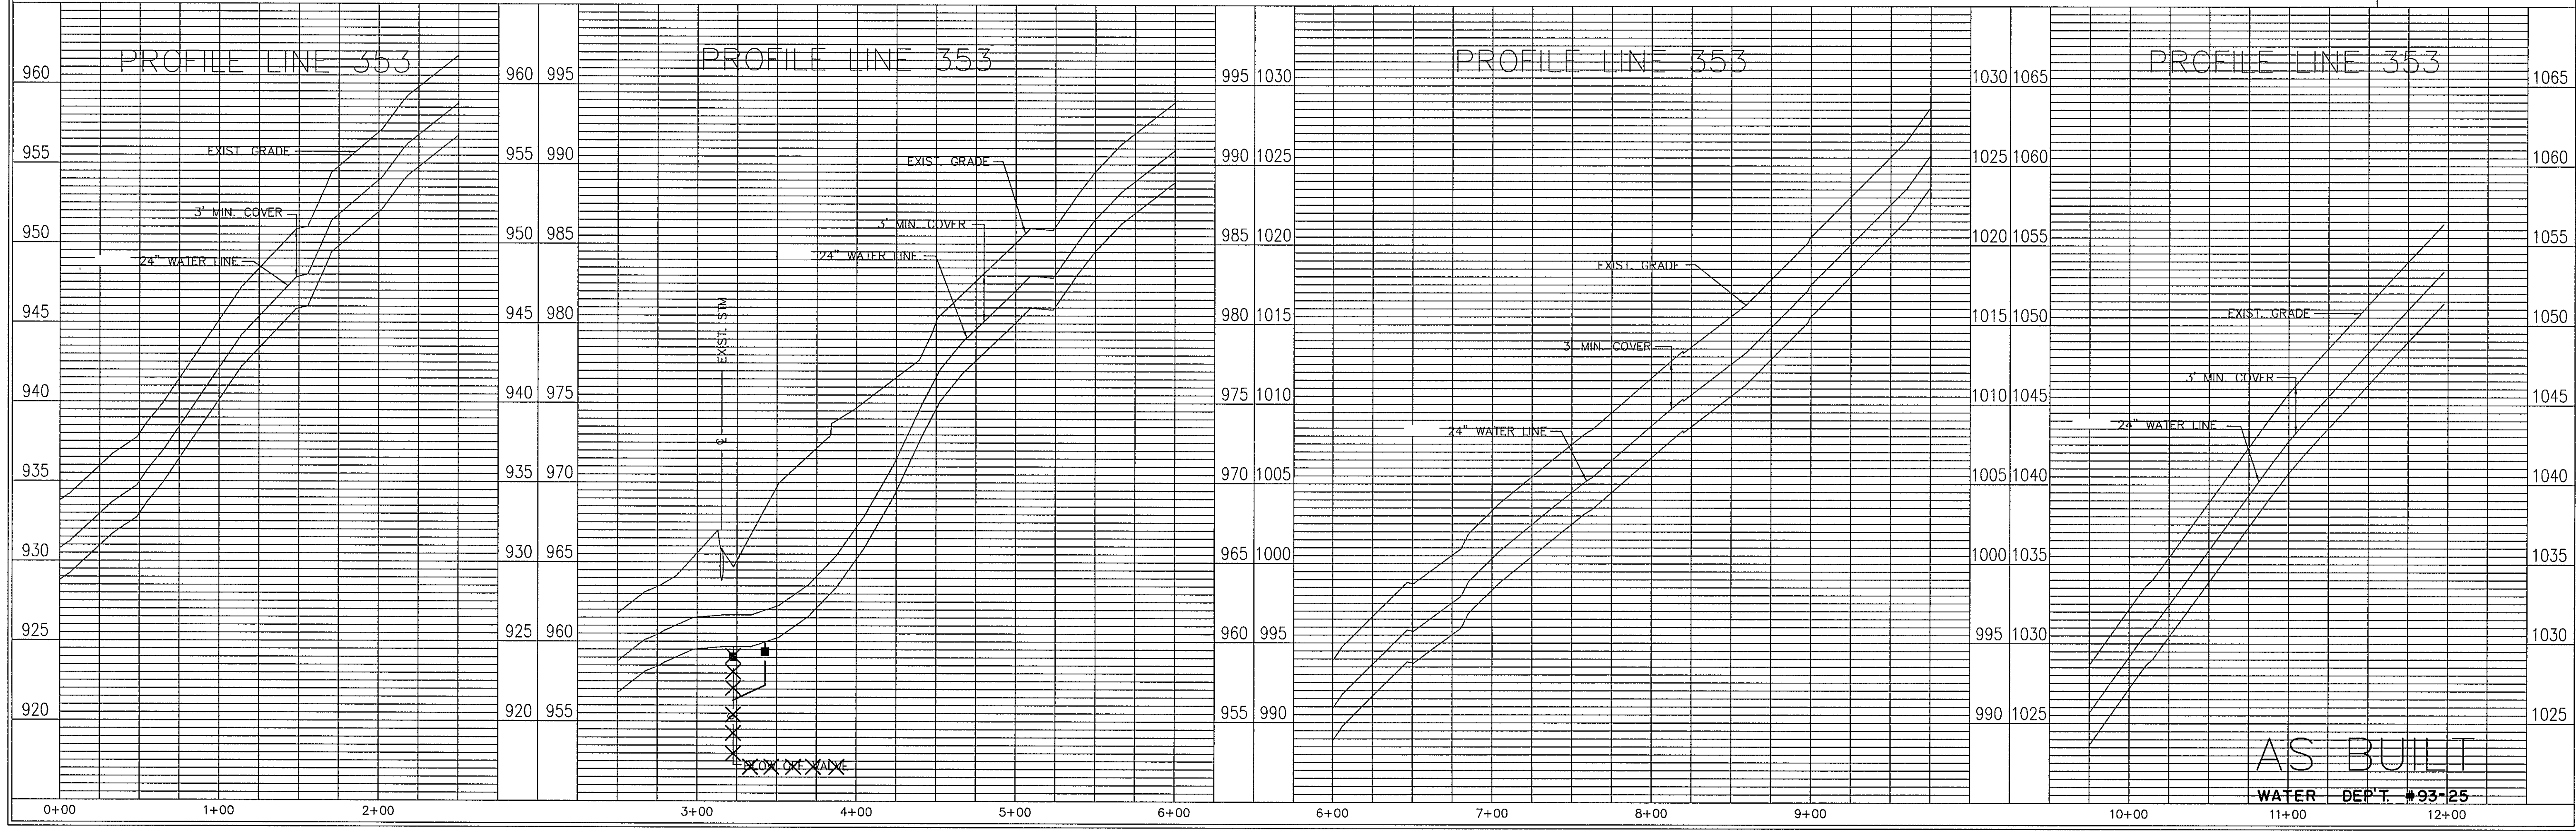

Architects
Engineers
Planners
Surveyors

Dewberry & Davis
5238 Valleypointe Parkway, Suite One-B
Roanoke, Virginia 24019
703 362-7725

Carvins Cove, Phase II
City of Roanoke
Roanoke, Virginia

CONTRACT "C2"
BEGIN LINE 353
MILL MOUNTAIN TANK
STA 0+00.00 - 11+97.30

Drawn By REH/ACF
Designed By RBS
Checked By SEH
Date MARCH 93
Scale V: 1" = 5'
H: 1" = 50'
Plan Number MMTS1
Zoned NONE
Sheet 17 of 25
File Number C1160