



TANK ELEVATION DETAIL
NTS

AS BUILT

WATER DEP'T. #93-25

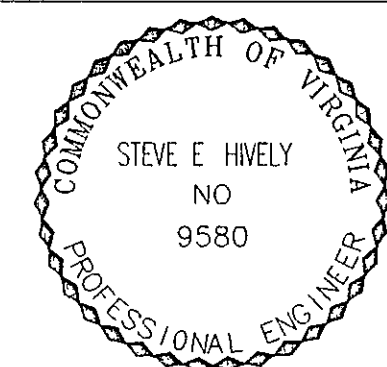

ENGINEER'S SEAL

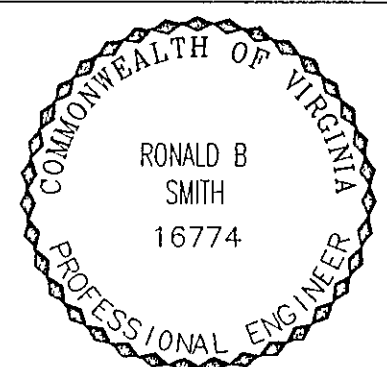


ENGINEER'S SEAL

CONTRACT "C2"
MOUNT PLEASANT
ELEVATED STORAGE TANK
DETAILS

Drawn By	ACF
Designed By	RBS
Checked By	SEH
Date	MARCH 93
Scale	AS NOTED
Plan Number	C2DTRWL4
Zoned	NONE
Sheet	21 of 25
File Number	C1160

Carvins Cove, Phase II
City of Roanoke
Roanoke, Virginia

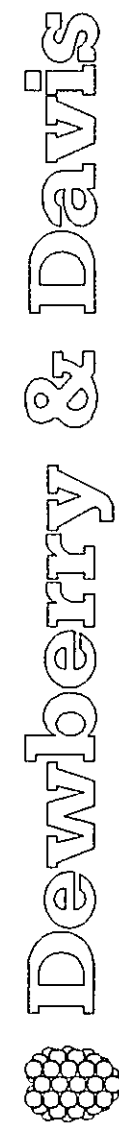

Architects
Engineers
Planners
Surveyors
5238 Valleypointe Parkway, Suite One-B
Roanoke, Virginia 24019
☎ 703 362-7726