


NOTICE:
The location of features and utilities are shown on this map in so far as their existence and location were known at the time of the preparation of this map. Nothing on this map shall be construed as a guarantee that any feature or utility are in the location indicated or that they actually exist.

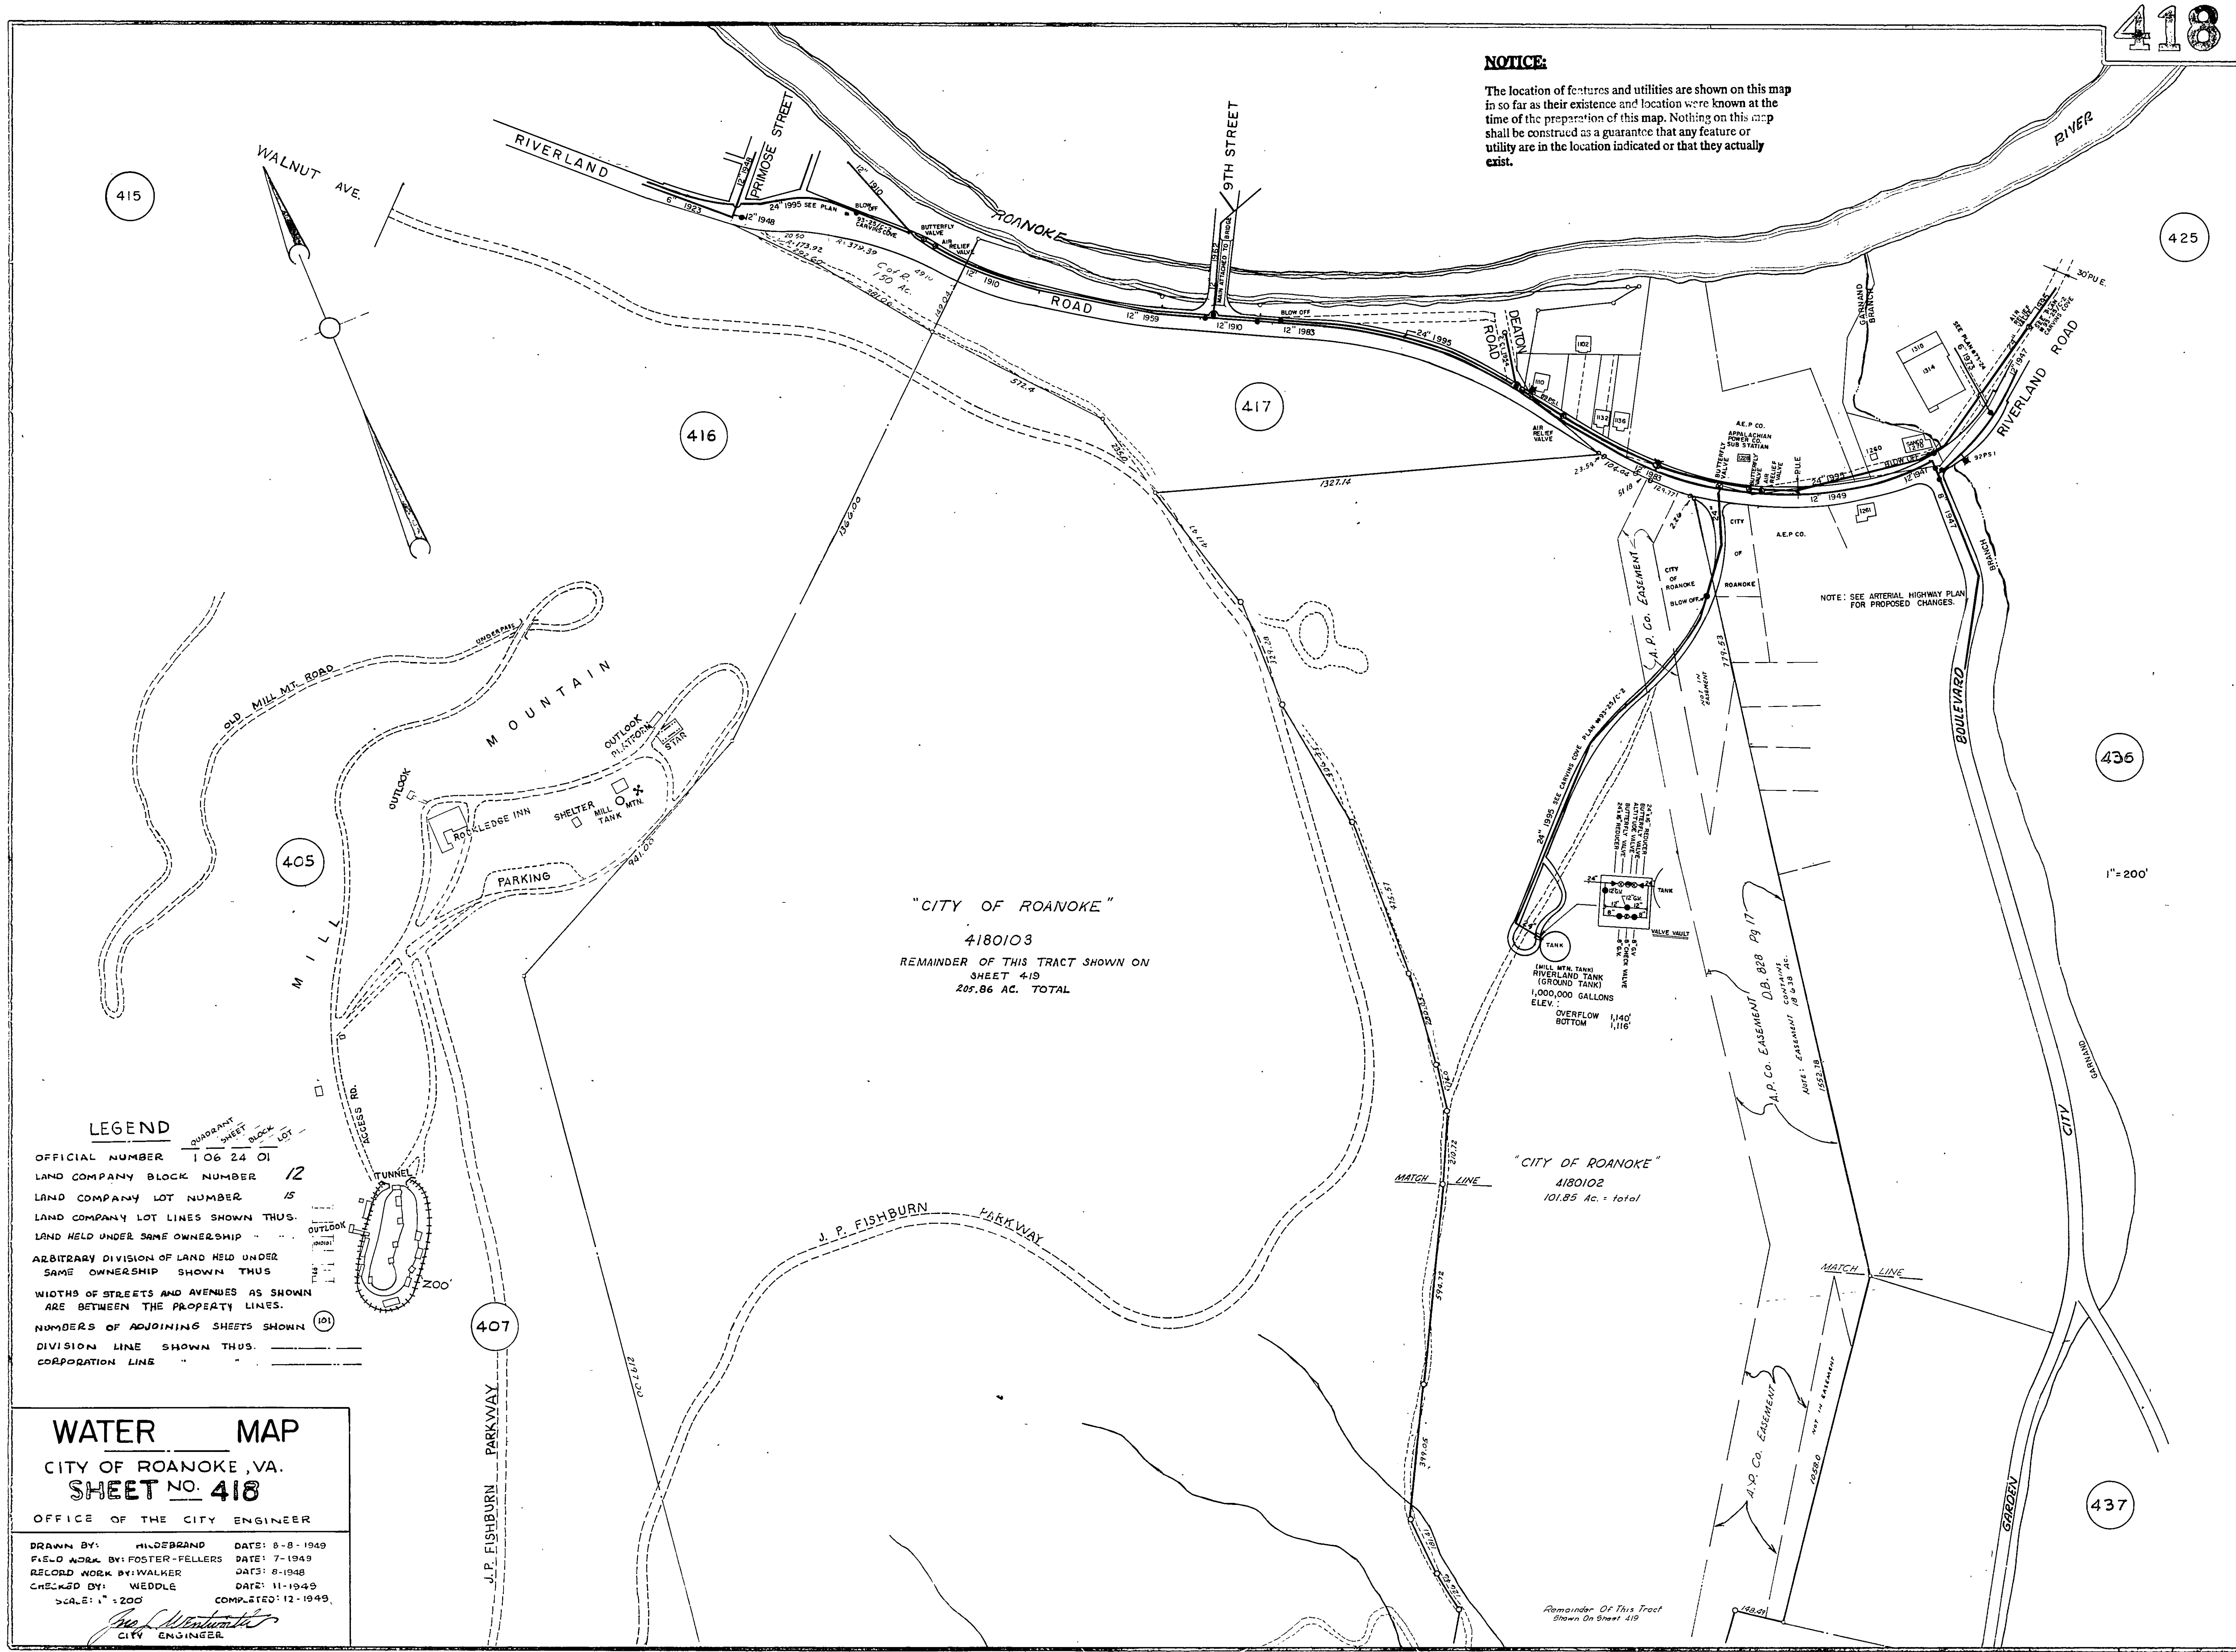

LEGEND

SYMBOL	DESCRIPTION
QUADRANT	106 24 01
SHEET	12
BLOCK	15
LOT	15
LAND COMPANY BLOCK NUMBER	12
LAND COMPANY LOT NUMBER	15
LAND COMPANY LOT LINES SHOWN THUS	---
LAND HELD UNDER SAME OWNERSHIP	---
ARBITRARY DIVISION OF LAND HELD UNDER SAME OWNERSHIP SHOWN THUS	---
WIDTHS OF STREETS AND AVENUES AS SHOWN ARE BETWEEN THE PROPERTY LINES.	---
NUMBERS OF ADJOINING SHEETS SHOWN	(101)
DIVISION LINE SHOWN THUS	---
CORPORATION LINE	---

WATER MAP
CITY OF ROANOKE, VA.
SHEET NO. 418
OFFICE OF THE CITY ENGINEER

DRAWN BY: HINDEBRAND DATE: 8-8-1949
FIELD WORK BY: FOSTER-FELLERS DATE: 7-1949
RECORD WORK BY: WALKER DATE: 8-1949
CHECKED BY: WEDDLE DATE: 11-1949
SCALE: 1" = 200' COMPLETED: 12-1949

John L. Henderson
CITY ENGINEER

"CITY OF ROANOKE"
4180103
REMAINDER OF THIS TRACT SHOWN ON
SHEET 419
205.86 AC. TOTAL

"CITY OF ROANOKE"
4180102
101.85 AC. = total

NOTE: SEE ARTERIAL HIGHWAY PLAN FOR PROPOSED CHANGES.

NOTE: EASEMENT CONTAINS 18 5/8 AC.

Remainder Of This Tract Shown On Sheet 419