


PLAN	SURVEYED	DATE
	NOTED	DATE
	NOTED	DATE

PROFILE	DATE
	DATE
	DATE

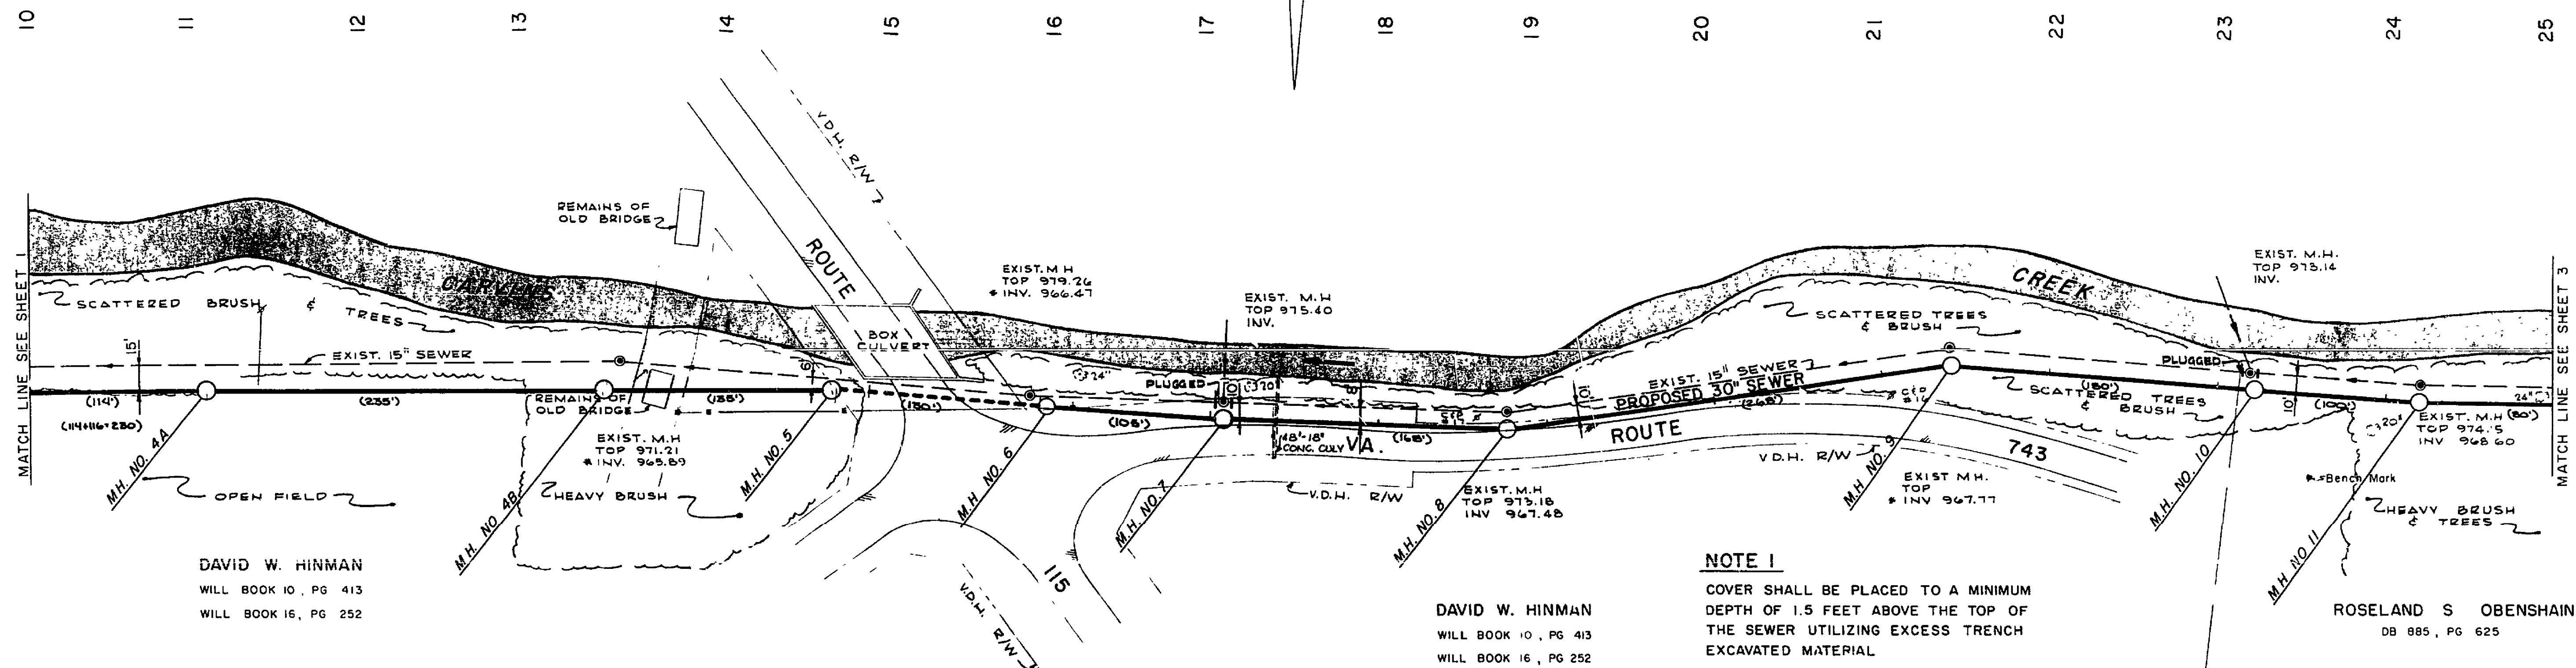



DAVID W. HINMAN
WILL BOOK 10, PG 413
WILL BOOK 16, PG 252

DAVID W. HINMAN
WILL BOOK 10, PG 413
WILL BOOK 16, PG 252

NOTE 1
COVER SHALL BE PLACED TO A MINIMUM
DEPTH OF 1.5 FEET ABOVE THE TOP OF
THE SEWER UTILIZING EXCESS TRENCH
EXCAVATED MATERIAL.

ROSELAND S OBENSHAIN
DB 885, PG 625

AS BUILT

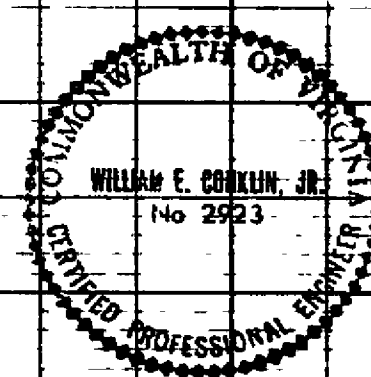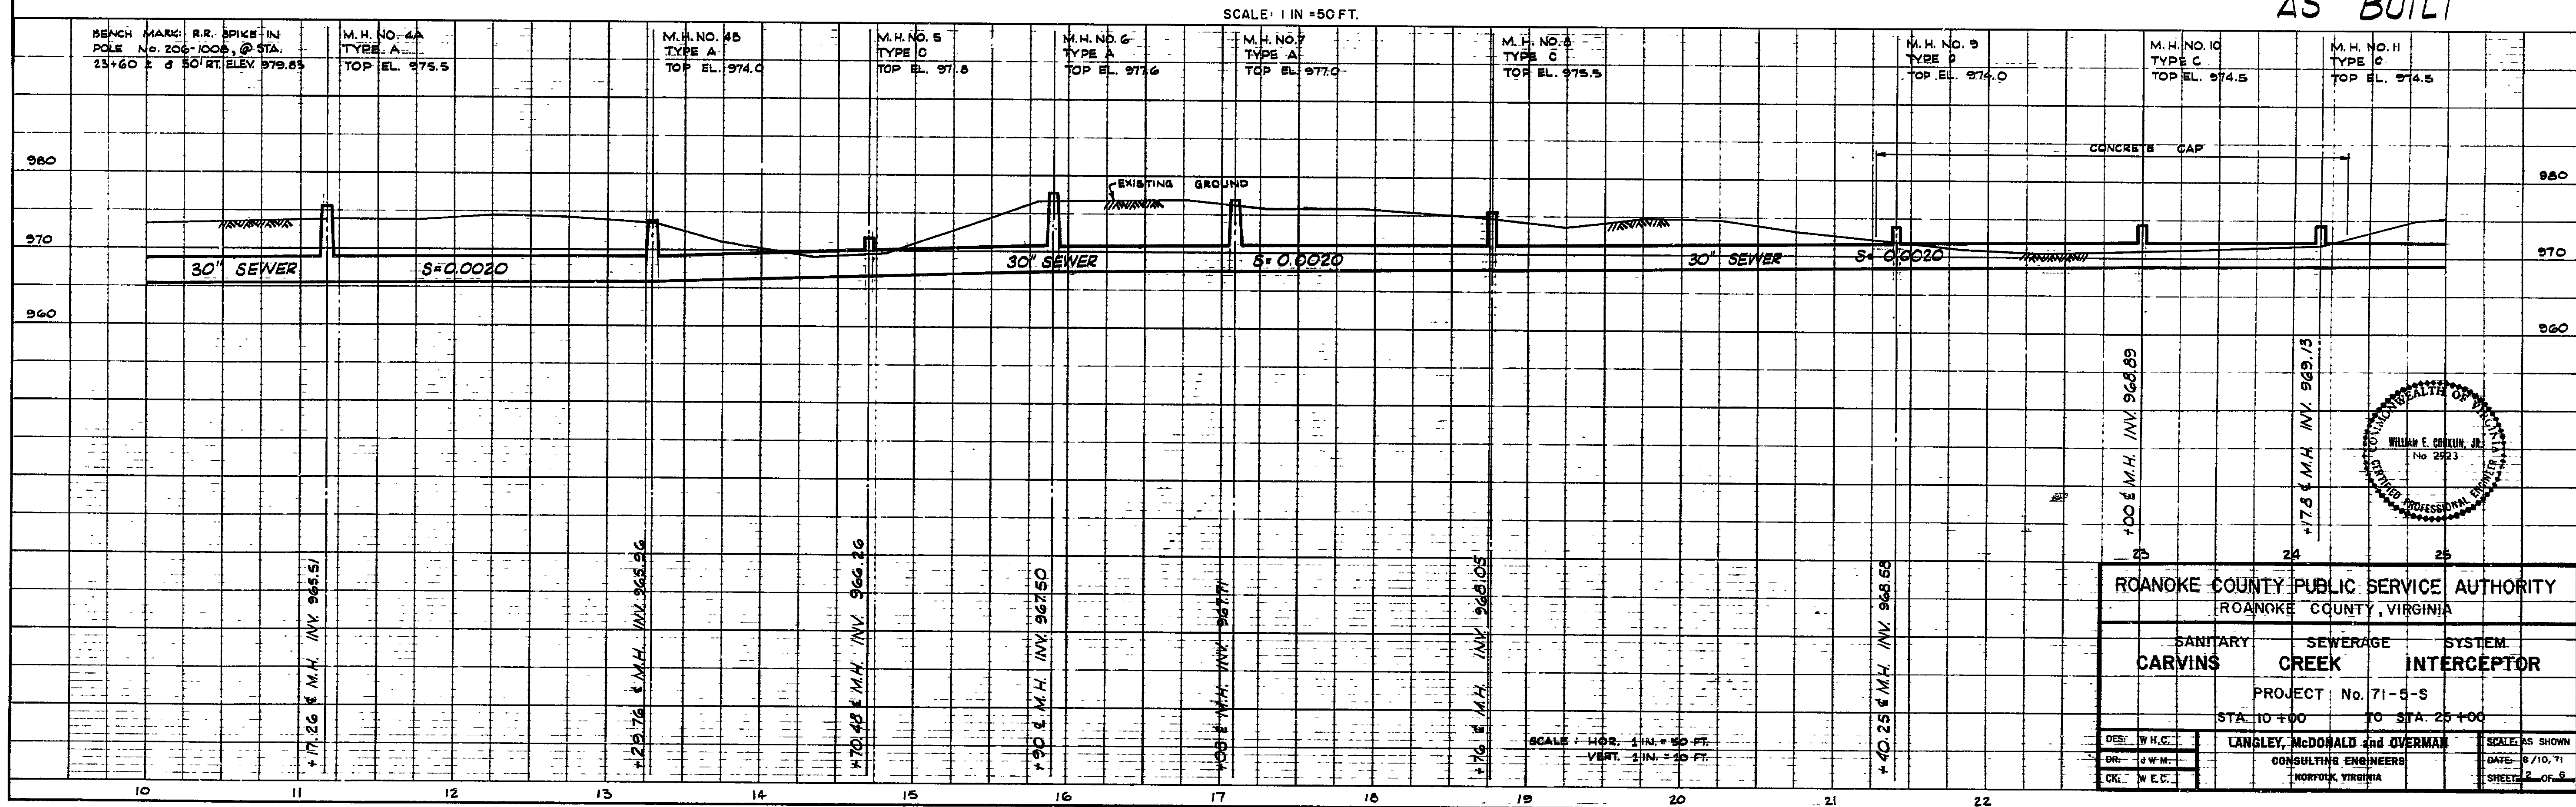

ROANOKE COUNTY PUBLIC SERVICE AUTHORITY ROANOKE COUNTY, VIRGINIA		
SANITARY CARVINS	SEWERAGE CREEK	SYSTEM INTERCEPTOR
PROJECT No. 71-5-S		
STA. 10+00 TO STA. 25+00		
DES: W.H.C.	LANGLEY, McDONALD and OVERMAN CONSULTING ENGINEERS NORFOLK, VIRGINIA	
DR: J.W.M.	DATE: 8/10/71	
CK: W.E.C.	SHEET: 2 OF 6	

K&E PLATE 1, PLAN-PROFILE
48 7008 MADE IN U.S.A.

SI-0314