

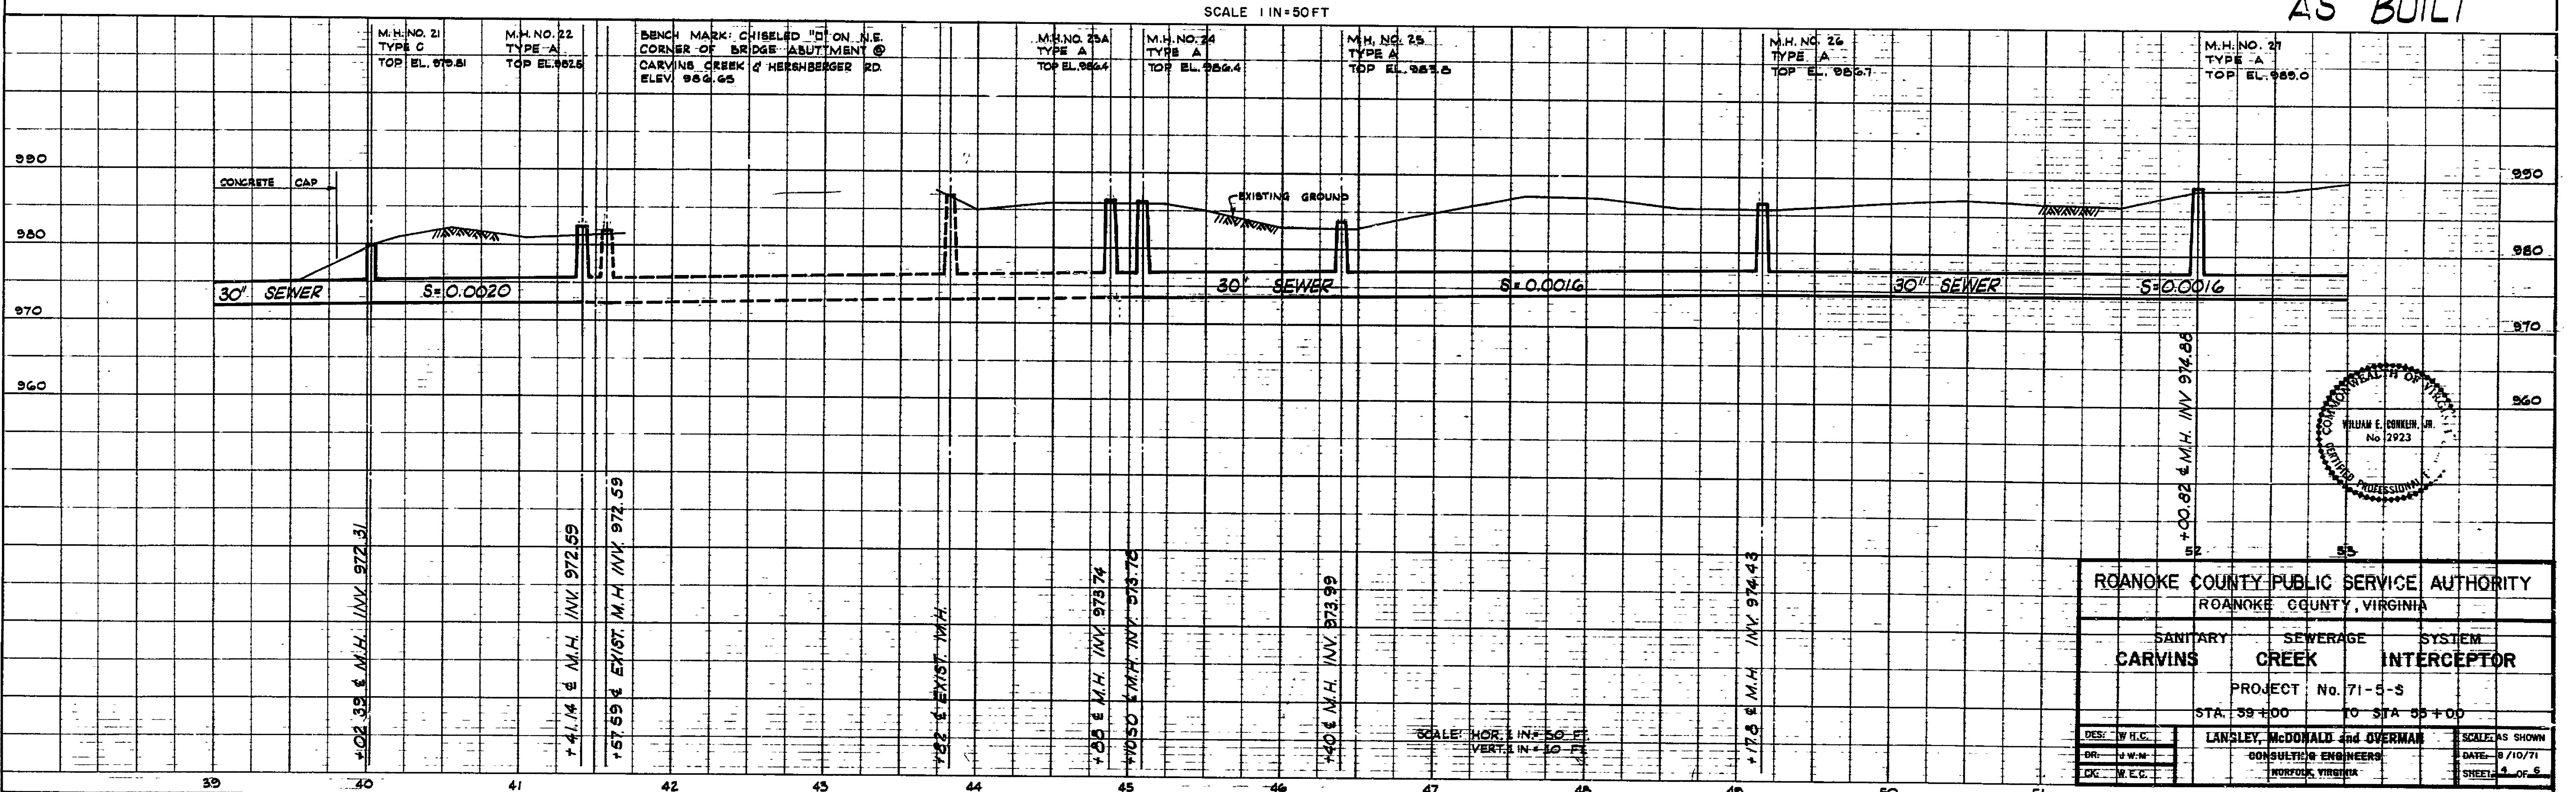


PLAN	DATE	
	BY	
	CHECKED	
	NOTED	

PROFILE	DATE	
	BY	
	CHECKED	
	NOTED	

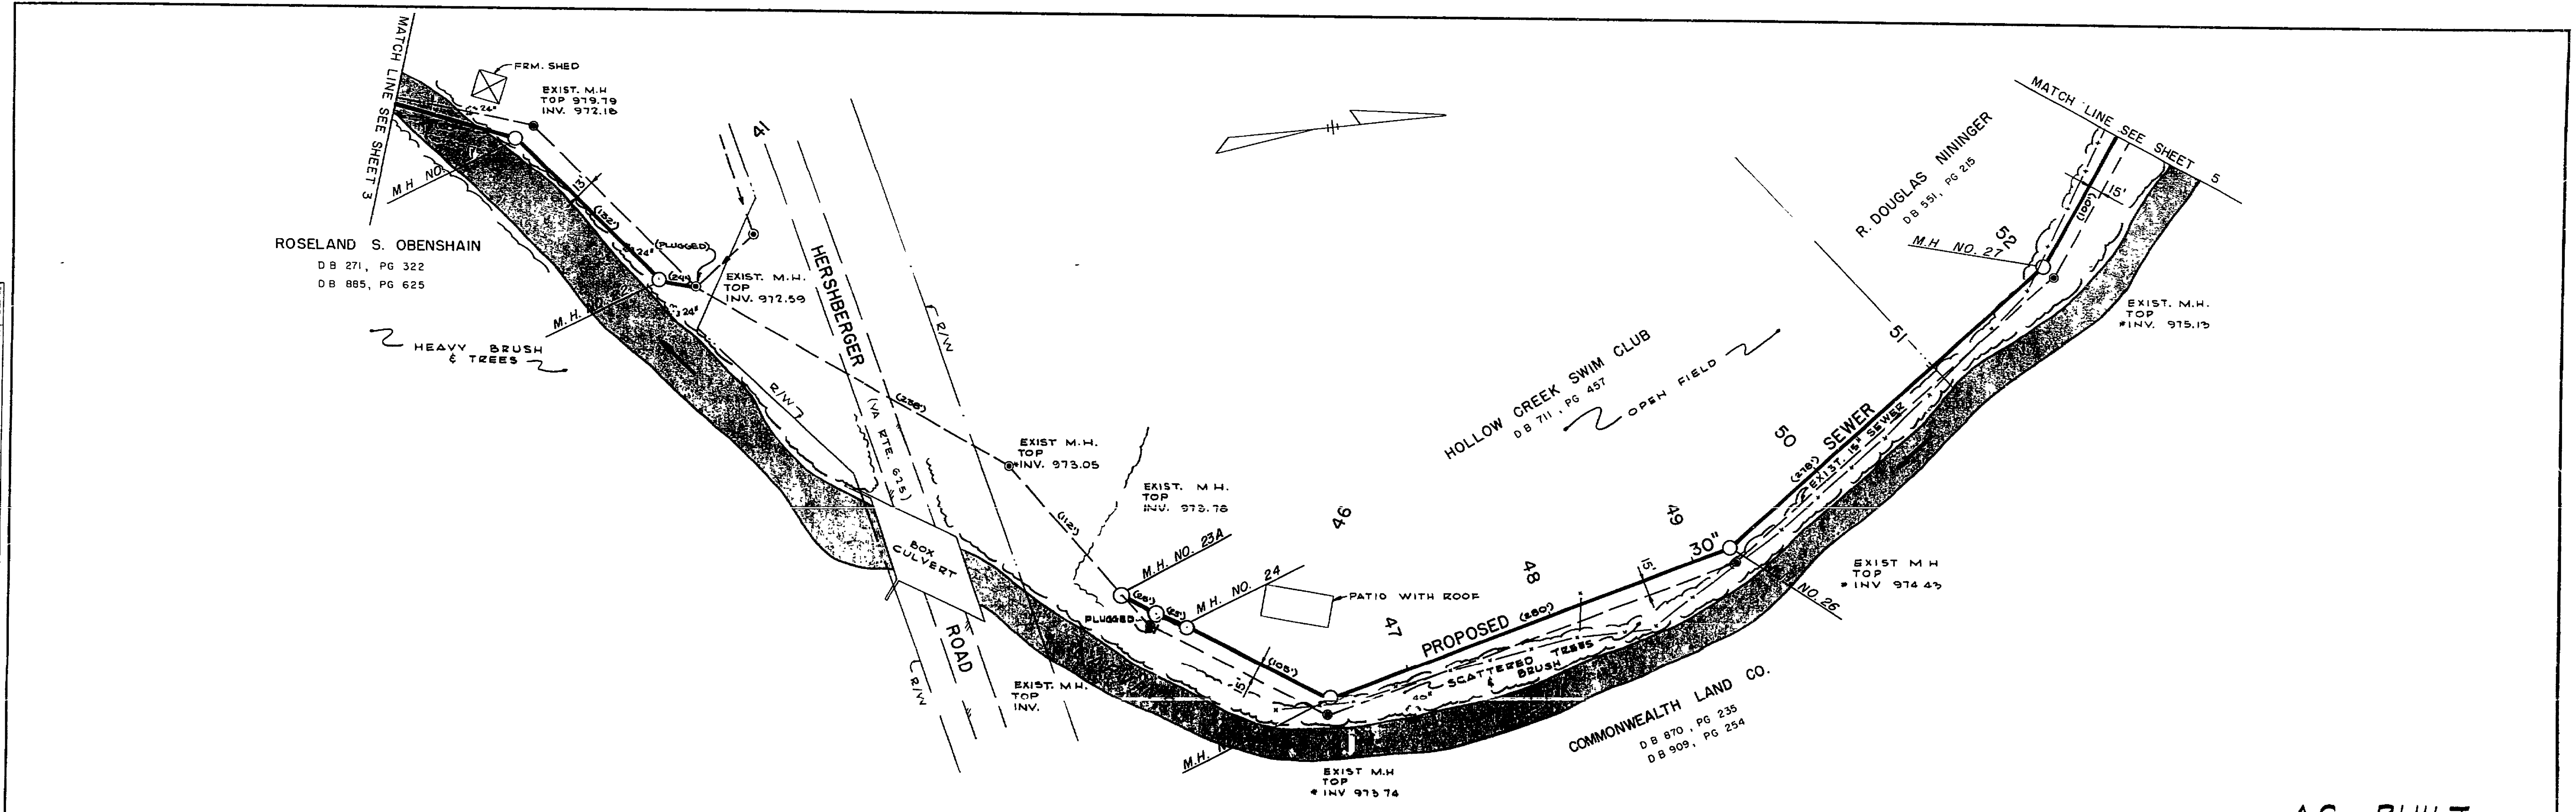

AS BUILT

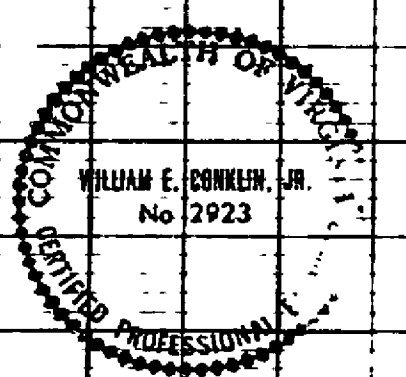

ROANOKE COUNTY PUBLIC SERVICE AUTHORITY		
ROANOKE COUNTY, VIRGINIA		
SANITARY	SEWERAGE	SYSTEM
CARVINS	CREEK	INTERCEPTOR
PROJECT No. 71-5-S		
STA. 39+00 TO STA. 51+00		
DES: W.E.G.	LANGLEY, McDONALD and OVERMAN	
DR: J.W.M.	CONSULTING ENGINEERS	
CHK: W.E.G.	ROANOKE, VIRGINIA	
DATE: 8/10/71		SHEET: 4 OF 5

PLATE 1, PLAN-PROFILE
48 7008 MADE IN U.S.A.

SI-0316

