


ROANOKE COUNTY

NOKE COUNTY, VIRGINIA

PROJECT NO. 71-6-S

L.S.	WALDROP		CHAIRMAN
F.R.	ANGELL	VICE	CHAIRMAN
H.F.	REED		
R.H.	RICHARDSON		
B.W.	MAHONEY		

J.A. BEAVERS EXECUTIVE DIRECTOR

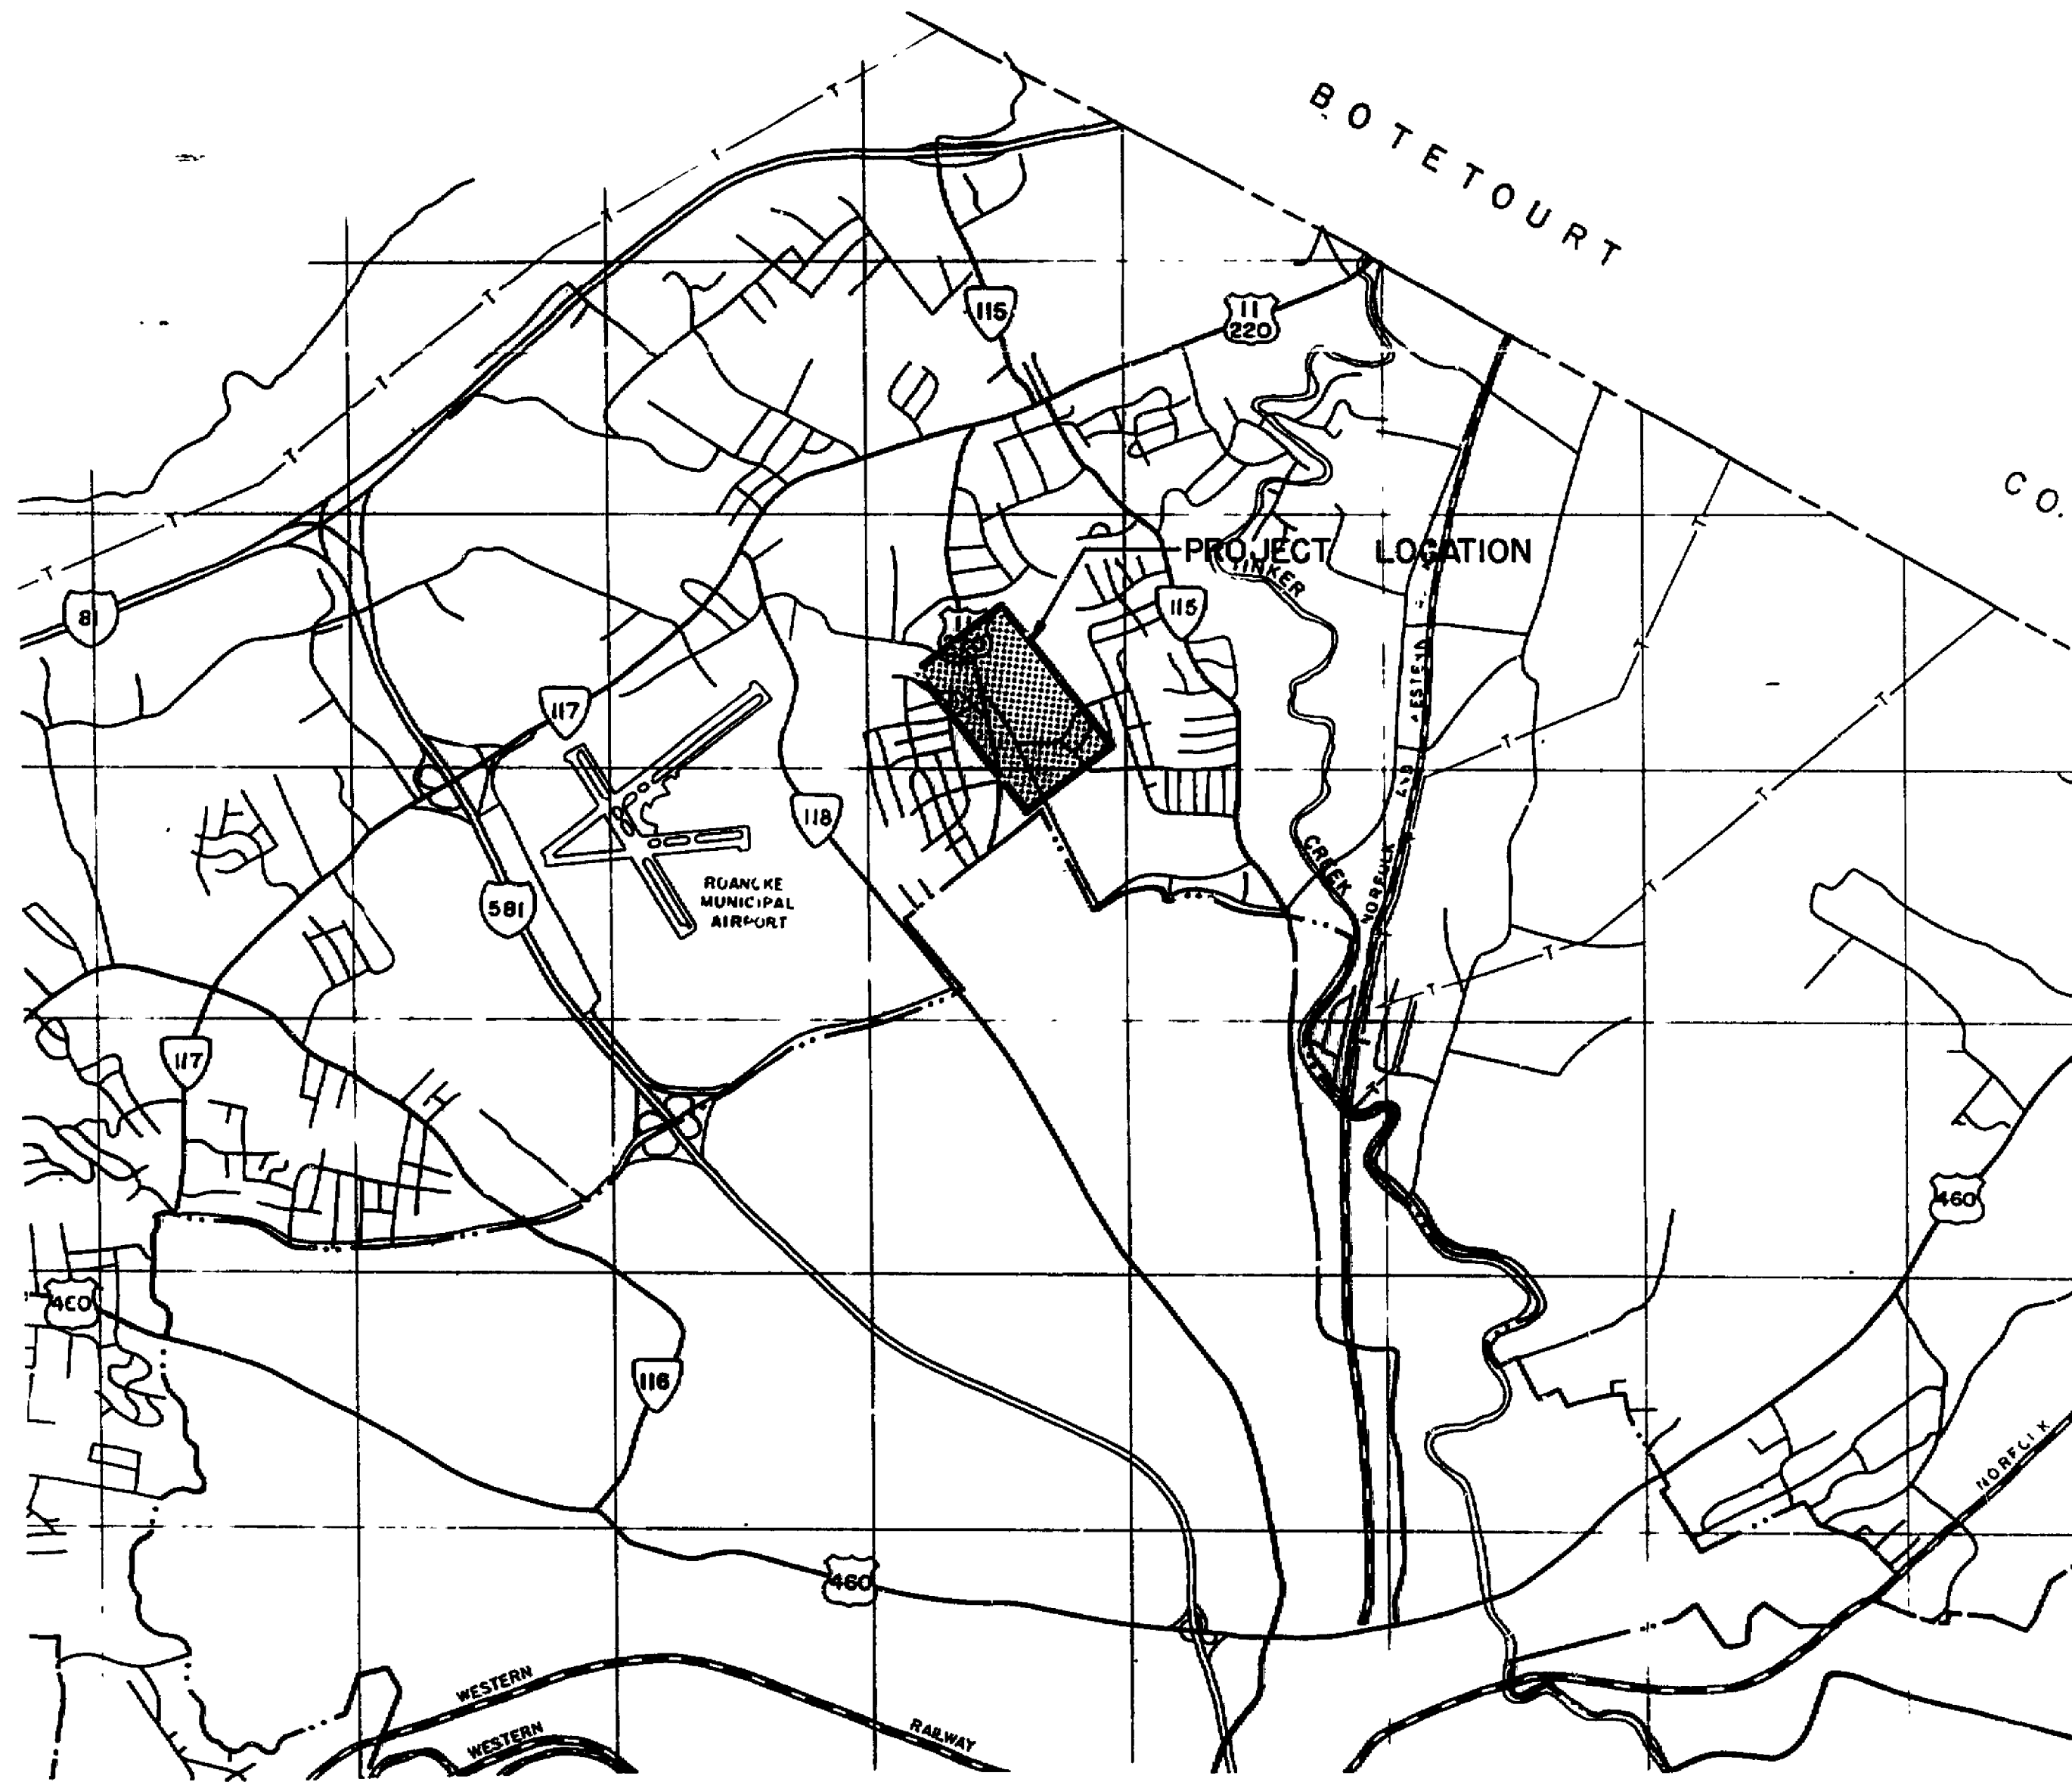[illegible]

SANITARY SEWERAGE SYSTEM

CARVINS CREEK

LEGEND


-  SURVEY BASE LINE
-  PROPERTY LINE
-  RIGHT OF WAY LINE
-  EDGE OF PAVEMENT
-  EXISTING SANITARY SEWER
-  PROPOSED SANITARY SEWER
-  EXISTING MANHOLE
-  PROPOSED MANHOLE
-  PROPOSED CLEANOUT
-  PROPOSED METERING STATION
-  WATER MAIN
-  GAS LINE
-  ELECTRIC CABLE OR CONDUIT
-  TELEPHONE CABLE OR CONDUIT
-  RAILROAD TRACKS
-  DITCH
-  STREAM
-  FENCE
-  FIRE HYDRANT
-  POWER POLE
-  TELEPHONE POLE AND GUY WIRE
-  VALVE VAULT
-  WATER METER
-  TREE
-  SHRUB
-  HEDGE
-  ROCK OR STONE WALL
-  EXISTING GROUND

SCHEDULE OF DRAWINGS

<u>SHEET</u>	<u>TITLE</u>	<u>STATION</u>
1	CARVINS CREEK INTERCEPTOR	9+35 - 21+00
2	CARVINS CREEK INTERCEPTOR	21+00 - 36+00
3	CARVINS CREEK INTERCEPTOR	36+00 - 51+00
4	CARVINS CREEK INTERCEPTOR	51+00 - 59+84
5	DETAILS	

AS BUILT

LANGLEY, Mc DONALD AND OVERMAN
CONSULTING ENGINEERS
NORFOLK, VIRGINIA

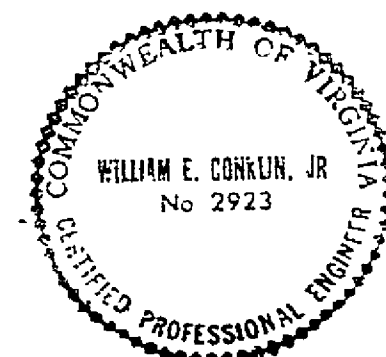

SI-0319. 71-6-S