



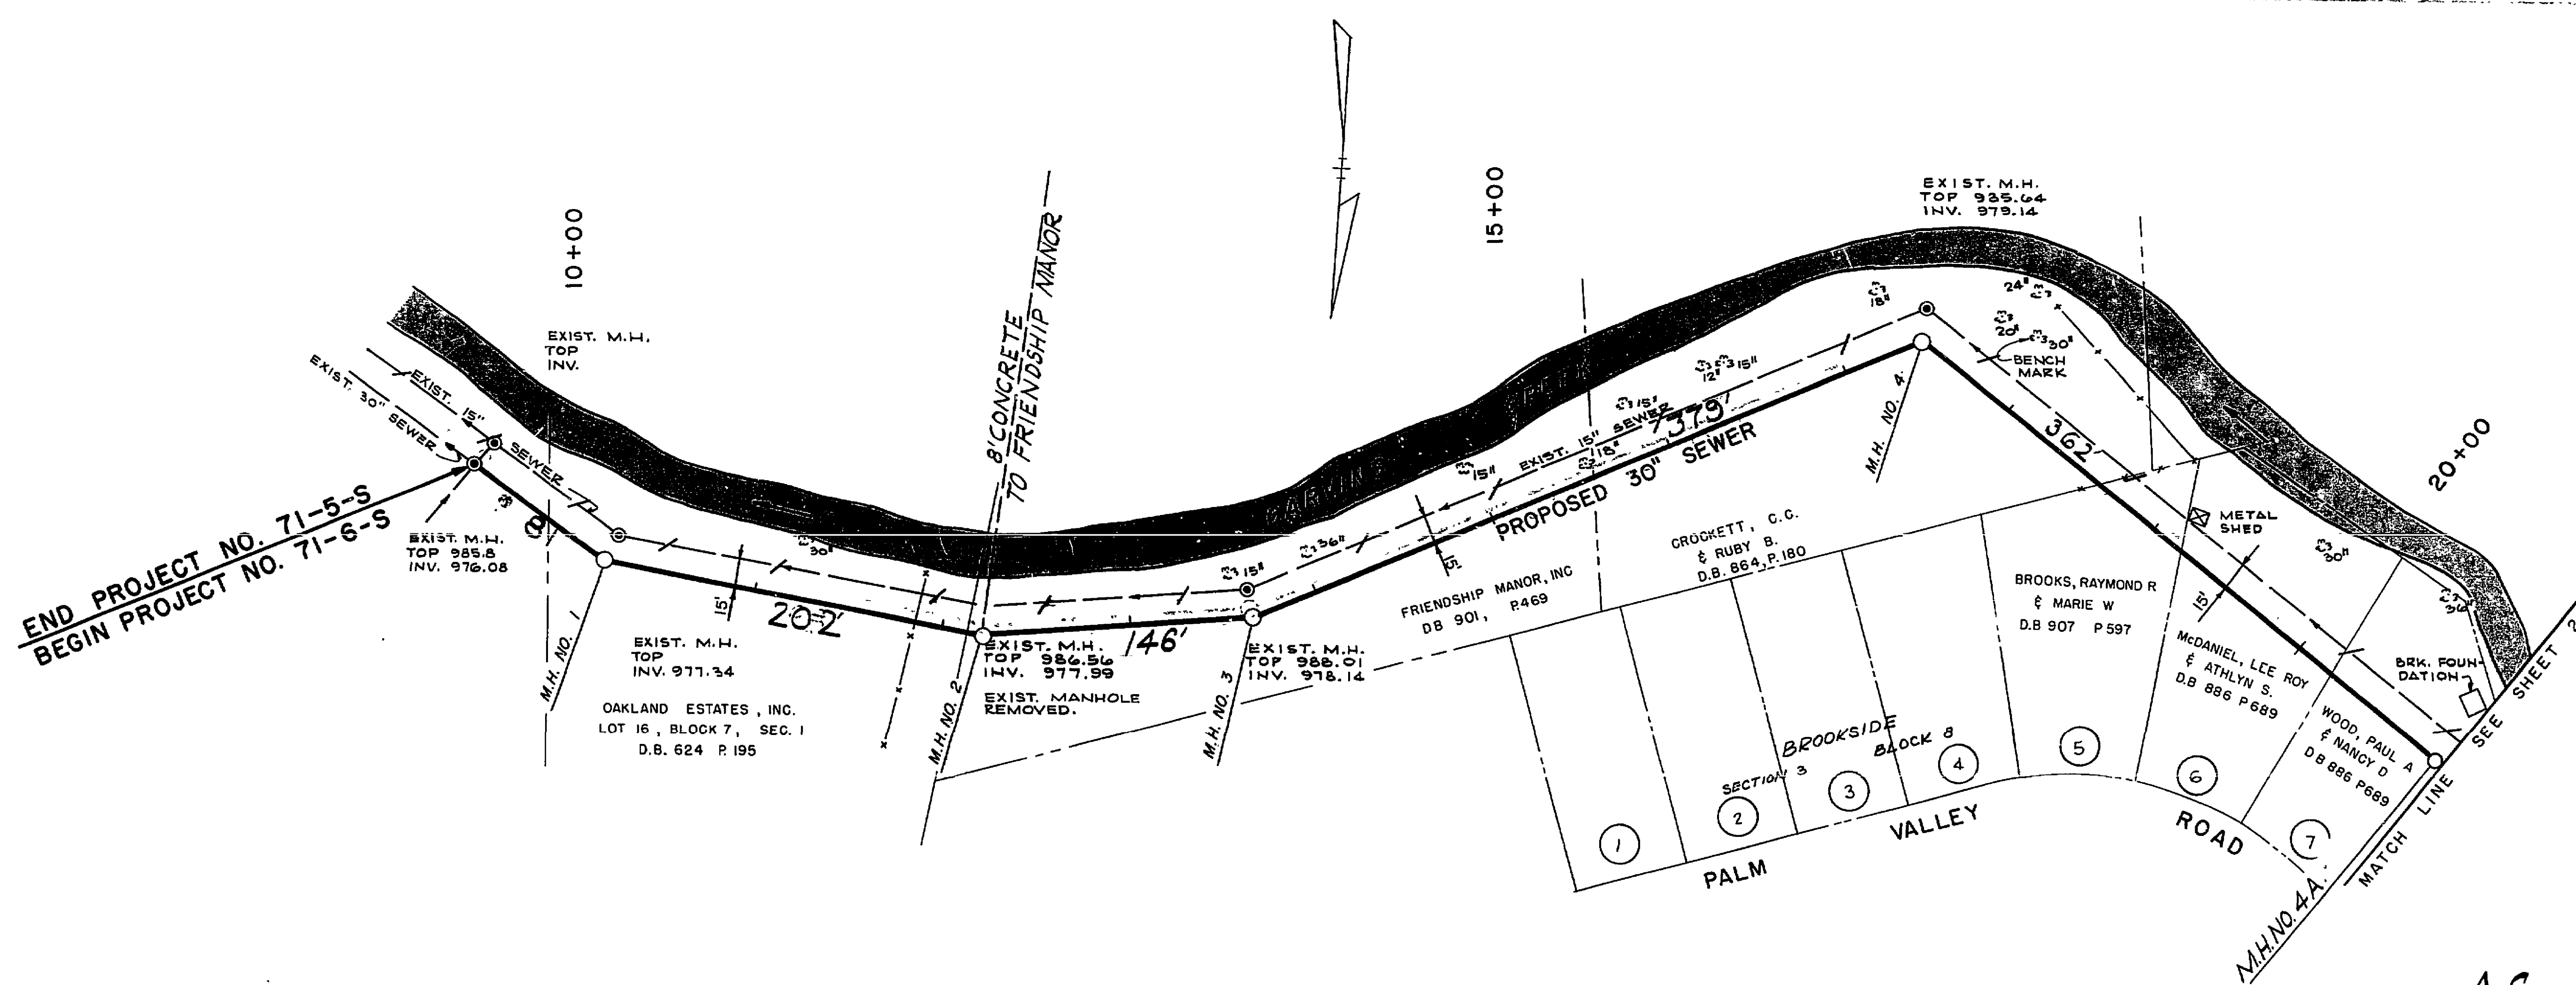

AS BUILT

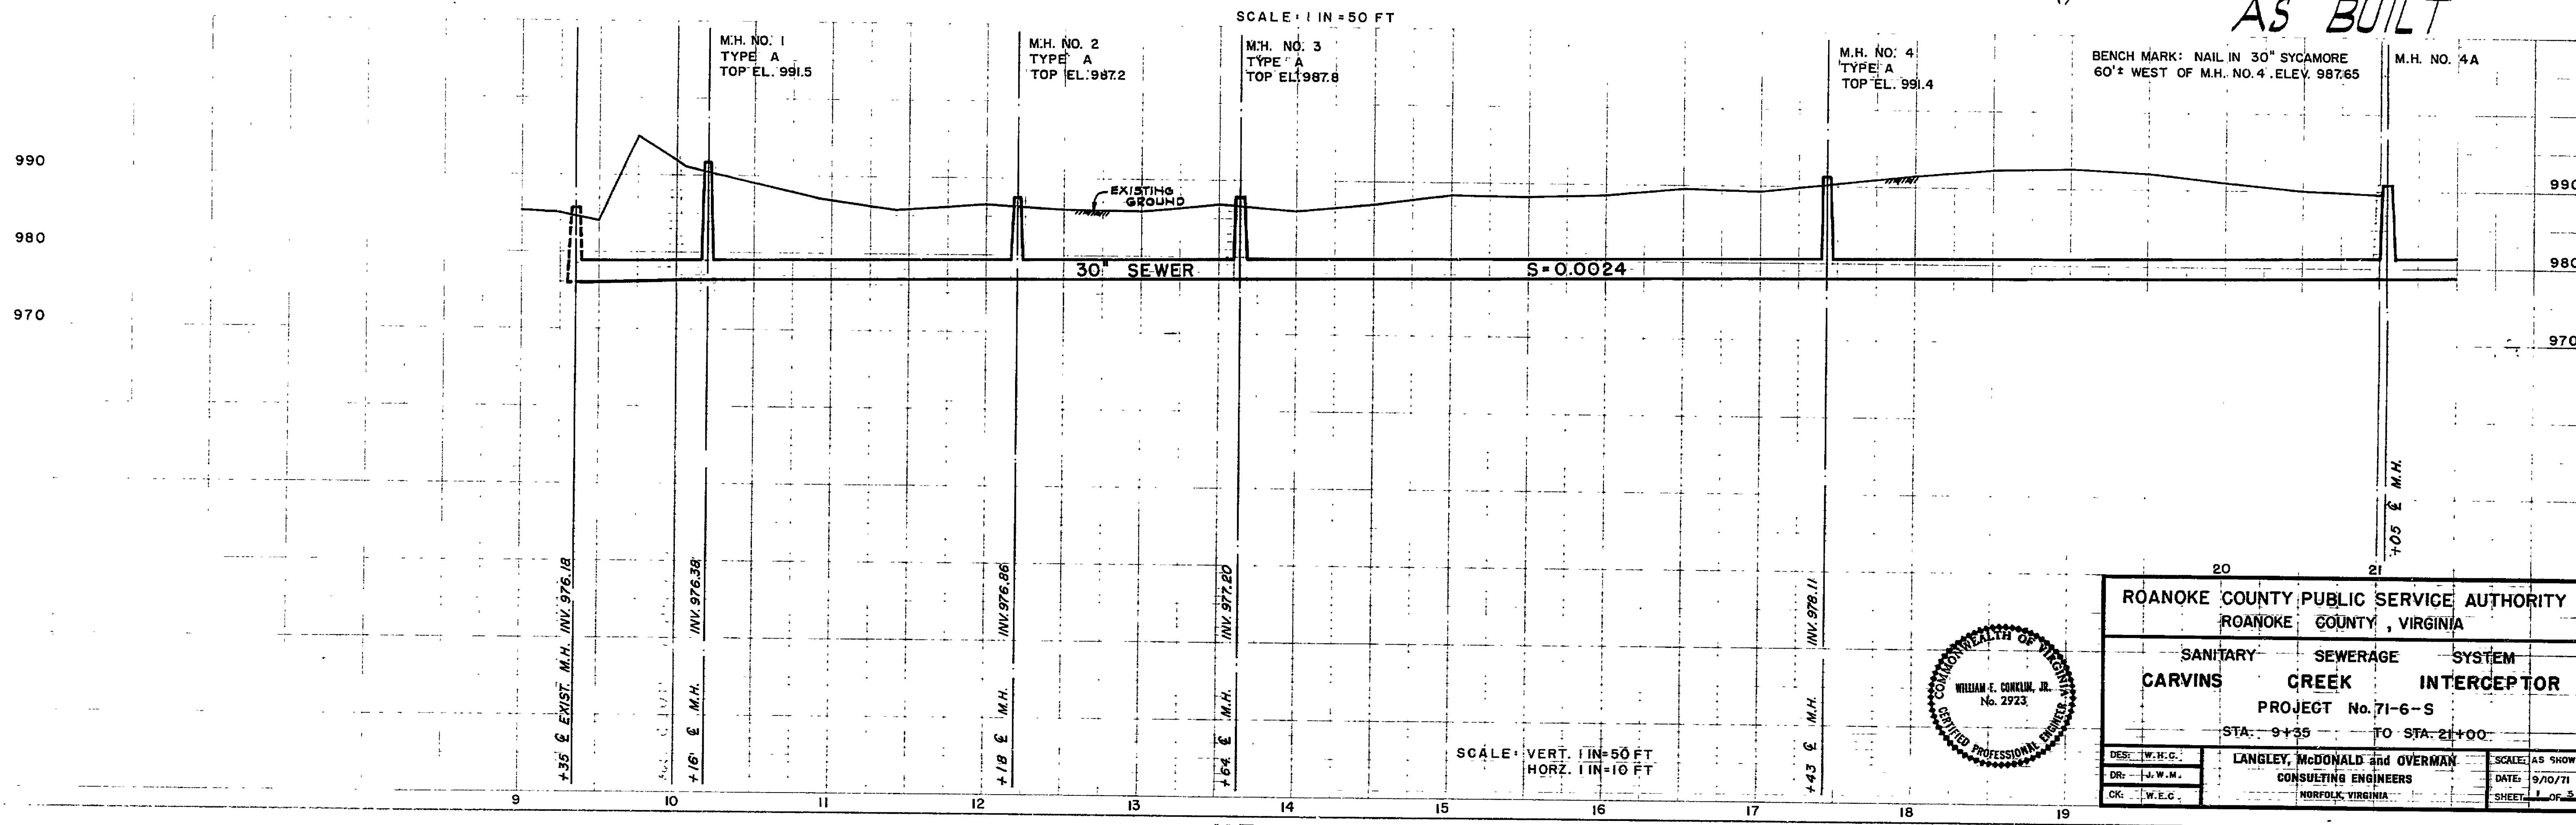

K&E PLATE 1, PLAN-PROFILE
KUTTEL & ESSER CO.
48 7003 ALBANY, N.Y.

SI-03194

34-21

