

ROANOKE COUNTY

PUBLIC SERVICE AUTHORITY


ROANOKE COUNTY, VIRGINIA

PROJECT NO. 71-7-S

AUTHORITY MEMBERS

L.S.	WALDROP		CHAIRMAN
F.R.	ANGELL	VICE	CHAIRMAN
H.F.	REED		
R.H.	RICHARDSON		
B.W.	MAHONEY		

J.A. BEAVERS EXECUTIVE DIRECTOR

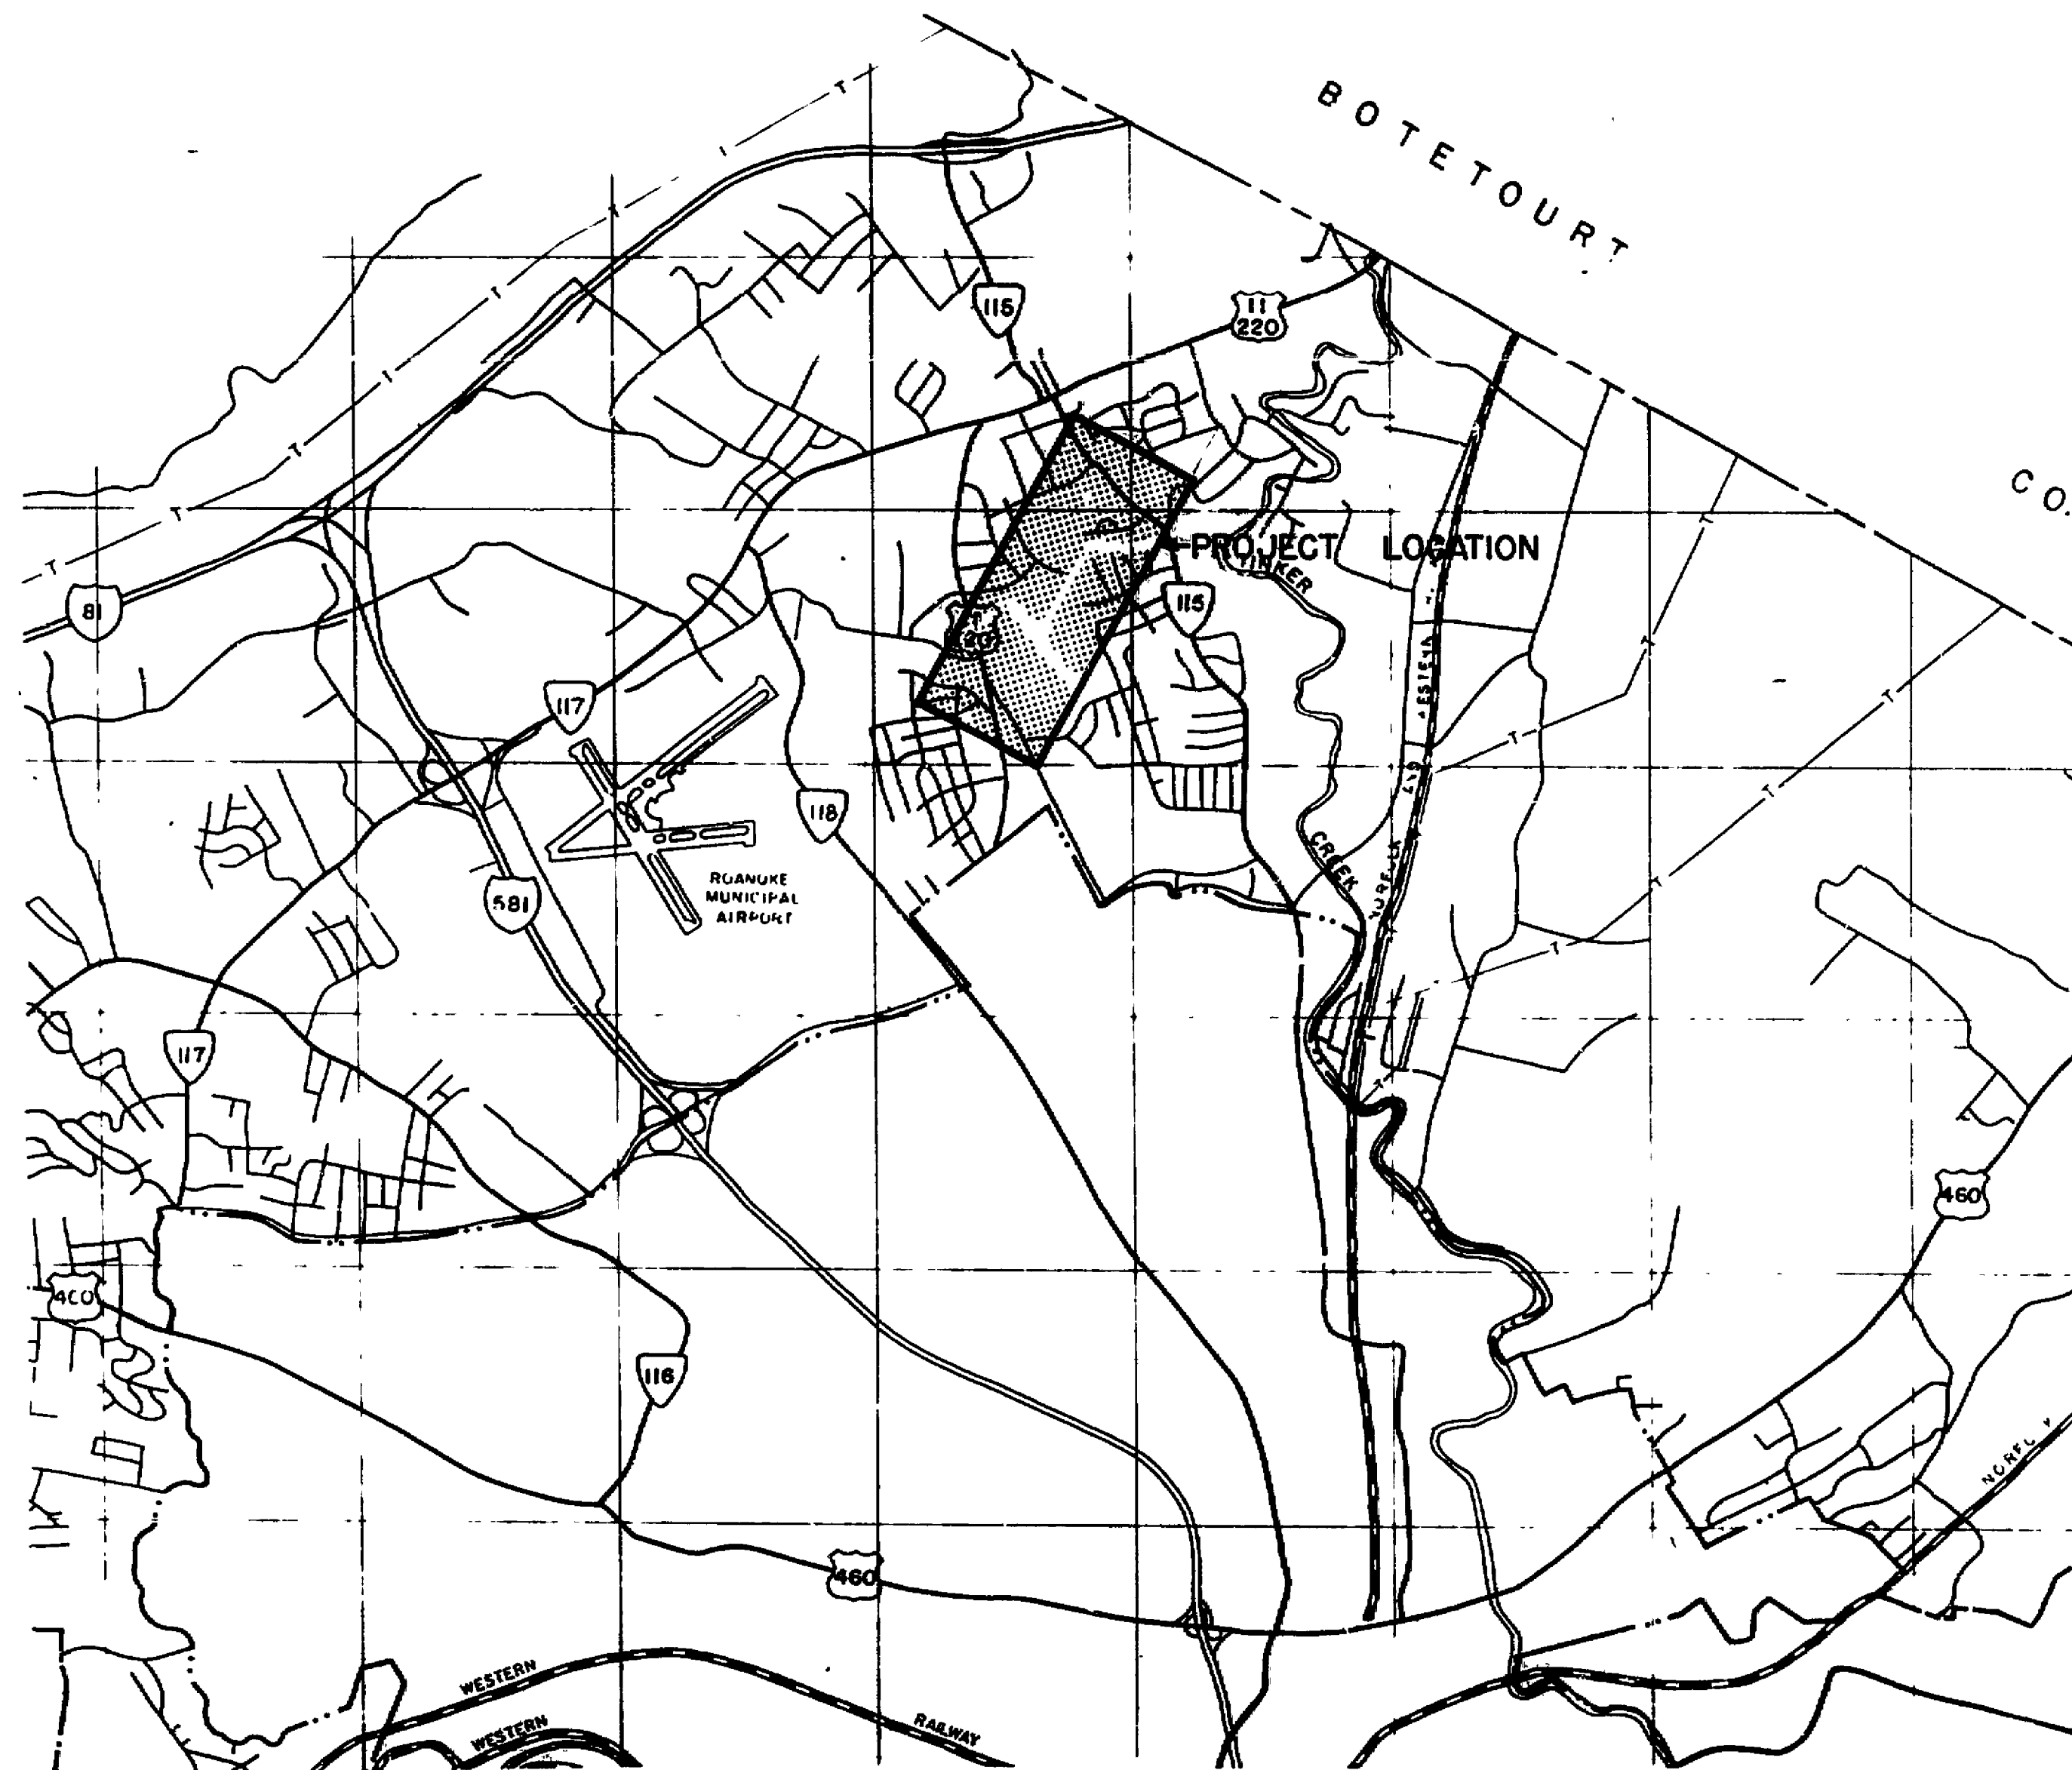

LEGEND

- | | |
|--|-----------------------------|
| | SURVEY BASE LINE |
| | PROPERTY LINE |
| | RIGHT OF WAY LINE |
| | EDGE OF PAVEMENT |
| | EXISTING SANITARY SEWER |
| | PROPOSED SANITARY SEWER |
| | EXISTING MANHOLE |
| | PROPOSED MANHOLE |
| | PROPOSED CLEANOUT |
| | PROPOSED METERING STATION |
| | WATER MAIN |
| | GAS LINE |
| | ELECTRIC CABLE OR CONDUIT |
| | TELEPHONE CABLE OR CONDUIT |
| | RAILROAD TRACKS |
| | DITCH |
| | STREAM |
| | FENCE |
| | FIRE HYDRANT |
| | POWER POLE |
| | TELEPHONE POLE AND GUY WIRE |
| | VALVE VAULT |
| | WATER METER |
| | TREE |
| | SHRUB |
| | HEDGE |
| | ROCK OR STONE WALL |
| | EXISTING GROUND |

SCHEDULE OF DRAWINGS

<u>SHEET</u>	<u>TITLE</u>	<u>STATION</u>
1	CARVINS CREEK INTERCEPTOR	0+86 - 12+00
2	CARVINS CREEK INTERCEPTOR	12+00 - 26+00
3	CARVINS CREEK INTERCEPTOR	26+00 - 40+00
4	CARVINS CREEK INTERCEPTOR	40+00 - 45+43
5	DETAILS	

SUMMARY OF QUANTITIES


[illegible]

SANITARY SEWERAGE SYSTEM

CARVING CREEK

LANGLEY,McDONALD AND OVERMAN

C O N S U L T I N G E N G I N E E R S
N O R F O L K , V I R G I N I A

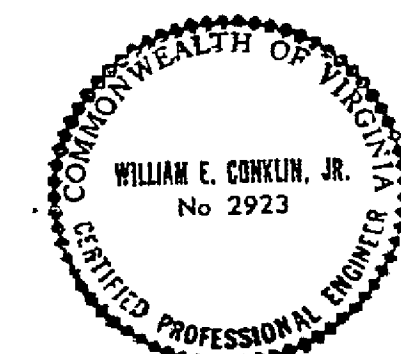

AS BUILT

SI-0325 71-7-S