



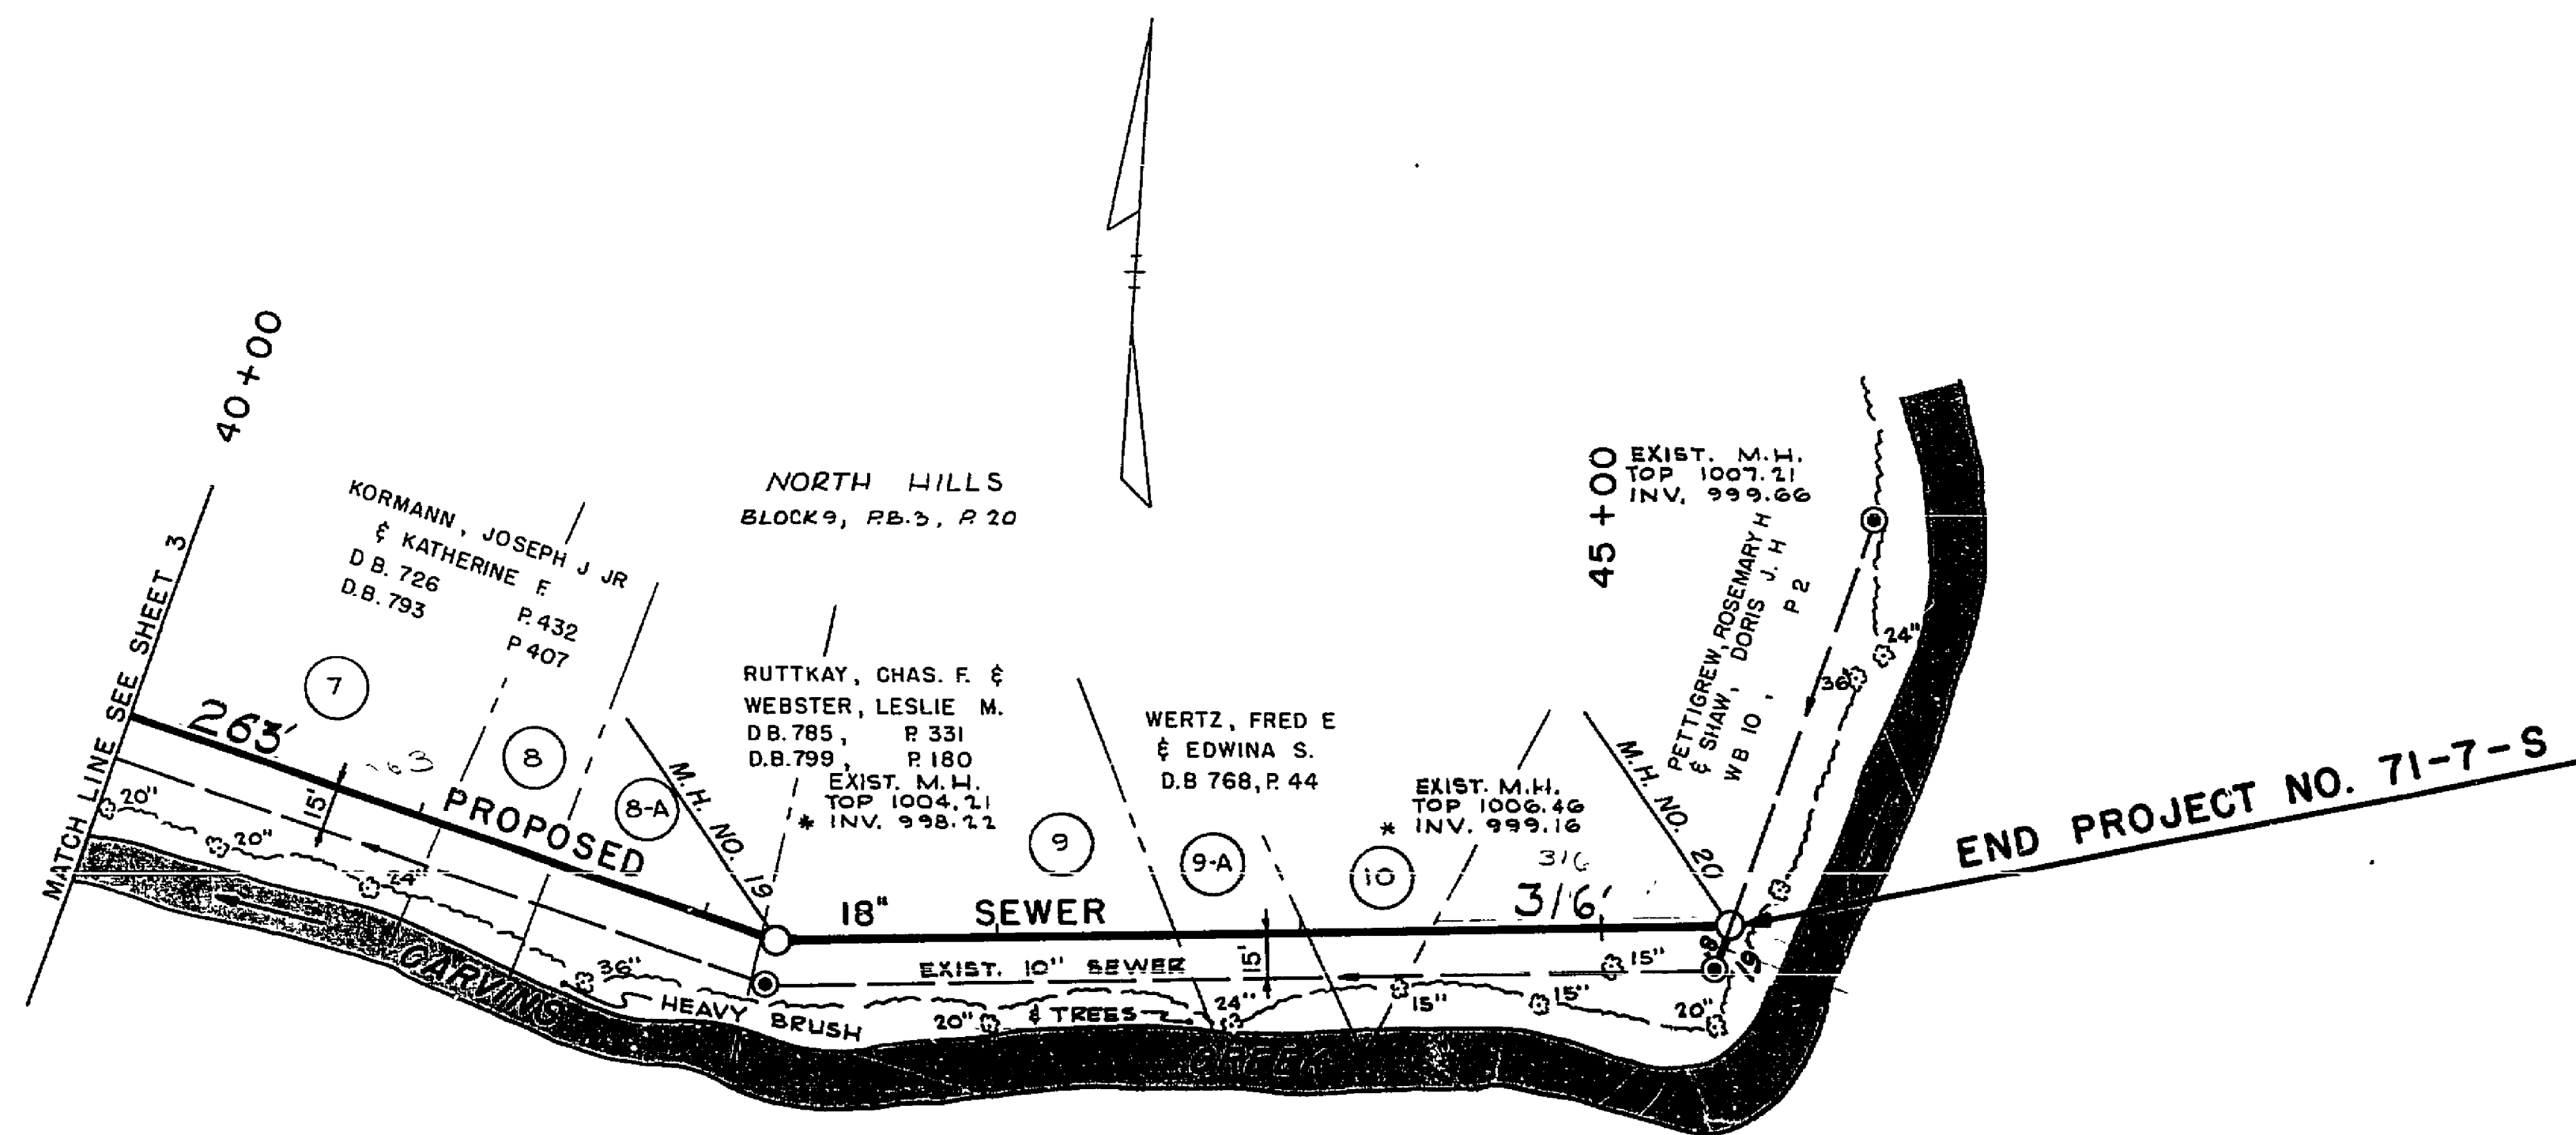

AS BUILT

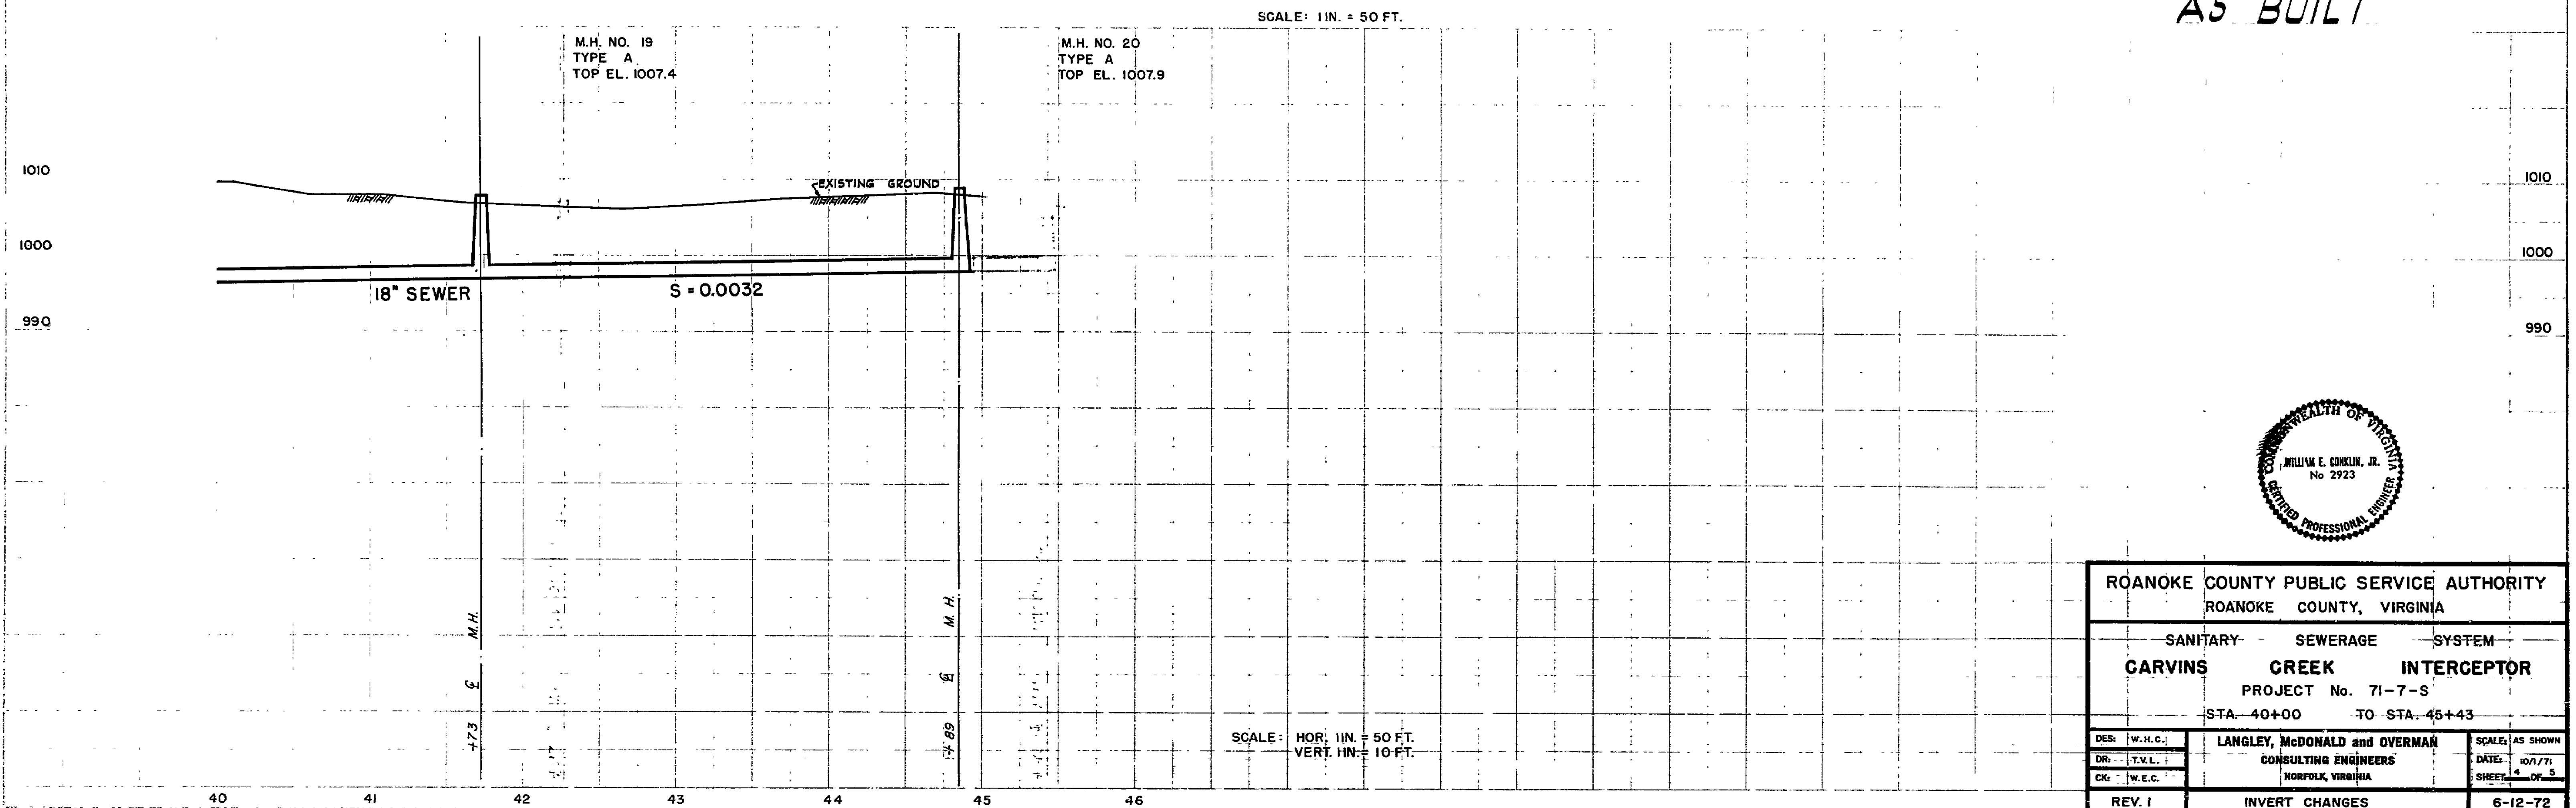

|                                                                     |                               |                 |
|---------------------------------------------------------------------|-------------------------------|-----------------|
| ROANOKE COUNTY PUBLIC SERVICE AUTHORITY<br>ROANOKE COUNTY, VIRGINIA |                               |                 |
| SANITARY SEWERAGE SYSTEM                                            |                               |                 |
| CARVINS CREEK INTERCEPTOR                                           |                               |                 |
| PROJECT No. 71-7-S                                                  |                               |                 |
| STA. 40+00 TO STA. 45+43                                            |                               |                 |
| DES: W.E.C.                                                         | LANGLEY, McDONALD and OVERMAN | SCALE: AS SHOWN |
| DR: T.V.L.                                                          | CONSULTING ENGINEERS          | DATE: 10/1/71   |
| CG: W.E.C.                                                          | NORFOLK, VIRGINIA             | SHEET: 4 OF 5   |
| REV. 1                                                              | INVERT CHANGES                | 6-12-72         |

SI-0331

3430

K&E PLATE PLATINUM  
487009 MADE IN JAPAN

