

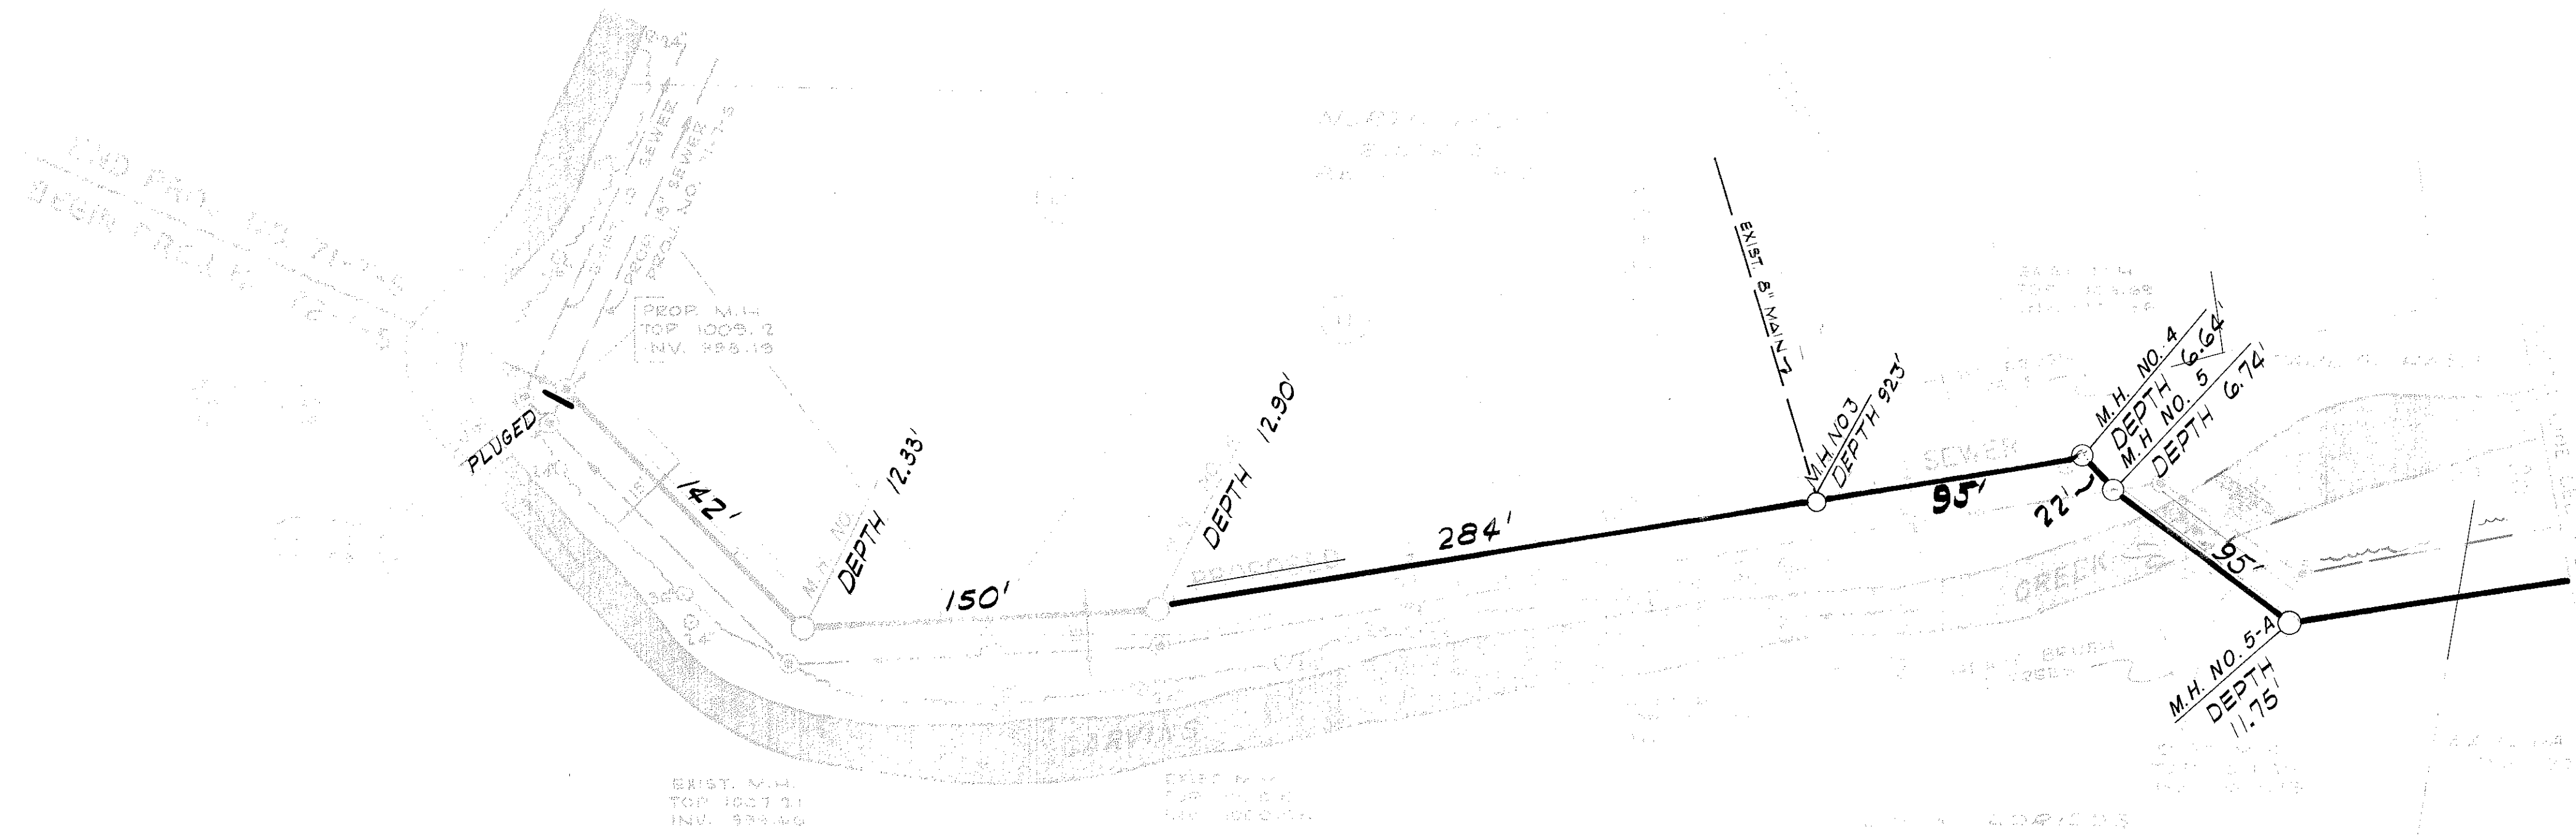


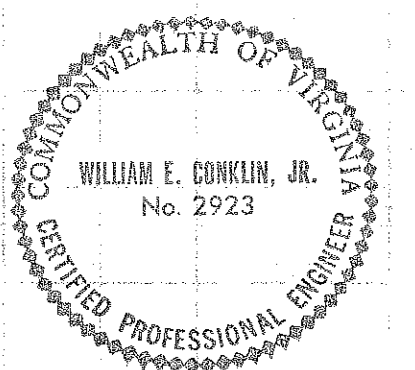

AS BUILT

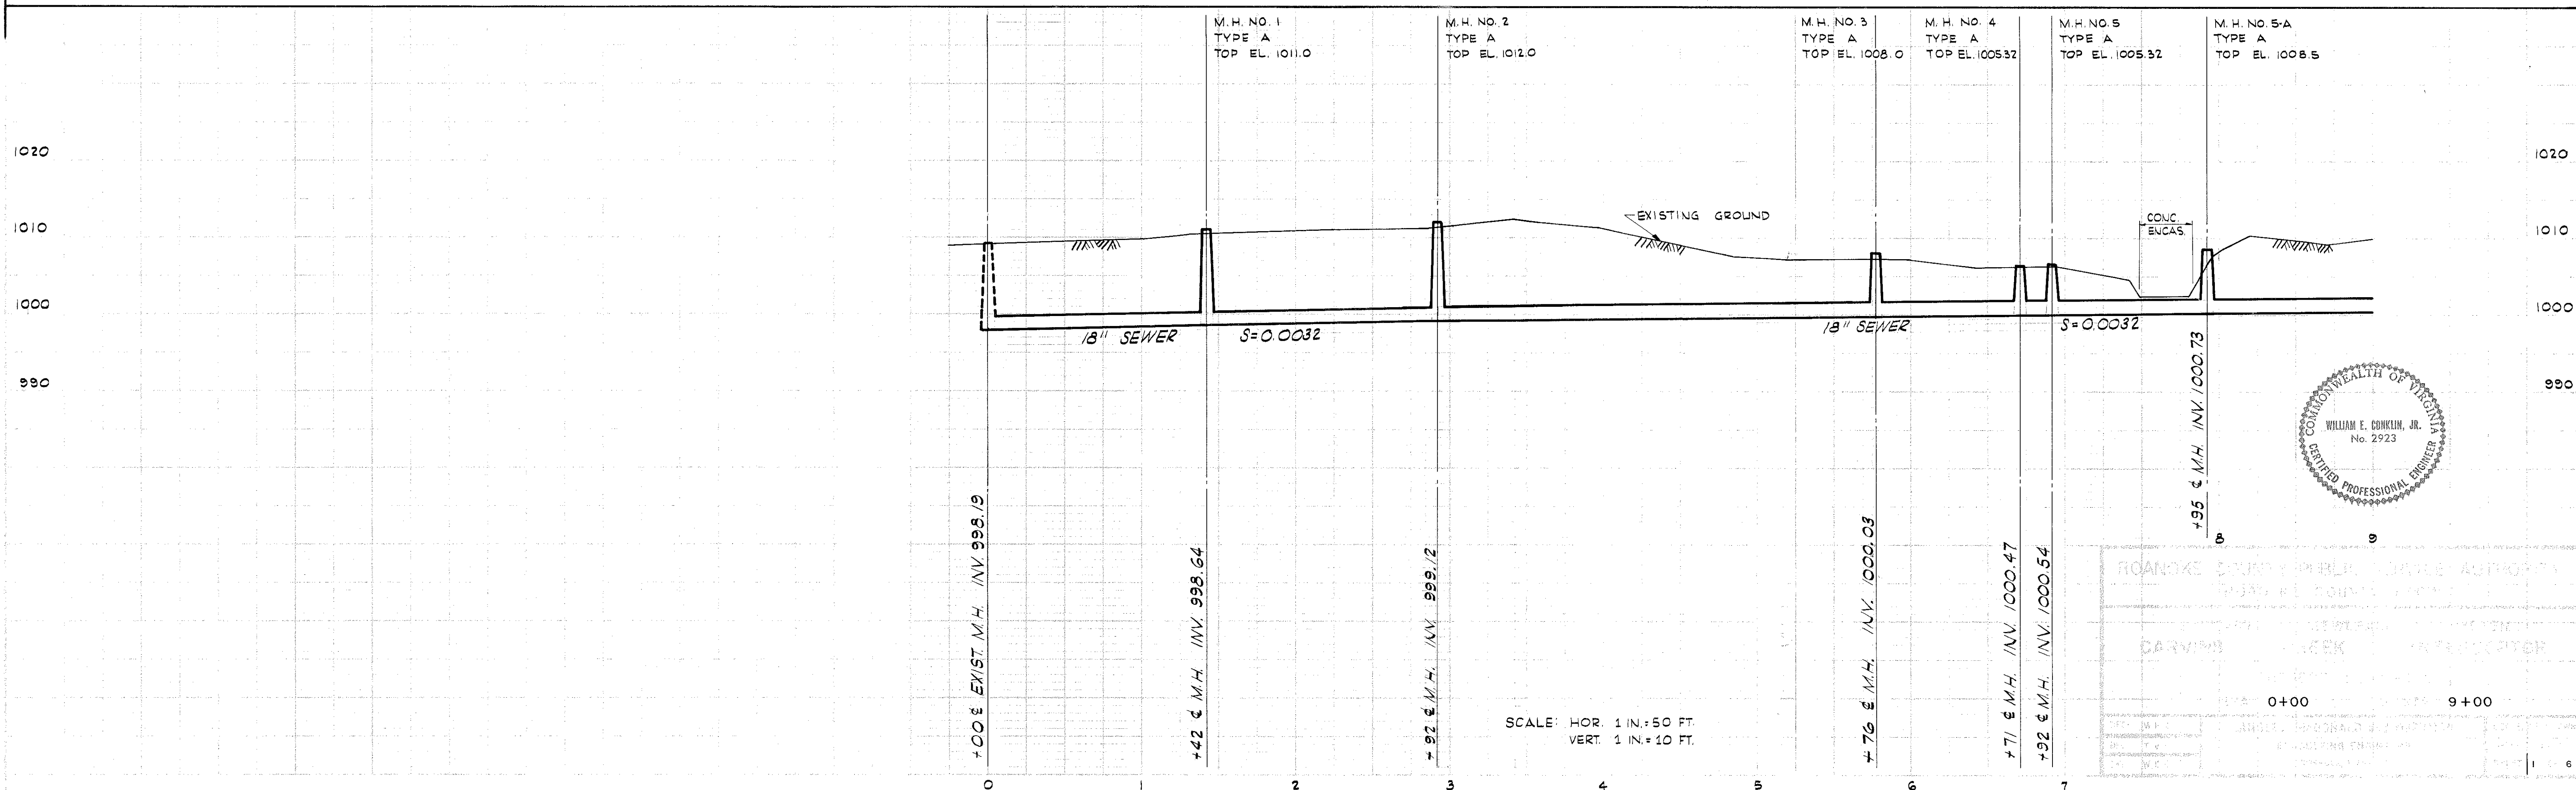

ROANOKE COUNTY PUBLIC WORKS DEPARTMENT
 ENGINEER
 CARVIN CREEK
 0+00 9+00
 1 6

SI-0208