


THE ENGINEER AND/OR SURVEYOR TAKES NO RESPONSIBILITY FOR THE LOCATION OR ACCURACY OF THE UTILITIES AS SHOWN HEREON OR ANY UTILITIES WITHIN THE PROJECT THAT MAY NOT BE SHOWN HEREON. THE CONTRACTOR SHALL BE RESPONSIBLE FOR CONTACTING THE UTILITY COMPANIES TO SEE IF ANY UTILITIES EXIST WITHIN THE AREA OF THE PROJECT BEFORE ANY CONSTRUCTION BEGINS. ANY COSTS INCURRED BY DAMAGING ANY UTILITY WITHIN THE PROJECT SHALL BE AT THE EXPENSE OF THE CONTRACTOR.

PLAN
DATE: 6-23-86
BY: [Signature]
CHECKED: [Signature]
SCALE: AS NOTED

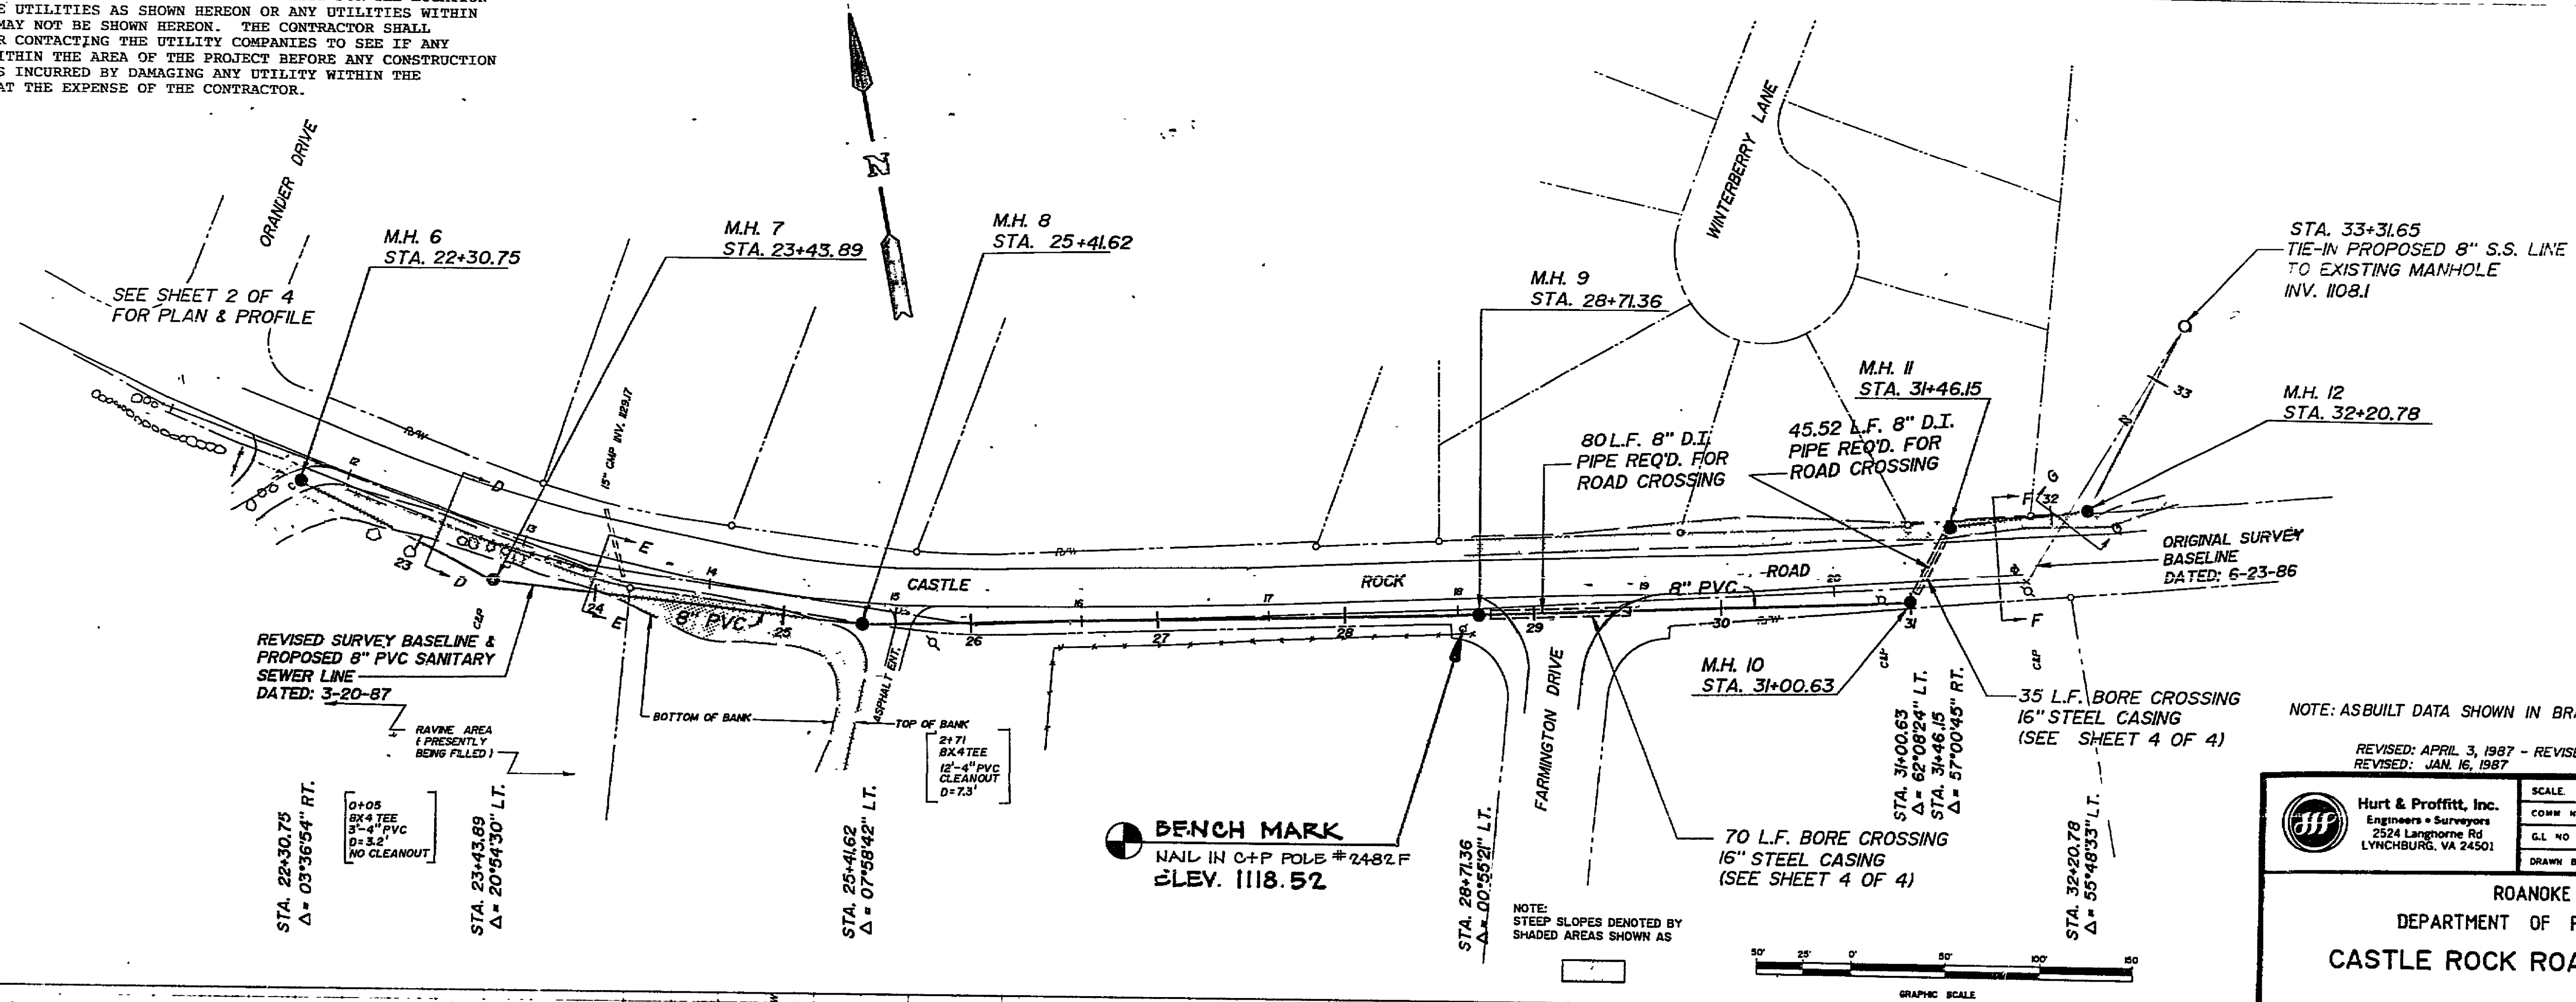

NOTE: ASBUILT DATA SHOWN IN BRACKETS 9-9-88
REVISED: APRIL 3, 1987 - REVISED BASELINE
REVISED: JAN 16, 1987

Hurt & Proffitt, Inc. Engineers & Surveyors 2524 Langhorne Rd LYNCHBURG, VA 24501		SCALE: AS NOTED	DATE: 6-23-86
COMM NO: 8663	DESIGN BY: WMB	FILE NO: G-974	
GL NO:	CK BY: ESE		
ROANOKE COUNTY DEPARTMENT OF PUBLIC FACILITIES CASTLE ROCK ROAD SEWER LINE			

PROFILE
DATE: 6-23-86
BY: [Signature]
CHECKED: [Signature]
SCALE: AS NOTED

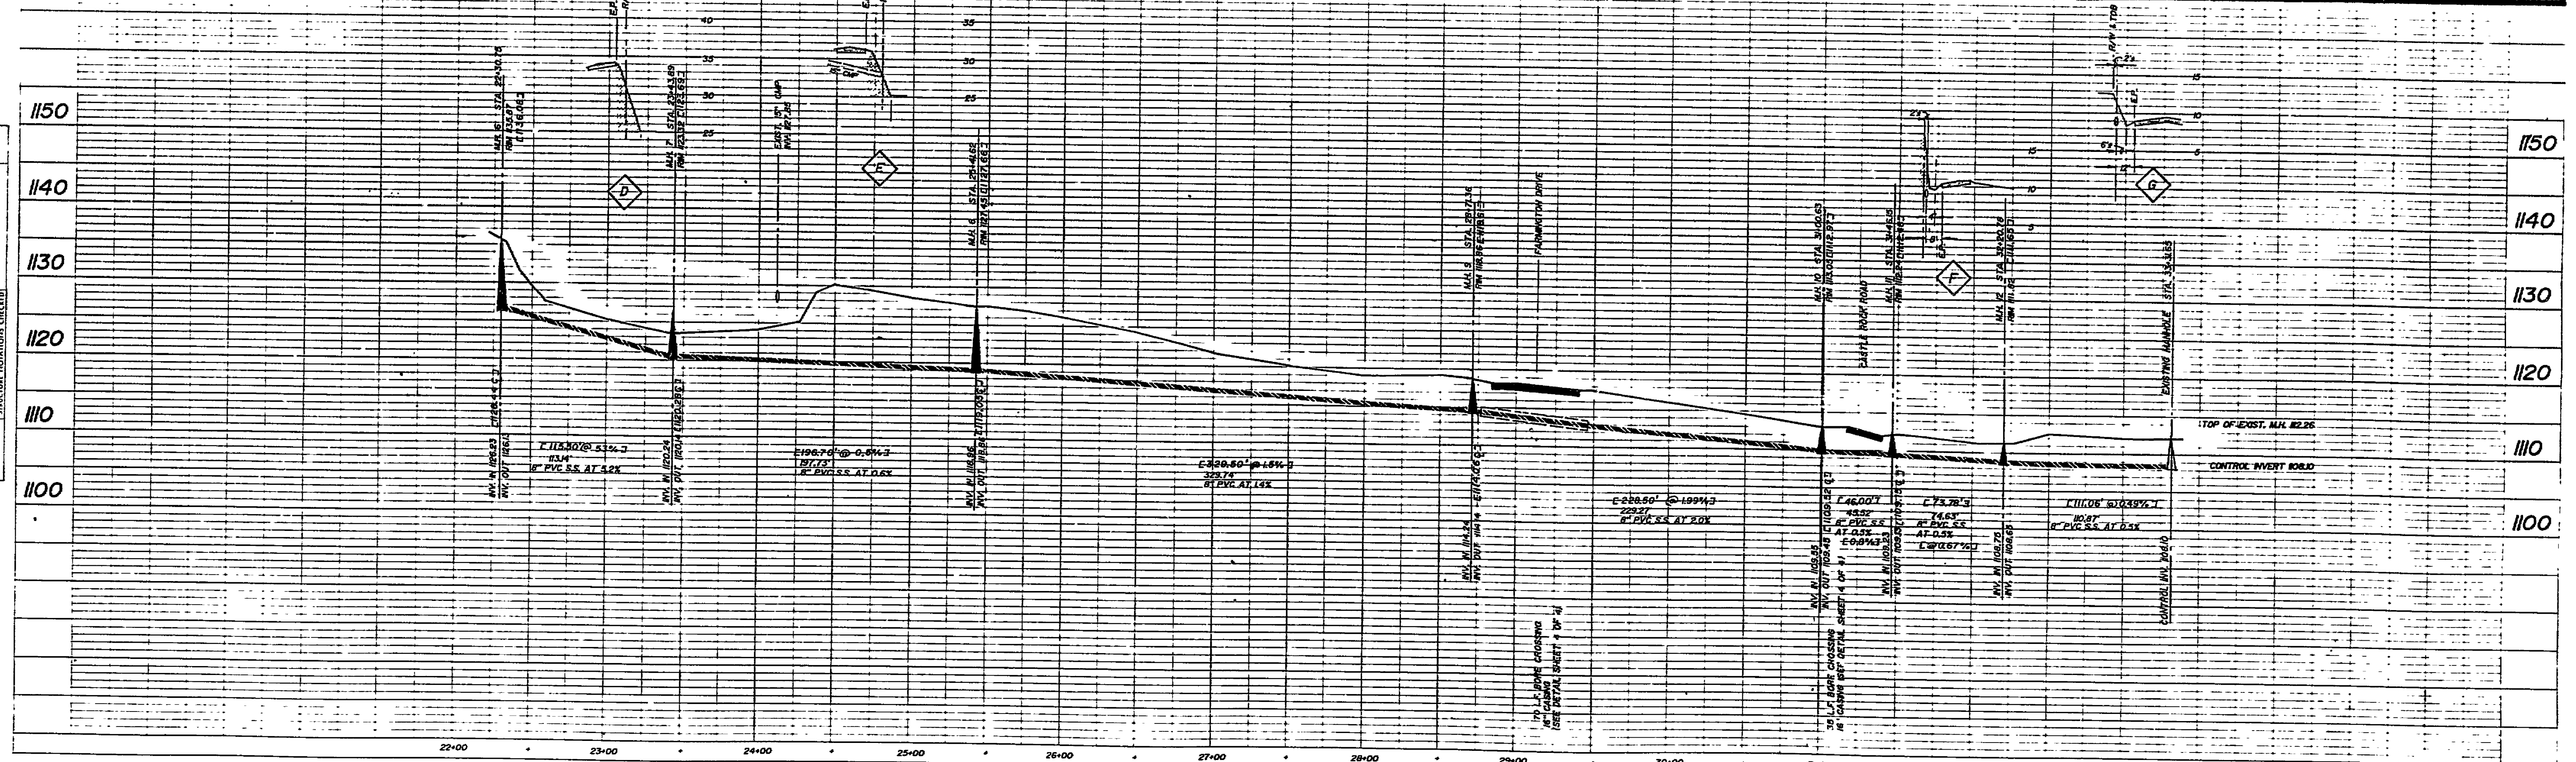


PLATE 1-SINGLE PLAN AND PROFILE FULL LINE
PRINTED IN U.S.A.

86-01-S

SHEET 3 OF 4