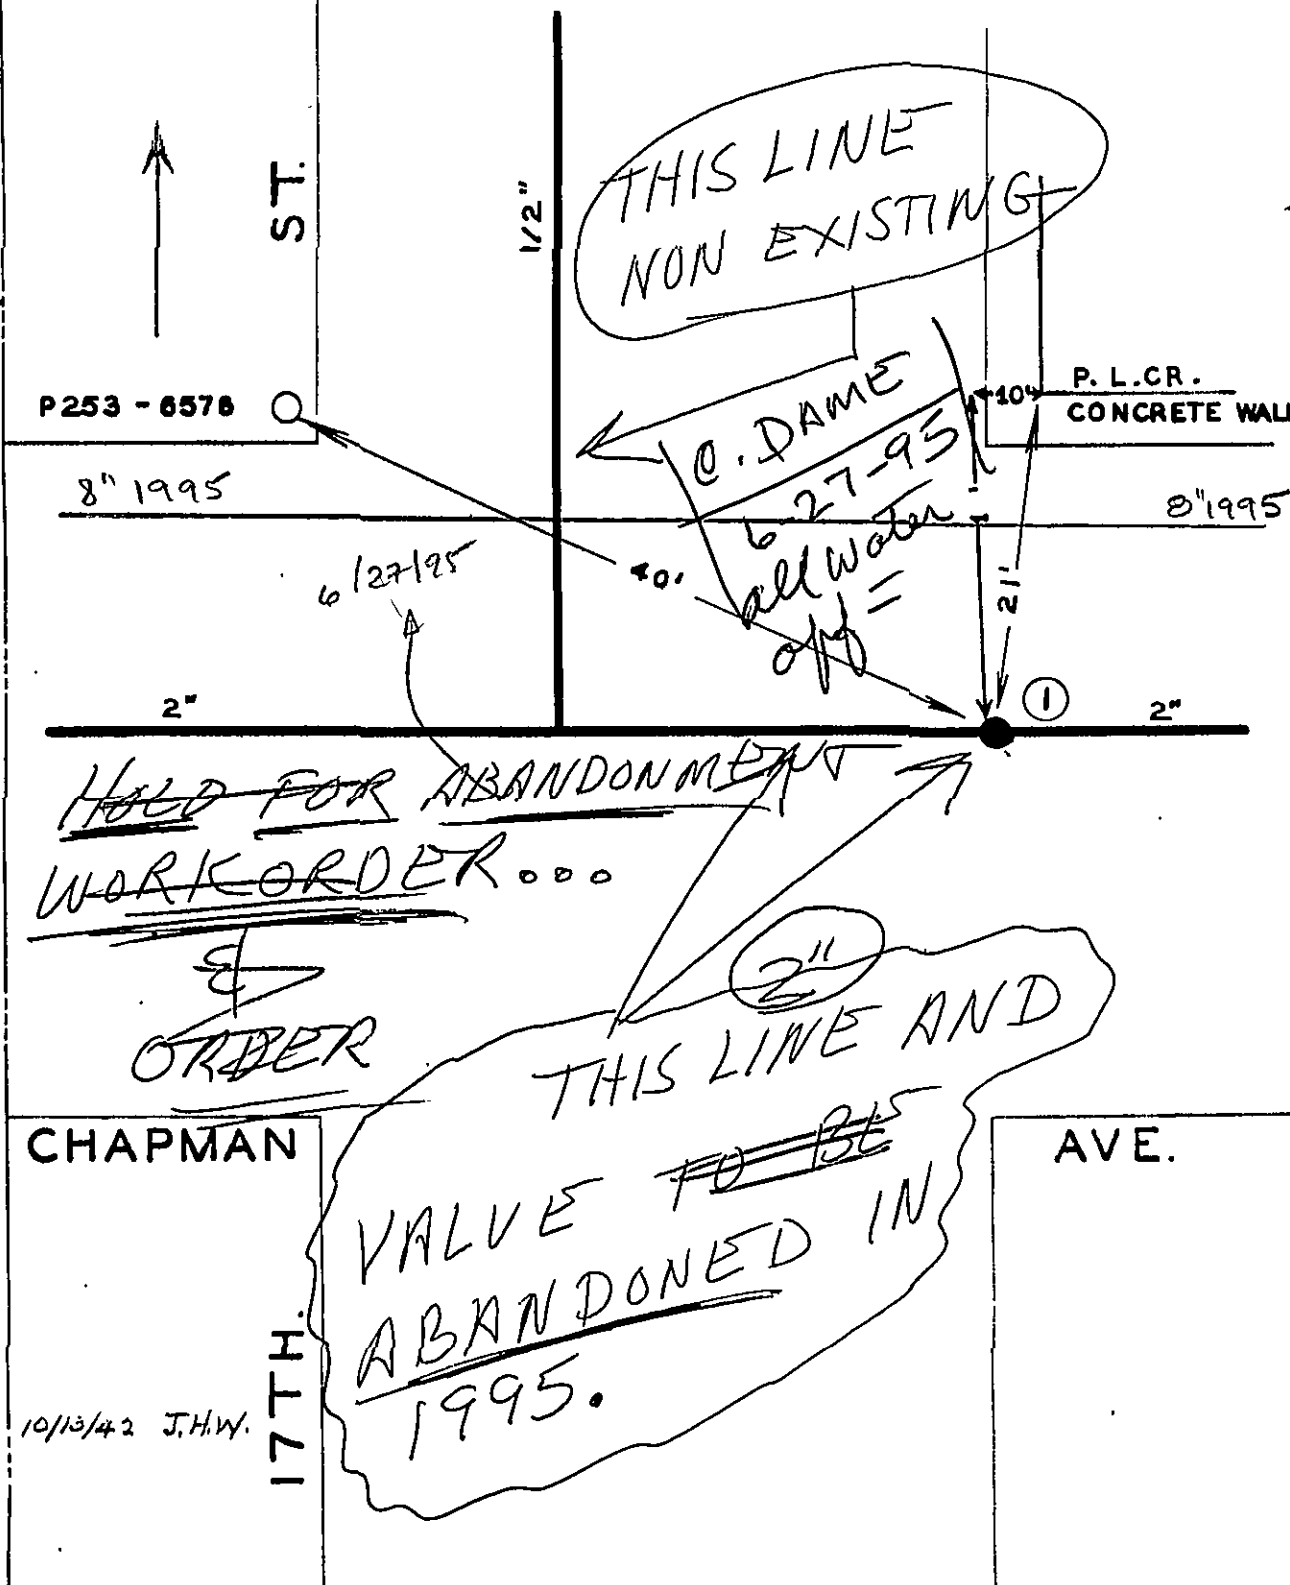


[illegible]

CITY OF ROANOKE—WATER DEPT
VALVE DIAGRAM

CHAPMAN AVE. & 17TH.

ST. S. W.

SEC MAP 121

041E

PAGE NO **S.W.188**