

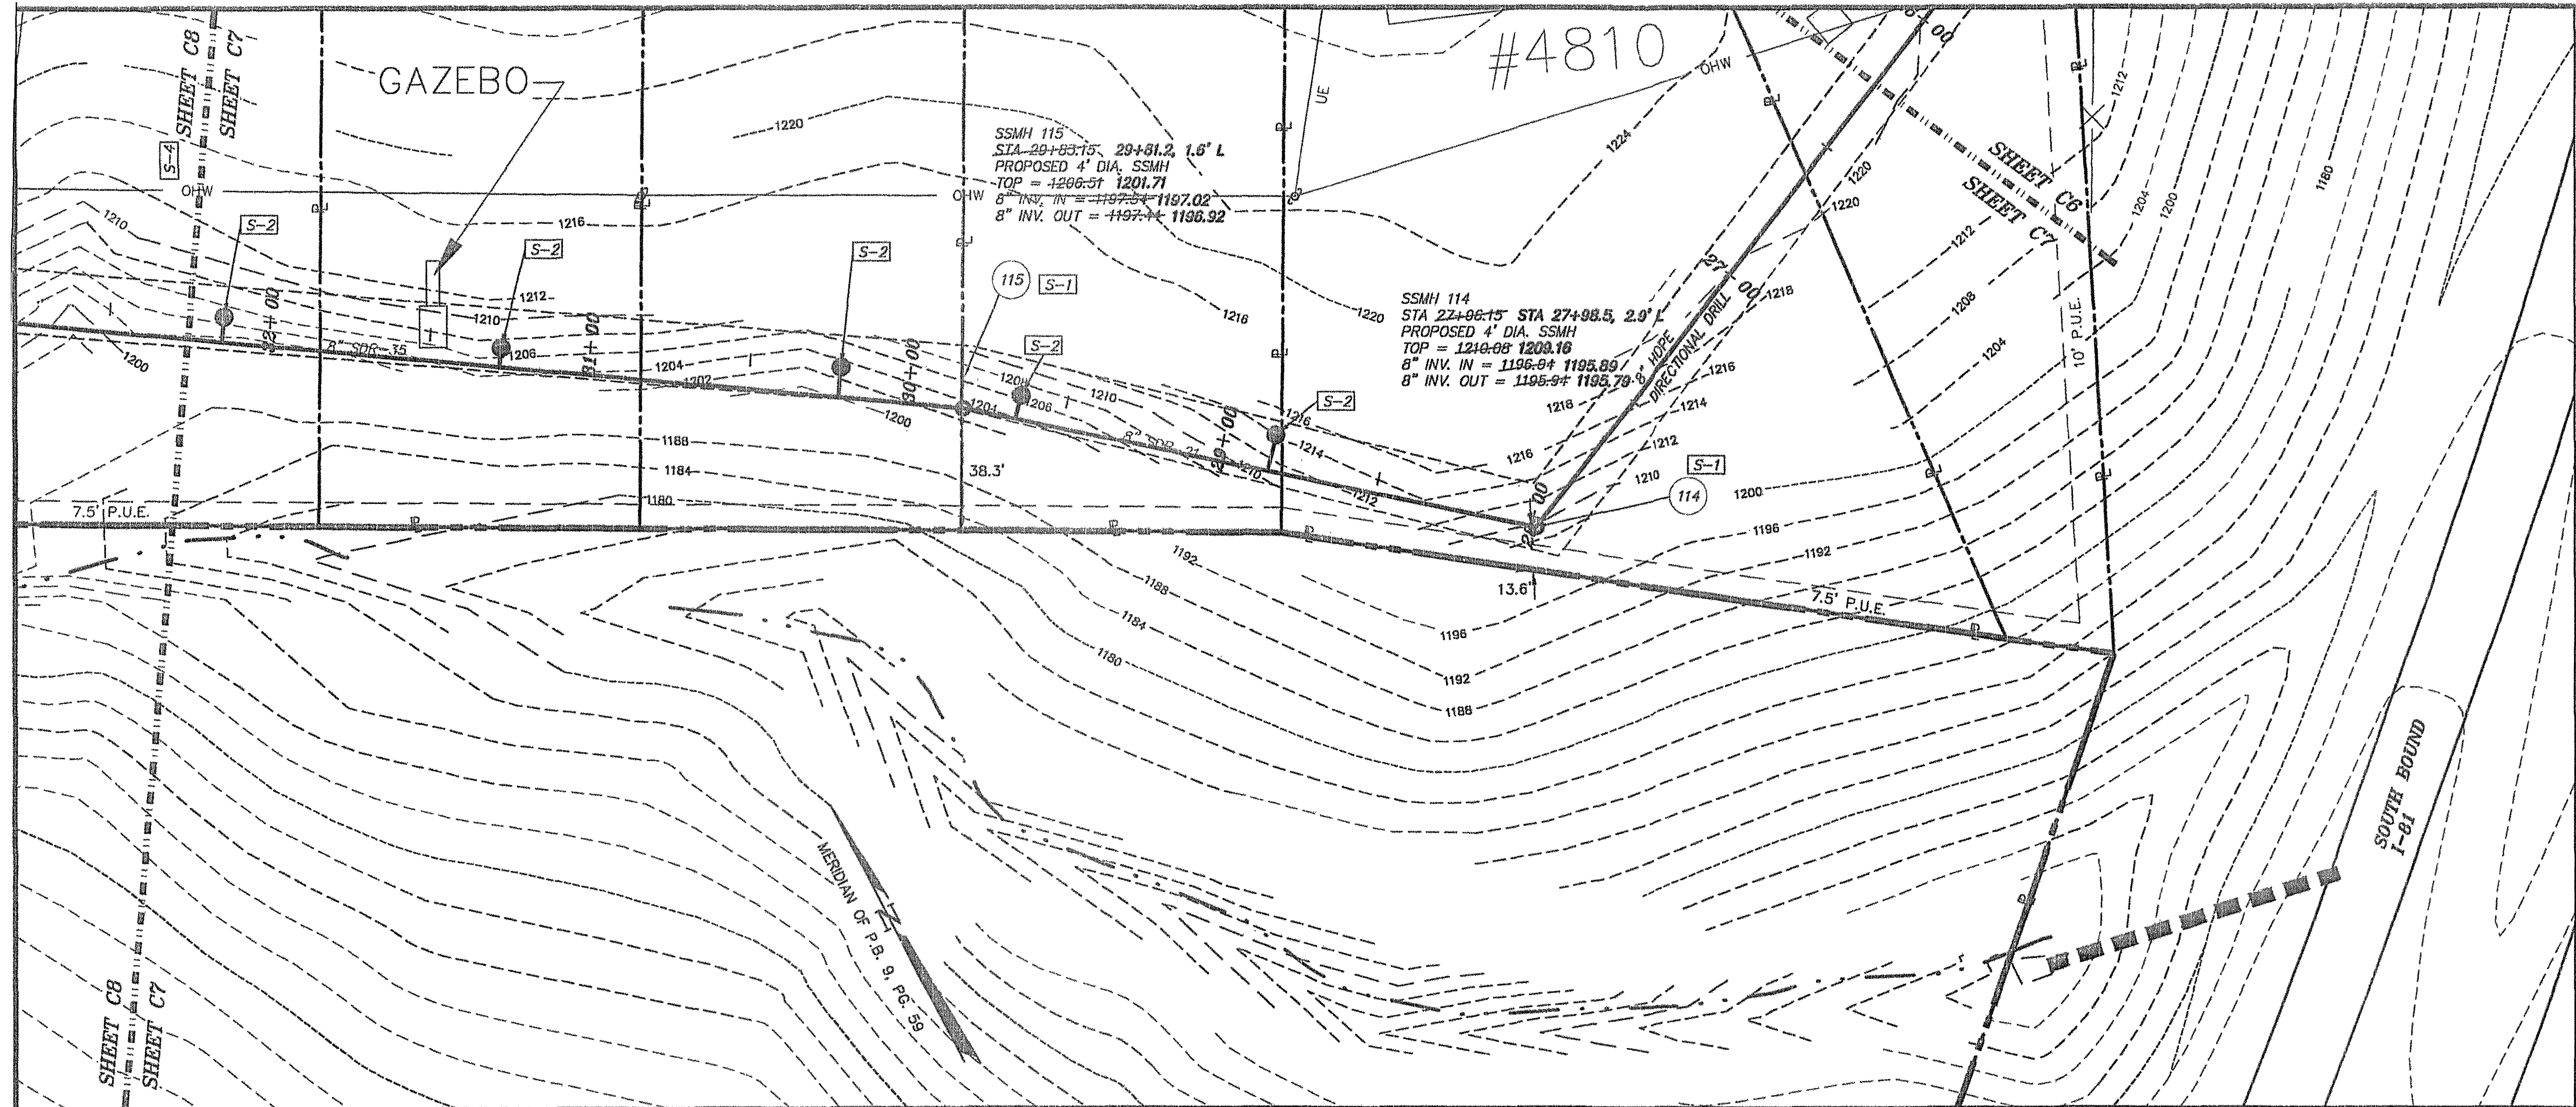


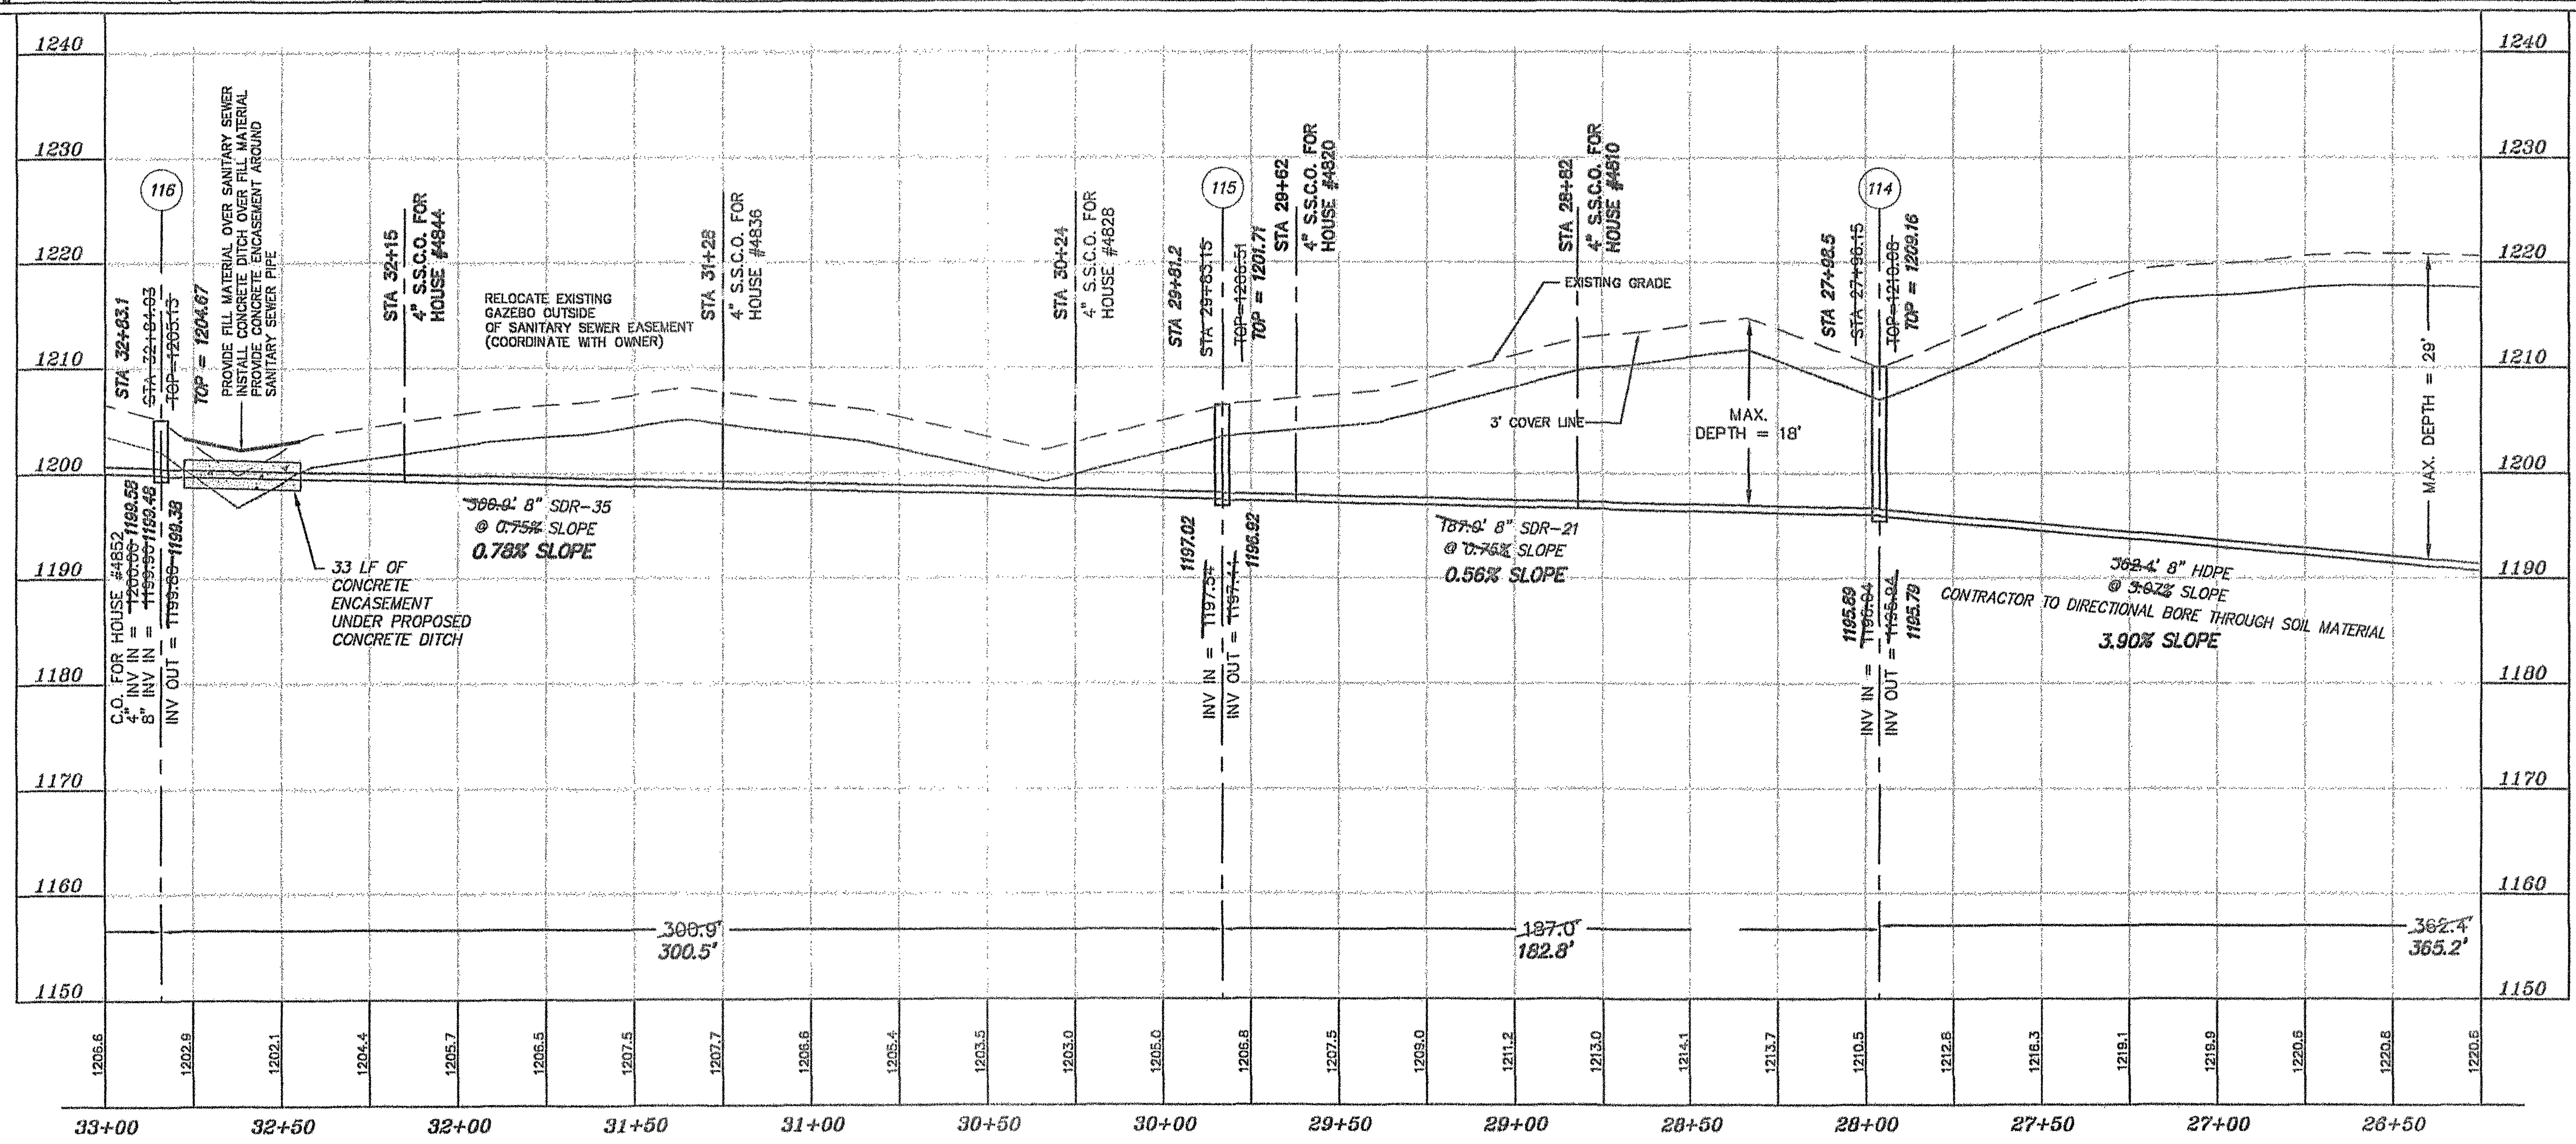

- GENERAL NOTES:
1. REFERENCE IS DIRECTED TO SHEET C2 FOR DESCRIPTION OF "S-#" AND HOW IT CORRESPONDS TO THE WESTERN VIRGINIA WATER AUTHORITY DETAIL "DD-##".
 2. THE CONTRACTOR SHALL DIRECTIONAL DRILL FROM MANHOLE 113 TO 114. THE SANITARY SEWER LINE IN THIS AREA SHALL NOT BE CONSTRUCTED BY OPEN CUT OF THE SOIL MATERIAL.
 3. THE CONTRACTOR SHALL NOTE THE RELOCATION OF AN EXISTING GAZEBO. THE NEW LOCATION OF THE GAZEBO SHALL BE OUTSIDE THE SANITARY SEWER EASEMENT.
 4. REFERENCE IS DIRECTED TO THE ASSOCIATED PROFILE SHOWING ADDITIONAL CONSTRUCTION ITEMS.
 5. REFERENCE IS DIRECTED TO THE REQUIRED EROSION CONTROL MEASURES FOR THE SANITARY SEWER INSTALLATION. REFERENCE IS DIRECTED TO THE "EROSION CONTROL NARRATIVE & DETAILS" FOR ADDITIONAL INFORMATION AND QUANTITIES.
 6. REFERENCE IS DIRECTED TO THE SANITARY SEWER MANHOLE DETAILS FOR CONSTRUCTION ANGLES AND LINES ENTERING AND LEAVING THE MANHOLE.
 7. THE CONTRACTOR SHALL COORDINATE WITH THE LAND OWNERS AND/OR RESIDENTS OF HOMES WHEN WORKING WITHIN EACH PROPERTY.

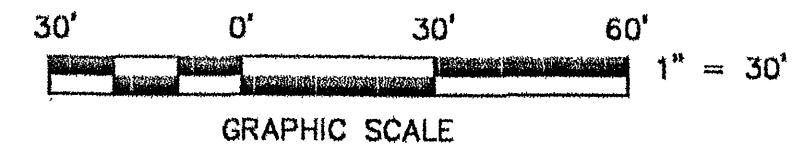

SANITARY SEWER PROFILE. SCALE: HORIZ: 1" = 30'. VERT: 1" = 10'

AS-BUILT

REVISED DEC. 9, 2005: AS-BUILT SURVEY OF SANITARY SEWER MANHOLES

DESIGNED BY P.J. BROWN
DRAWN BY PJB
CHECKED BY PJB
W.O. # 04-0071
N.B. JR-246
TAX NO. 054.04-05-01

T. P. PARKER & SON
816 Boulevard
Post Office Box 39
Salem, Virginia 24153
Telephone: 540-387-1153
FAX: 540-368-6767
04-0071-OSSL-ASBLT.DWG

TPP&S
ENGINEERS
SURVEYORS
PLANNERS

SANITARY SEWER PLAN - STA 26+25 THRU 32+25
OF
PUBLIC SANITARY SEWER EXTENSION
FROM WEST MAIN STREET TO PROPERTY
OWNED BY TOWNSIDE CONSTRUCTION CO., INC.
CATAWBA MAGISTERIAL DISTRICT
ROANOKE COUNTY, VIRGINIA
REVISED: 03 DECEMBER 2004 SCALE: 1" = 30'