

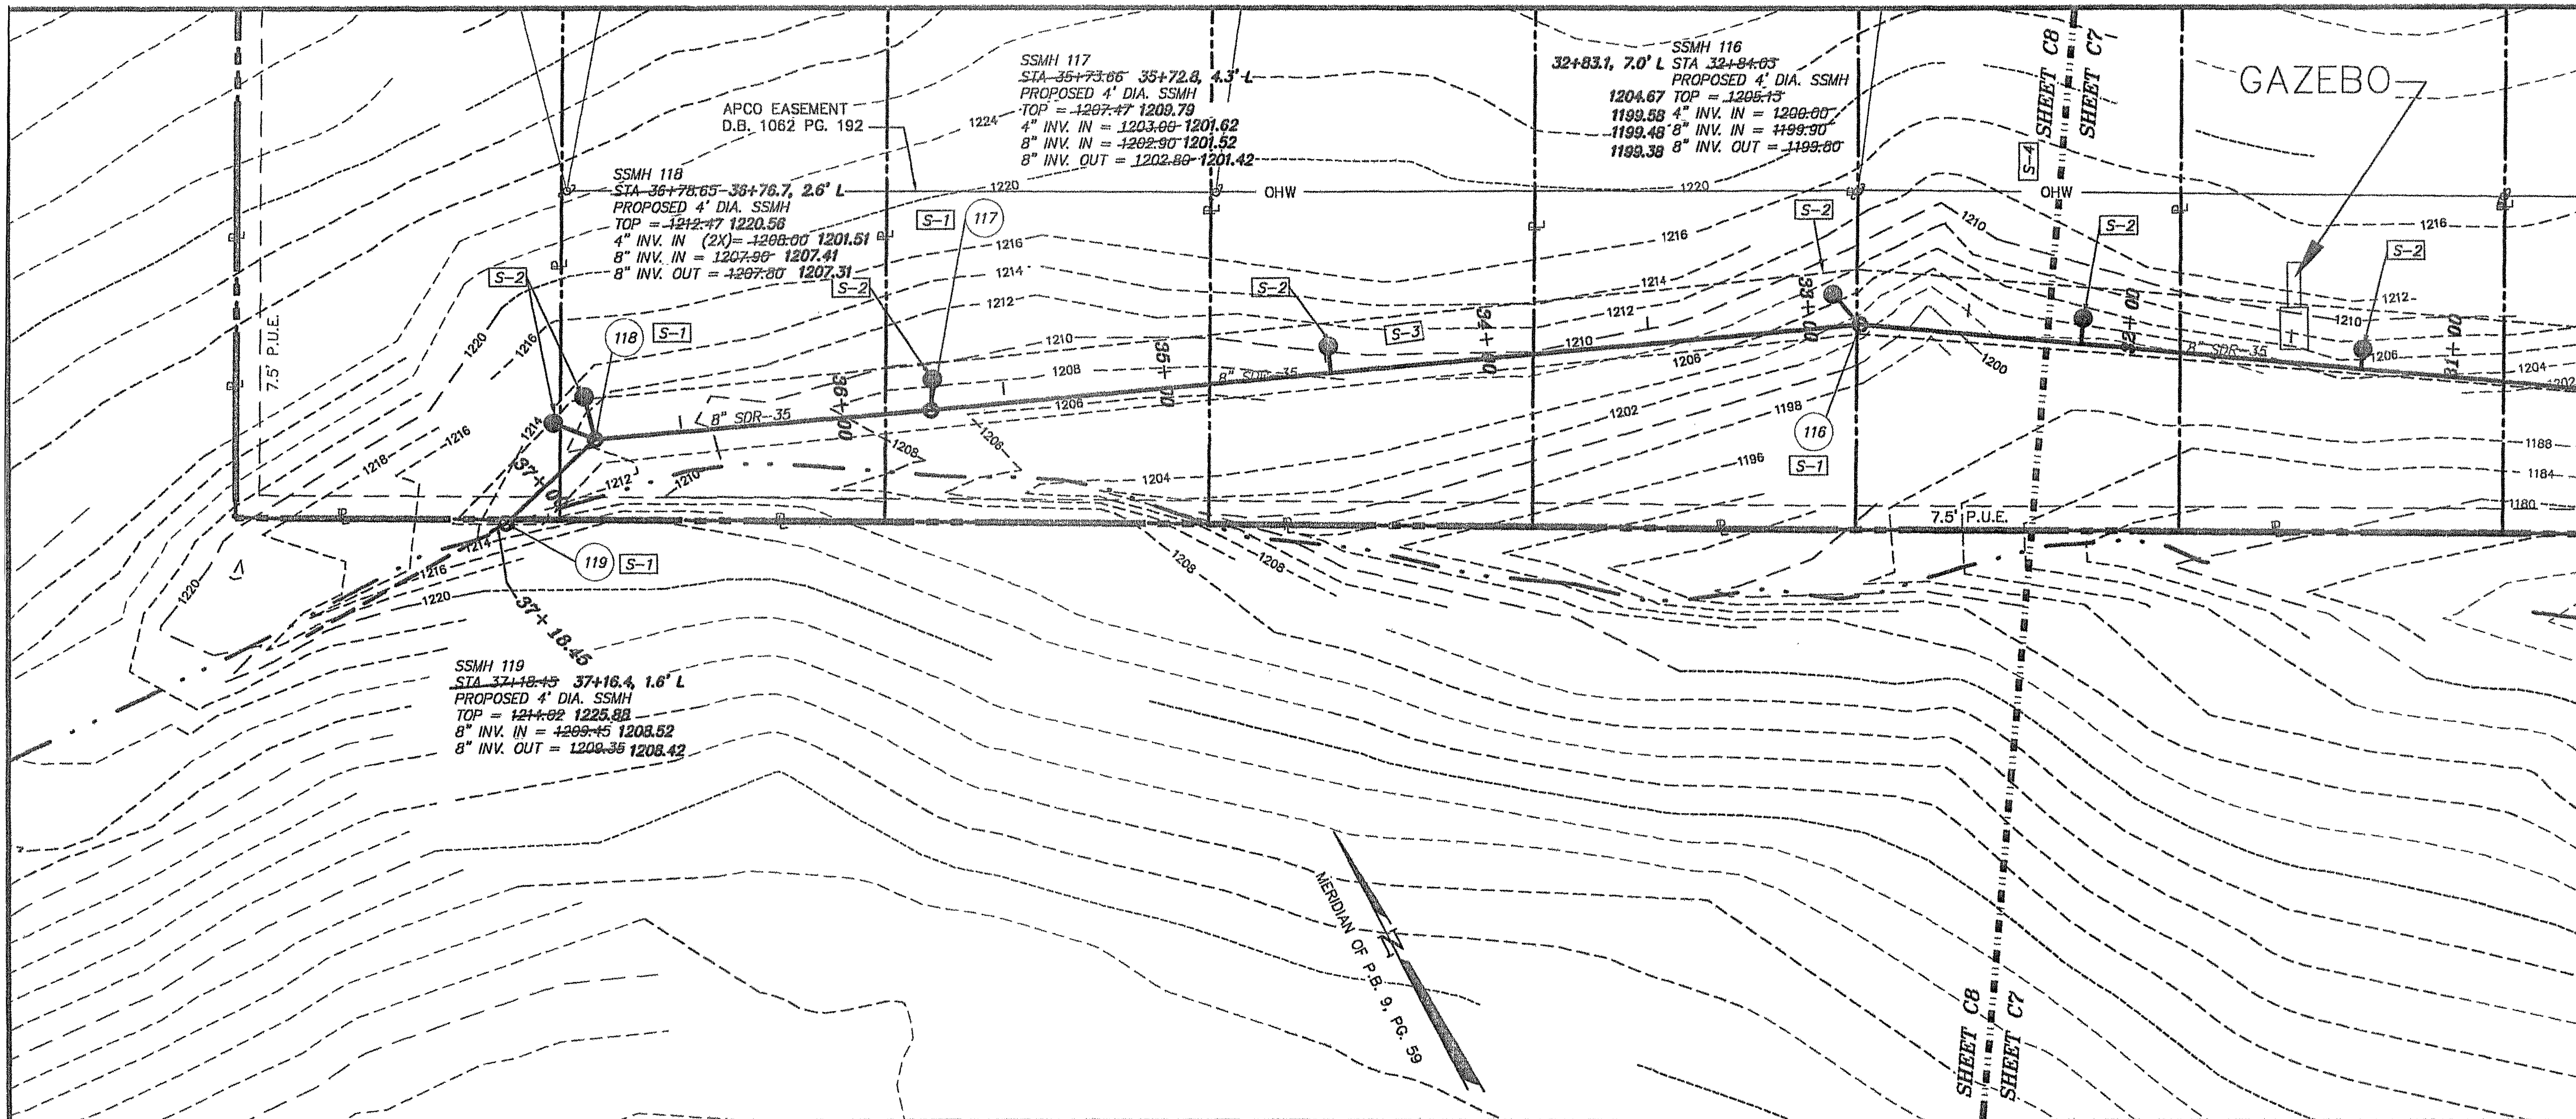


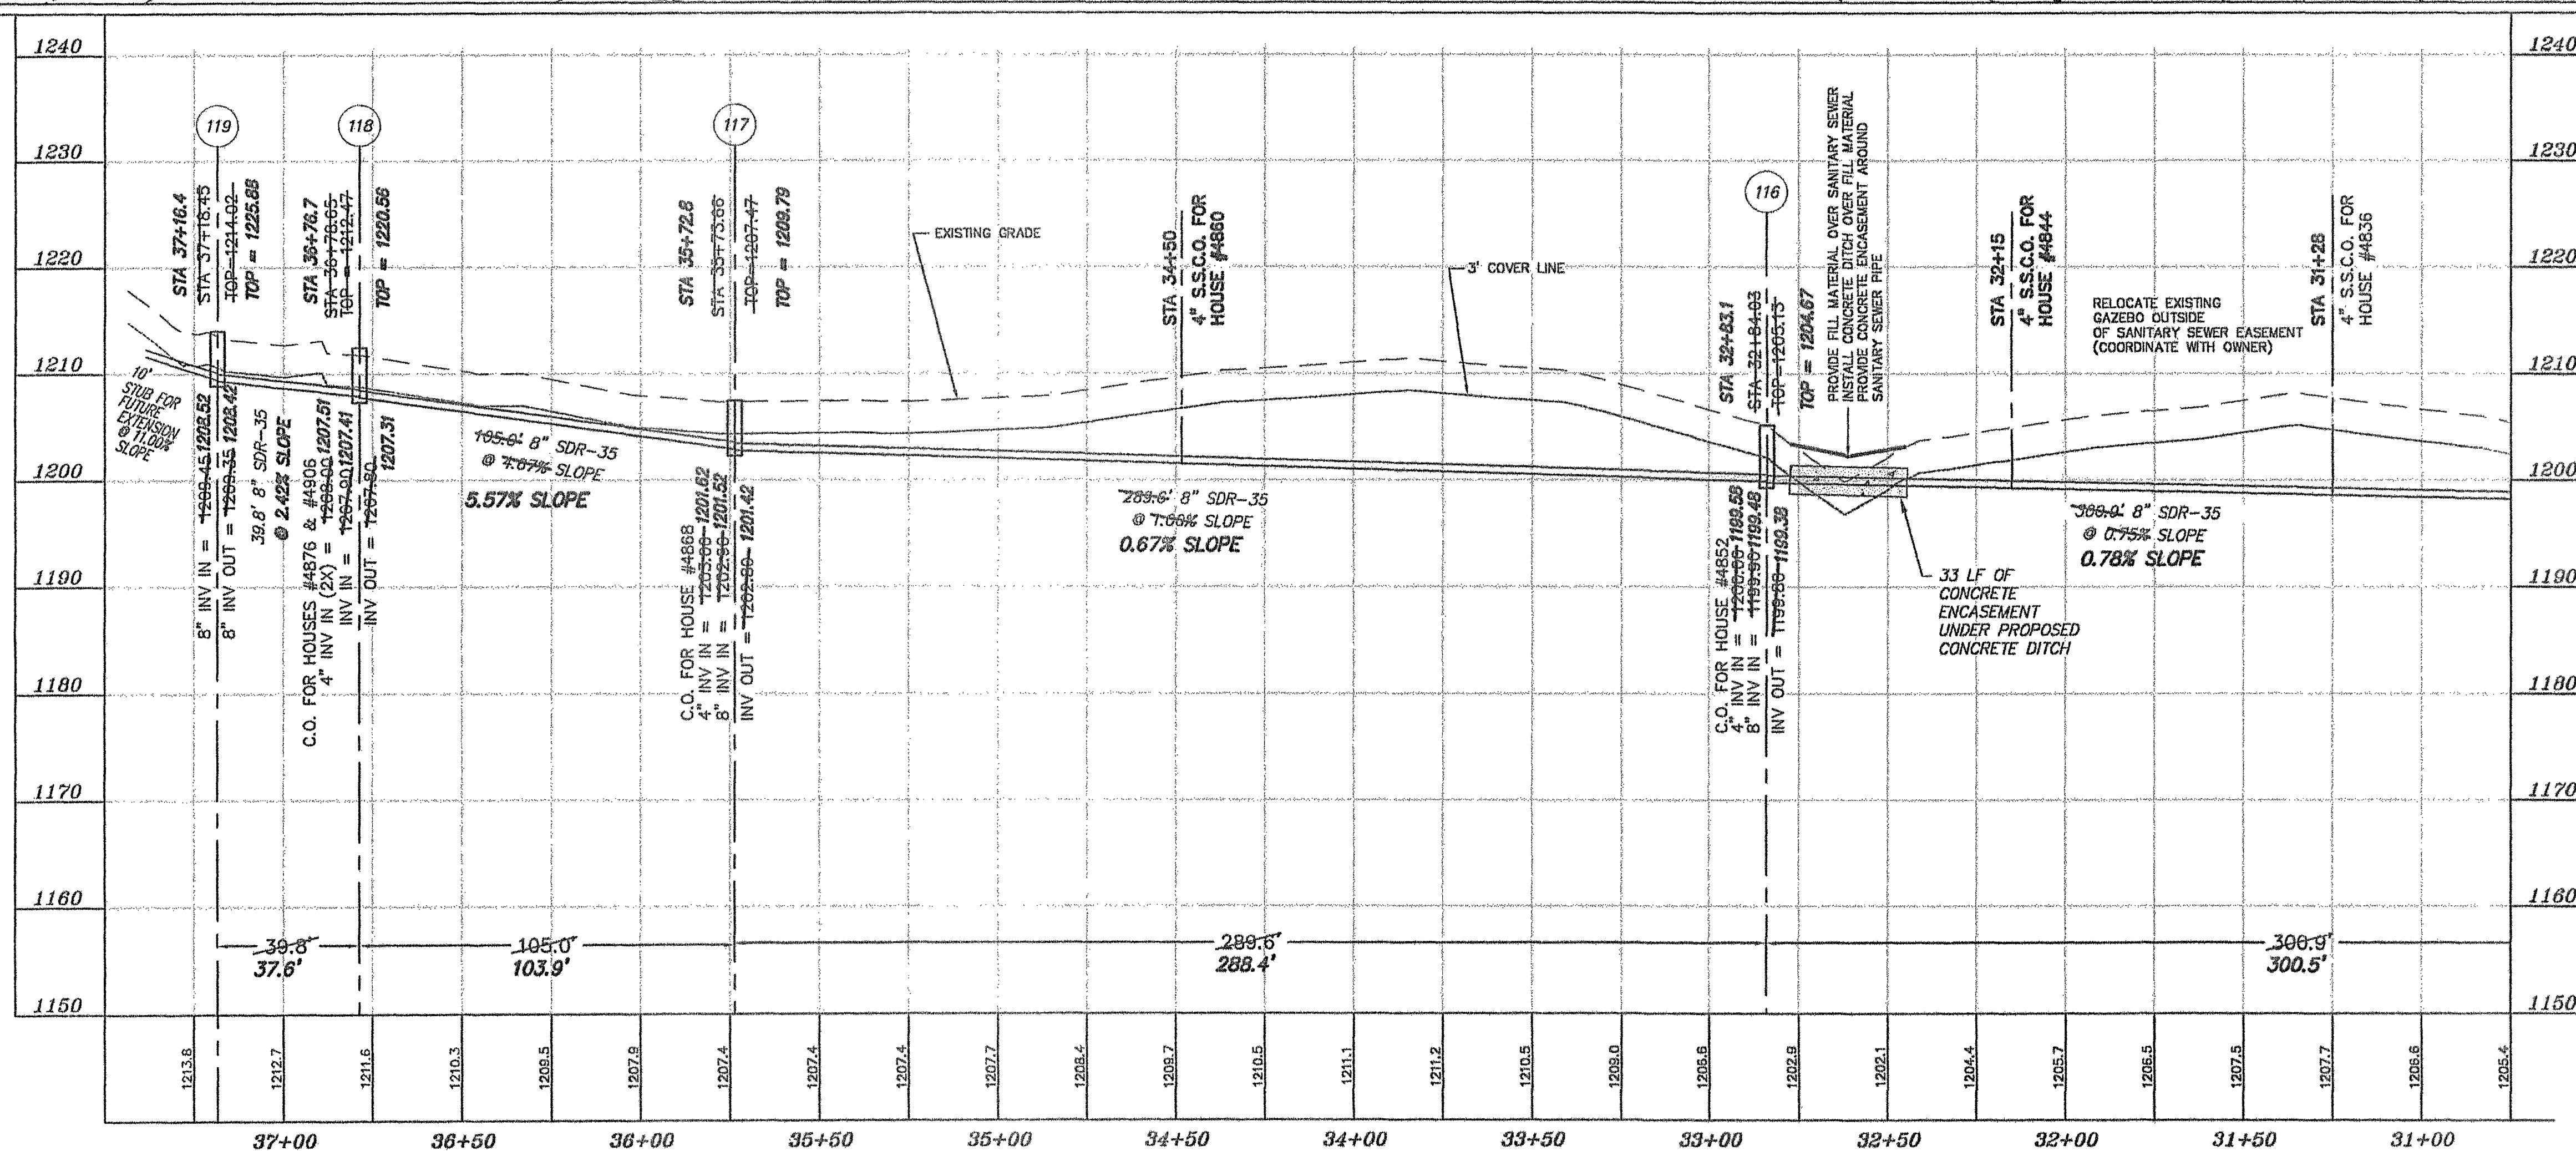

- GENERAL NOTES:**
- REFERENCE IS DIRECTED TO SHEET C2 FOR DESCRIPTION OF "S-#" AND HOW IT CORRESPONDS TO THE WESTERN VIRGINIA WATER AUTHORITY DETAIL "DD-##".
 - THE CONTRACTOR SHALL NOTE THE NEED TO INSTALL A NEW CONCRETE DITCH AND CONCRETE ENCASUREMENT AS SHOWN ON THE PLAN AND PROFILE.
 - THE CONTRACTOR SHALL NOTE THE RELOCATION OF AN EXISTING GAZEBO. THE NEW LOCATION OF THE GAZEBO SHALL BE OUTSIDE THE SANITARY SEWER EASEMENT.
 - REFERENCE IS DIRECTED TO THE ASSOCIATED PROFILE SHOWING ADDITIONAL CONSTRUCTION ITEMS.
 - REFERENCE IS DIRECTED TO THE REQUIRED EROSION CONTROL MEASURES FOR THE SANITARY SEWER INSTALLATION. REFERENCE IS DIRECTED TO THE "EROSION CONTROL NARRATIVE & DETAILS" FOR ADDITIONAL INFORMATION AND QUANTITIES.
 - REFERENCE IS DIRECTED TO THE SANITARY SEWER MANHOLE DETAILS FOR CONSTRUCTION ANGLES AND LINES ENTERING AND LEAVING THE MANHOLE.
 - THE CONTRACTOR SHALL COORDINATE WITH THE LAND OWNERS AND/OR RESIDENTS OF HOMES WHEN WORKING WITHIN EACH PROPERTY.

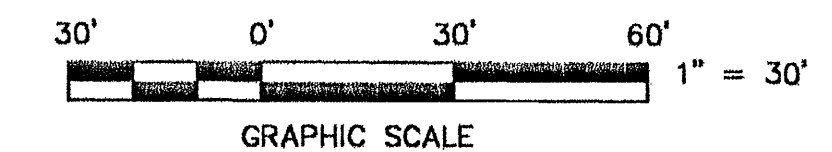

AS-BUILT

REVISED DEC. 9, 2005: AS-BUILT SURVEY OF SANITARY SEWER MANHOLES

SANITARY SEWER PLAN - STA 32+25 THRU 37+18.45

OF
PUBLIC SANITARY SEWER EXTENSION
FROM WEST MAIN STREET TO PROPERTY
OWNED BY TOWNSIDE CONSTRUCTION CO., INC.
CATAWBA MAGISTERIAL DISTRICT
ROANOKE COUNTY, VIRGINIA

REVISED: 03 DECEMBER 2004 SCALE: 1" = 30'

T. P. PARKER & SON

818 Boulevard
Post Office Box 39
Salem, Virginia 24153
Telephone: 540-387-1153
FAX: 540-388-6787

DESIGNED BY: PJB
DRAWN BY: PJB
CHECKED BY: PJB
W.O. #: 04-0071
N.B.: JR-246
TAX NO.: 054.04-05-01

TPP&S
ENGINEERS
SURVEYORS
PLANNERS

SANITARY SEWER PROFILE. SCALE: HORIZ: 1" = 30'. VERT: 1" = 10'