
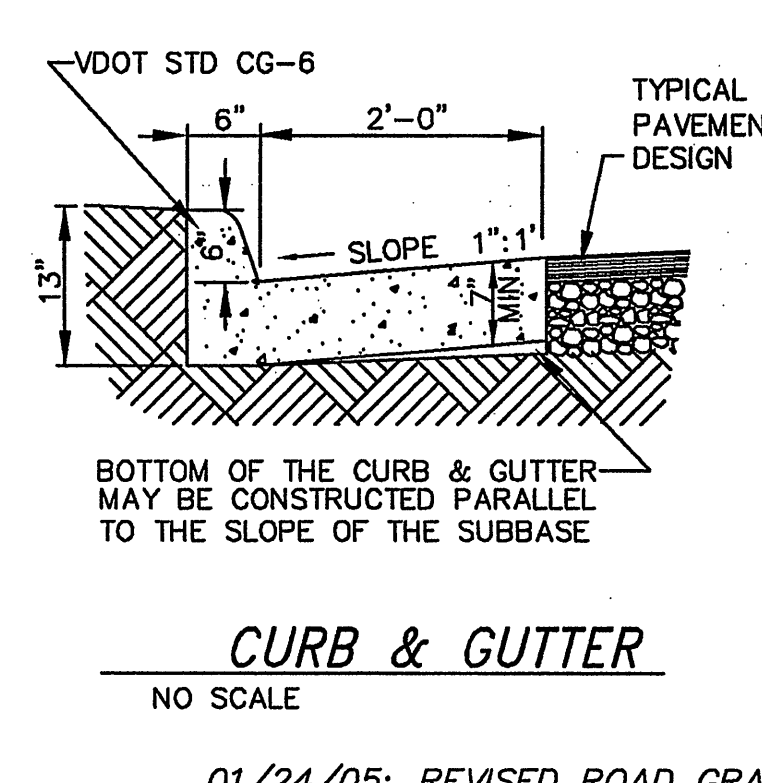
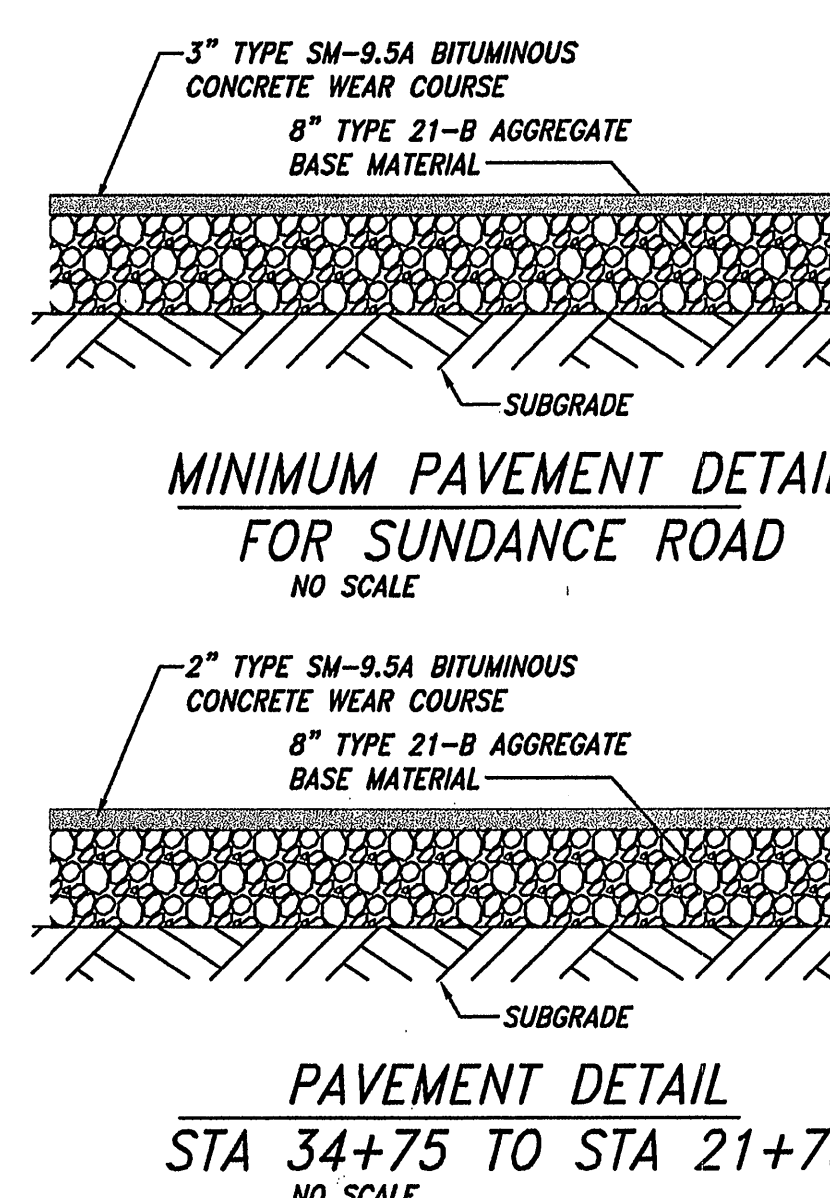
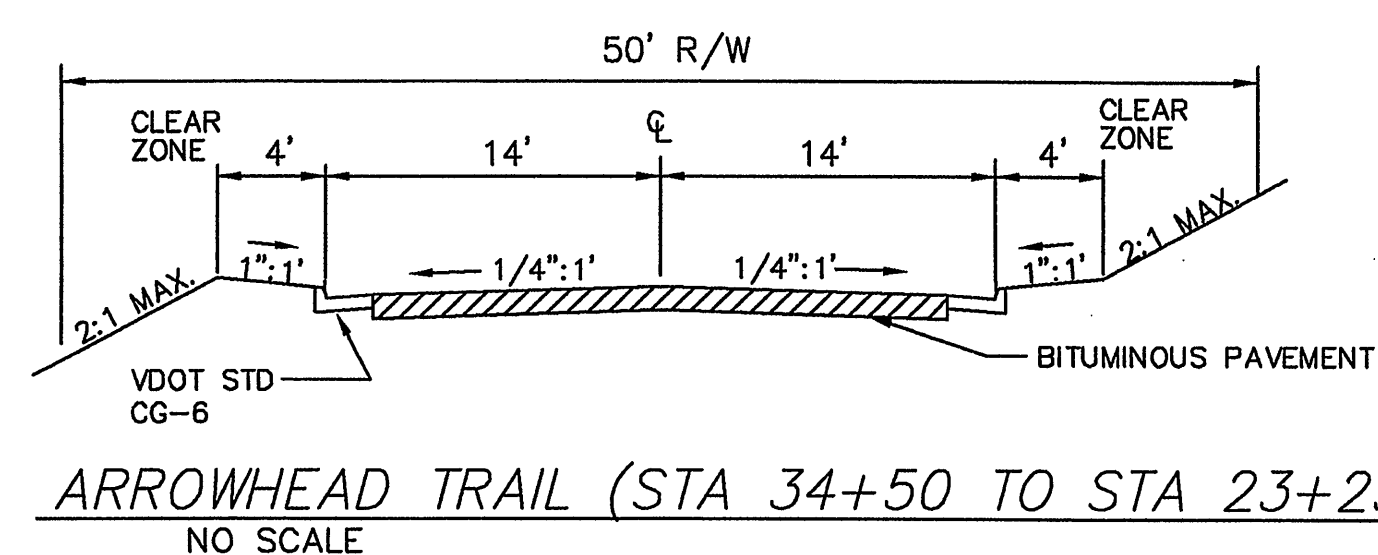
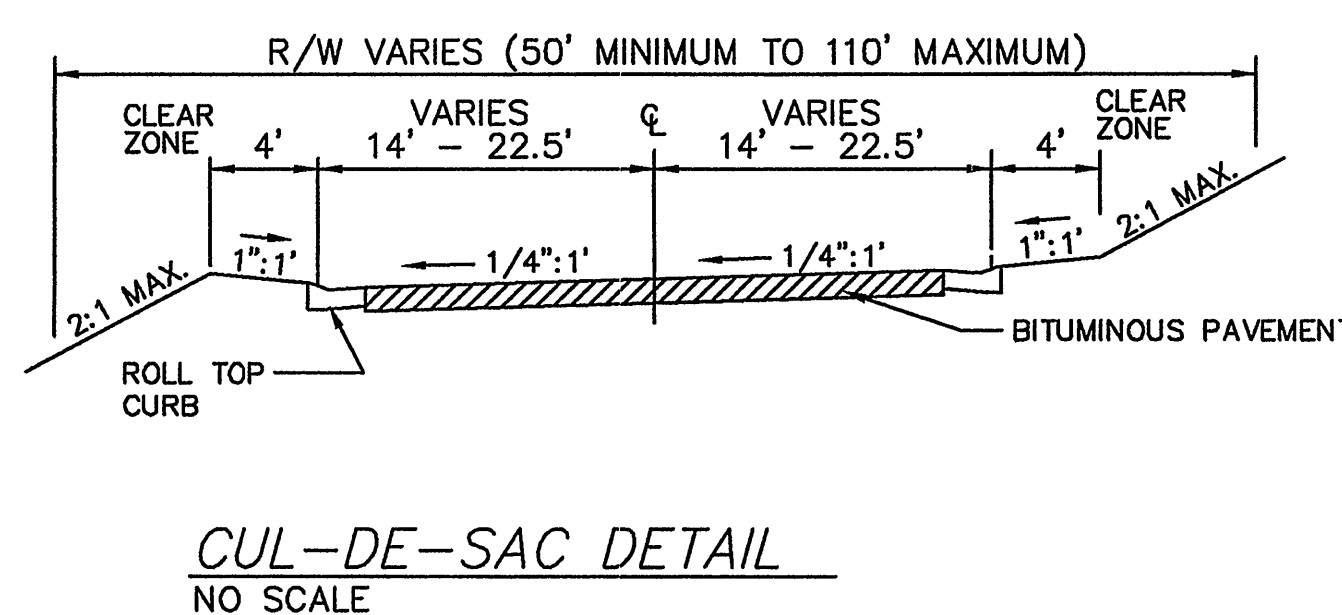


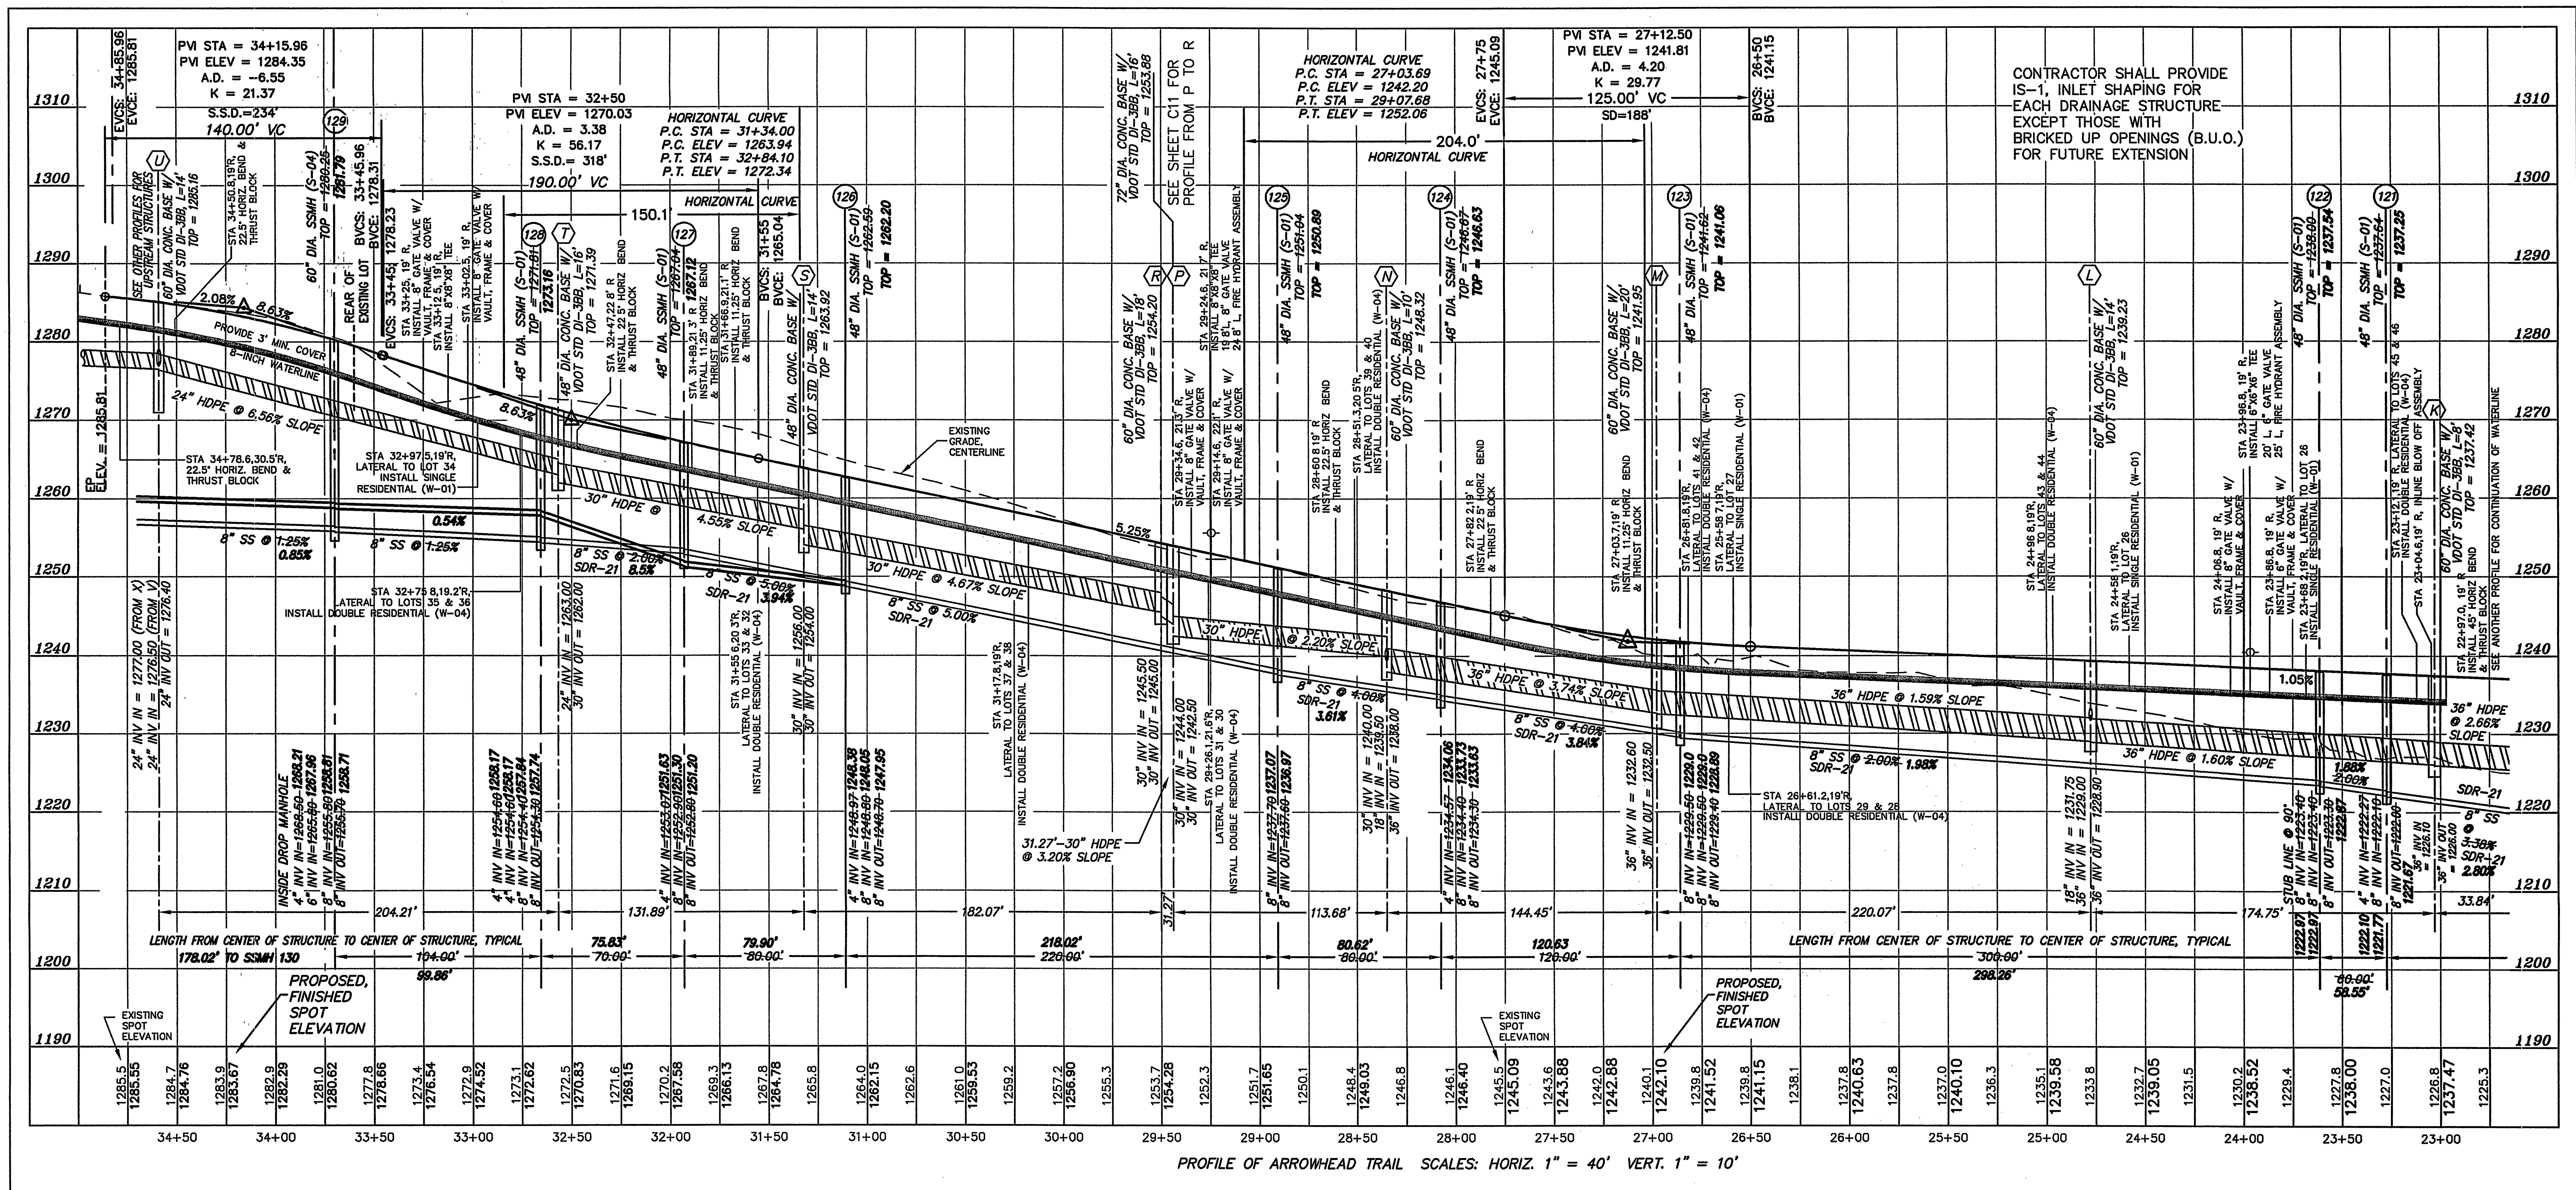

REVISED APRIL 12, 2006:
AS-BUILT PLANS FOR WATER AND SANITARY SEWER ONLY.
MANHOLE TOPS WERE LOCATED. INVERT INFORMATION WAS
PROVIDED BY THE CONTRACTOR. WATERLINE INFORMATION
WAS BASED ON CONTRACTOR MARK UPS.

WWW.ID# 60QHKB

DESIGNED BY P.J. BROWN
DRAWN BY P.J.B.
CHECKED BY P.J.B.
W.O. # 04-0071
N.B. JR-246
TAX NO. PORTION 054.04-05-01

PROFILES - ARROWHEAD TRAIL
FOR
SECTION 4, CHEROKEE HILLS
SITUATE ARROWHEAD TRAIL
CATAWBA MAGISTERIAL DISTRICT
ROANOKE COUNTY, VIRGINIA

REVISED: 06 JULY 2005 SCALE: 1" = 40'

T. P. PARKER & SON
816 Boulevard
Post Office Box 39
Salom, Virginia 24153
Telephone: 540-387-1153
FAX: 540-388-5767
04-0071-DESIGN-6.DWG