


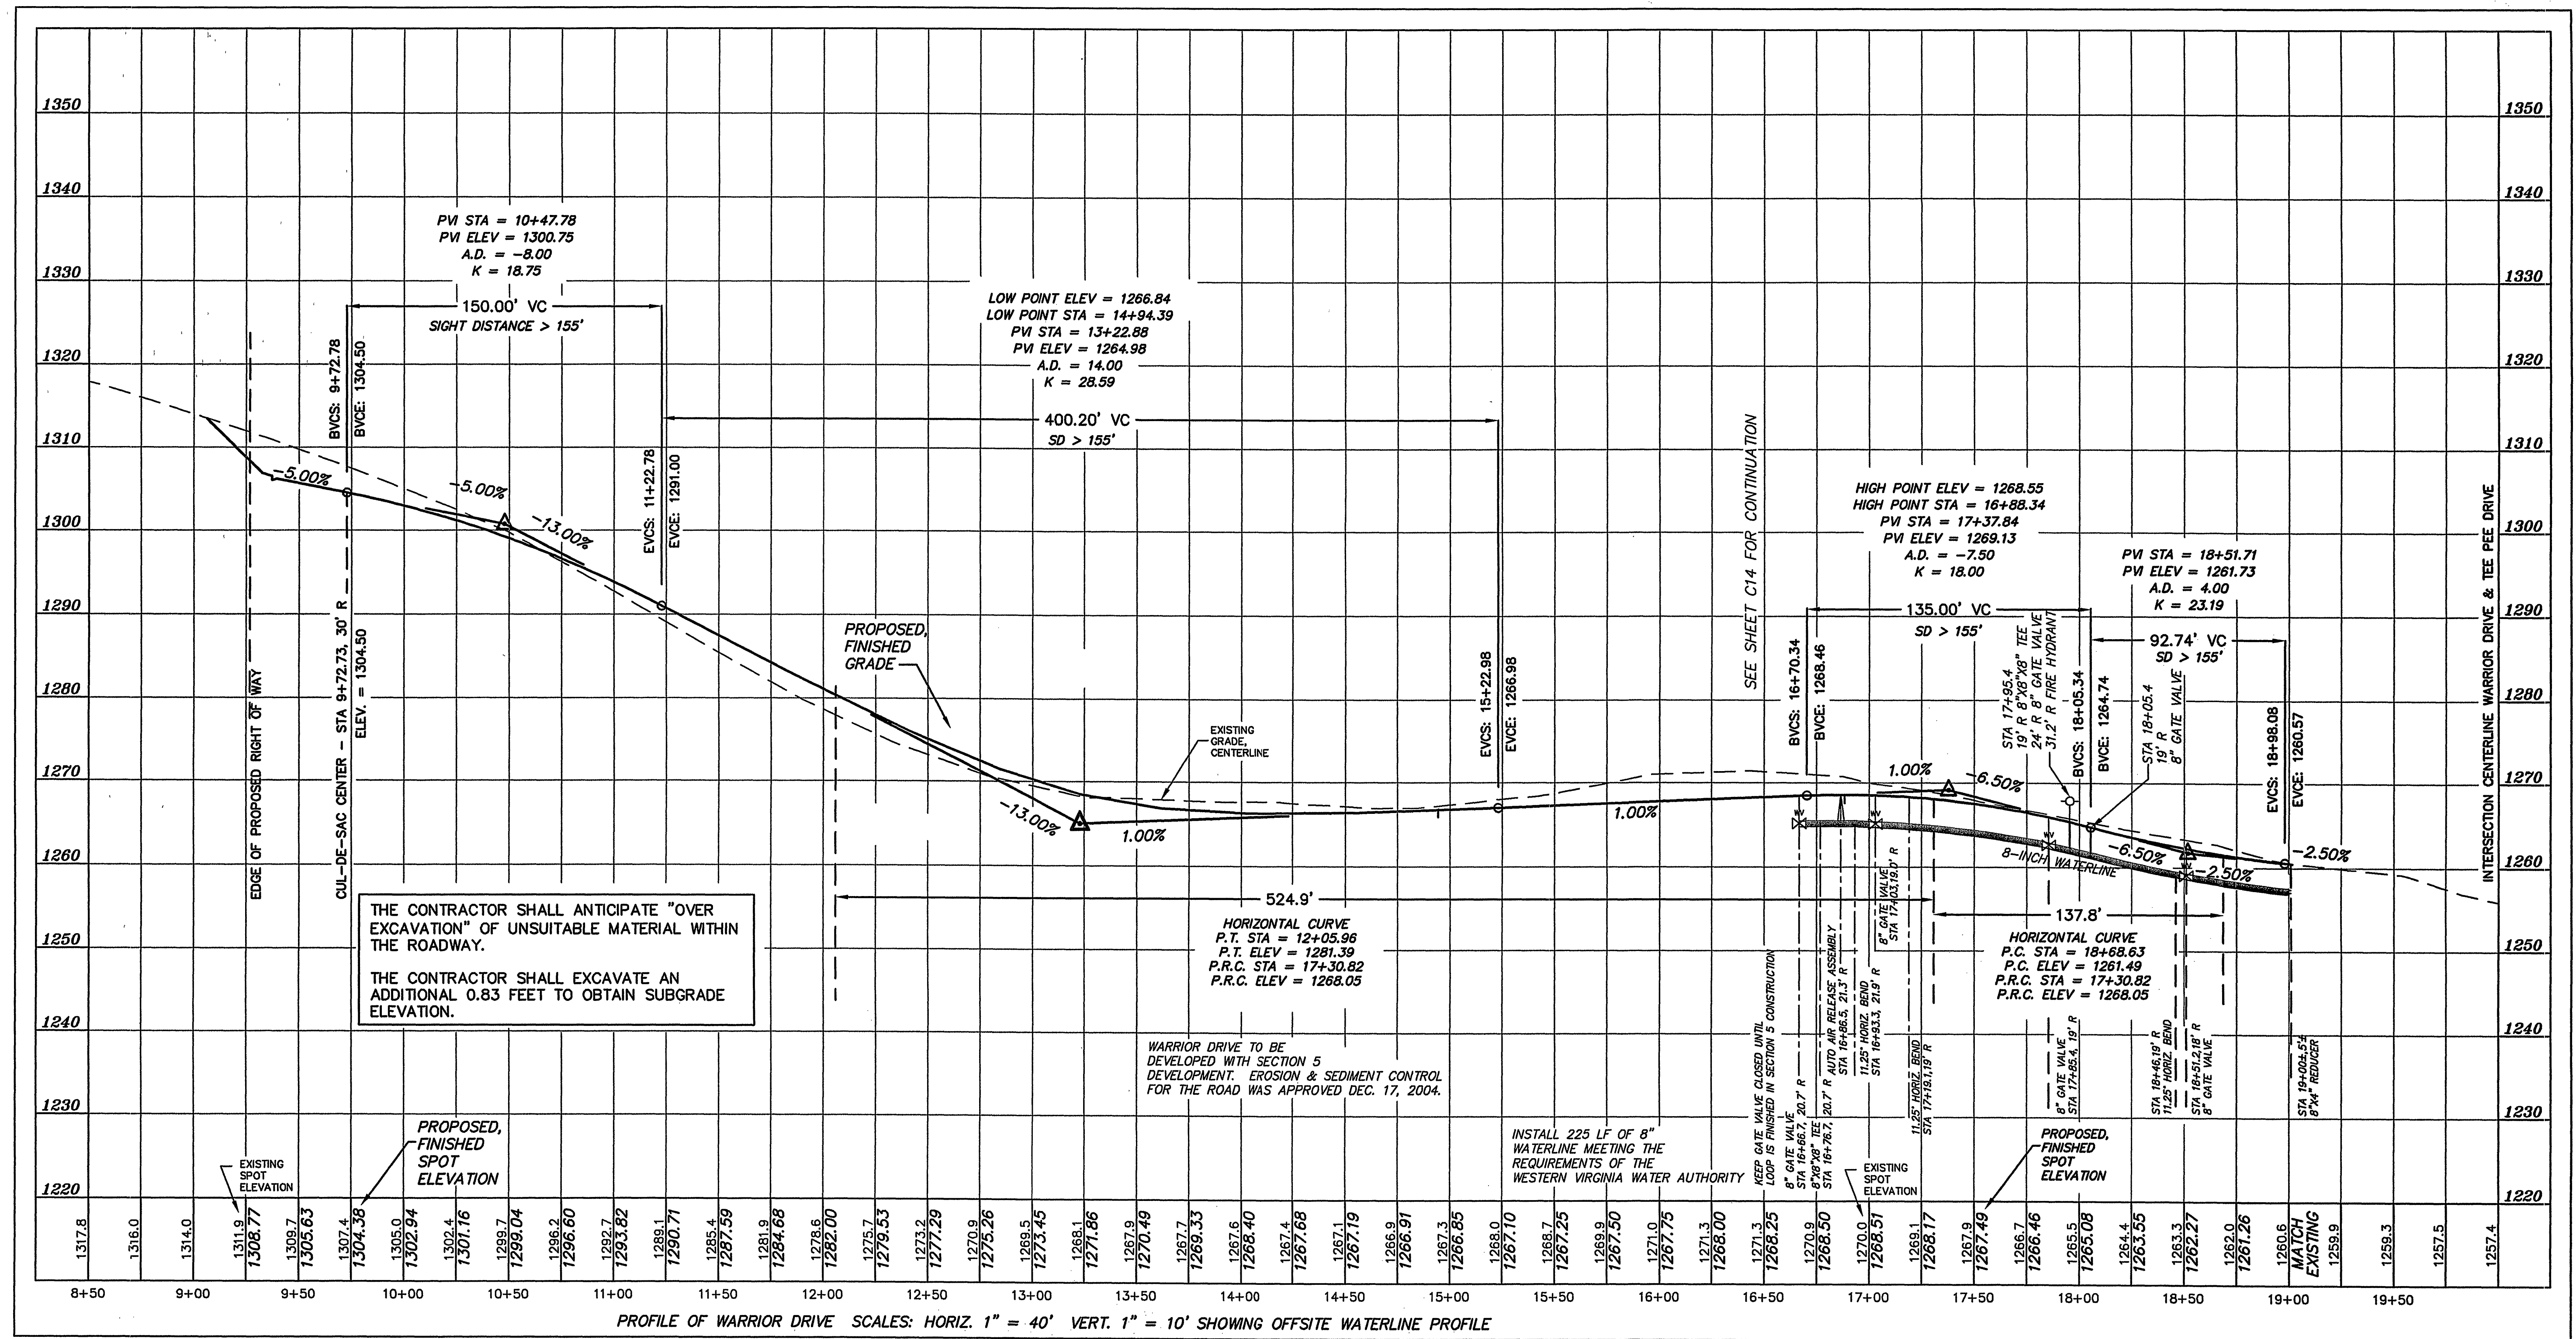
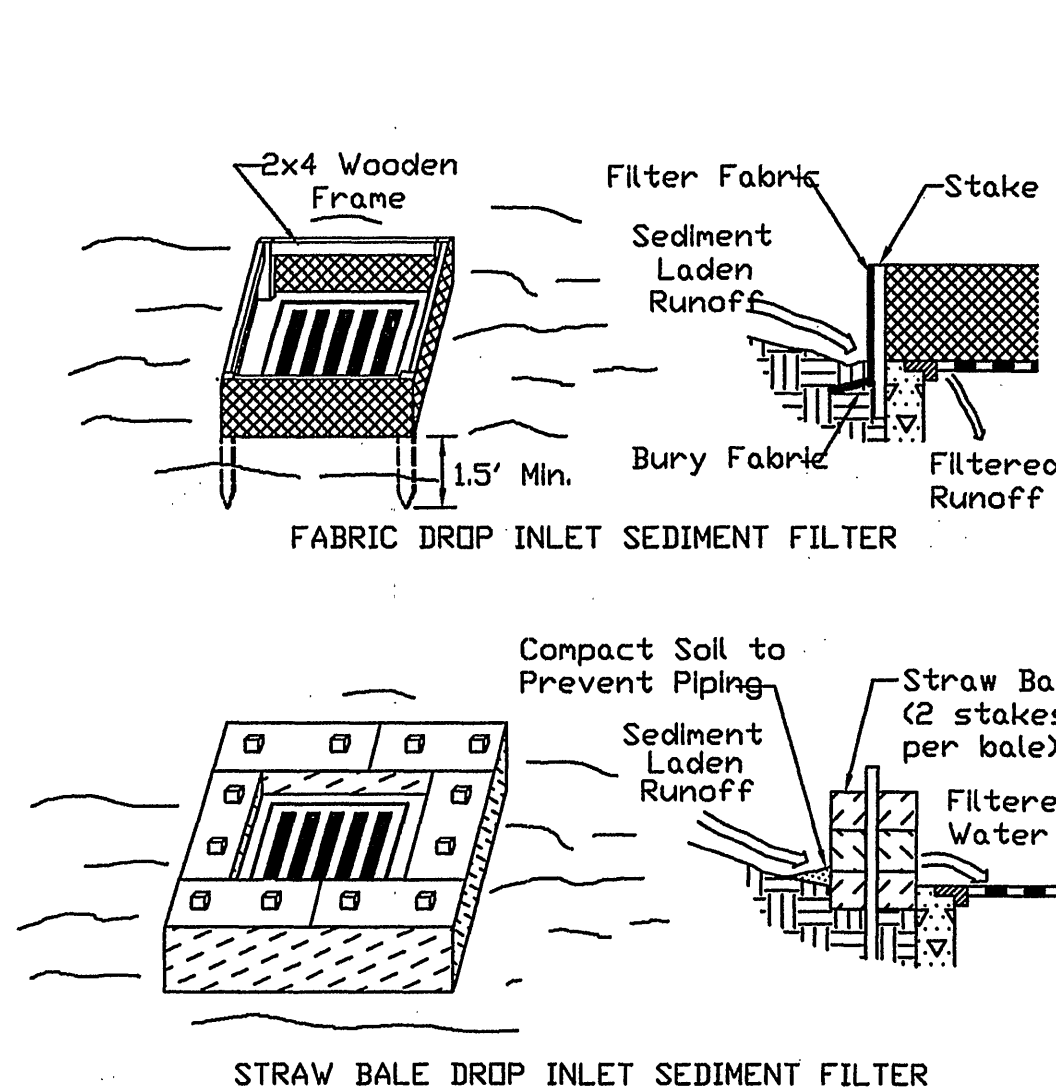
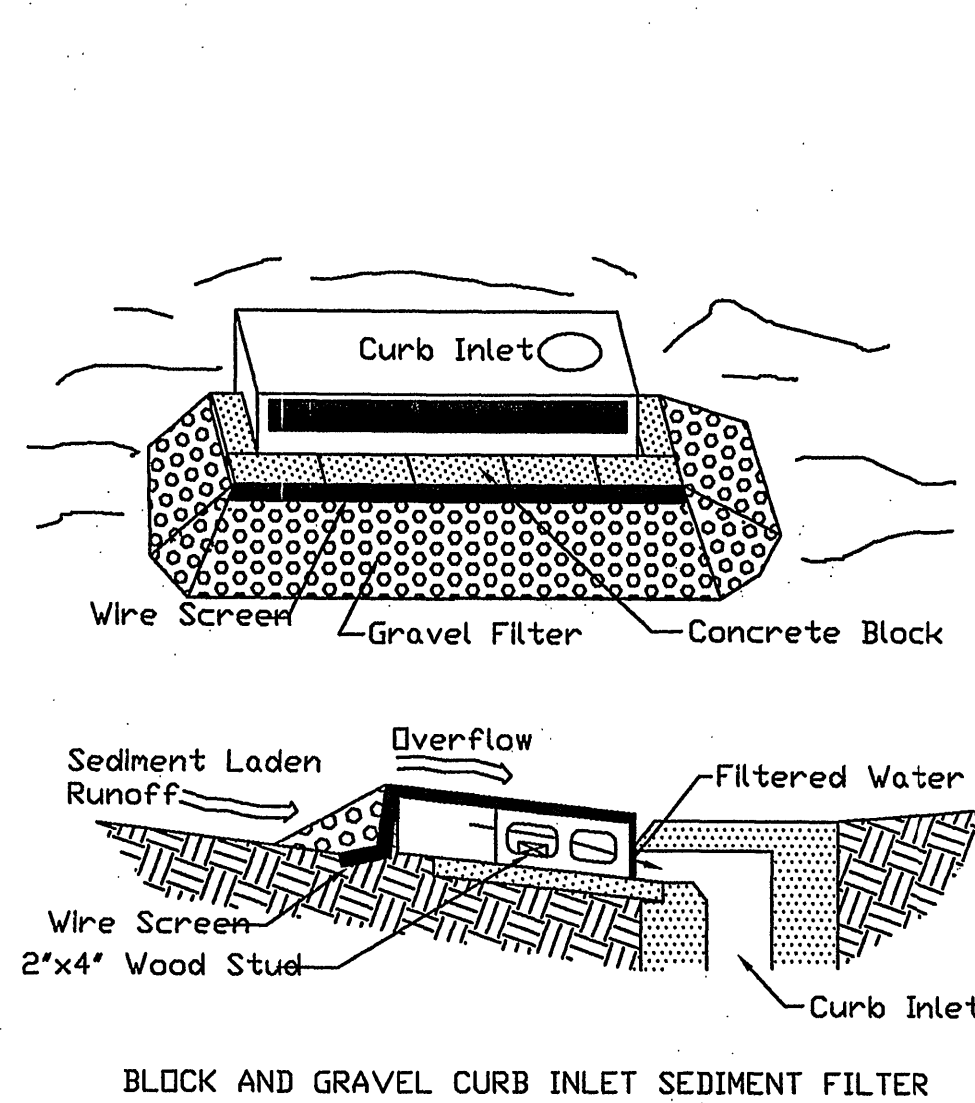


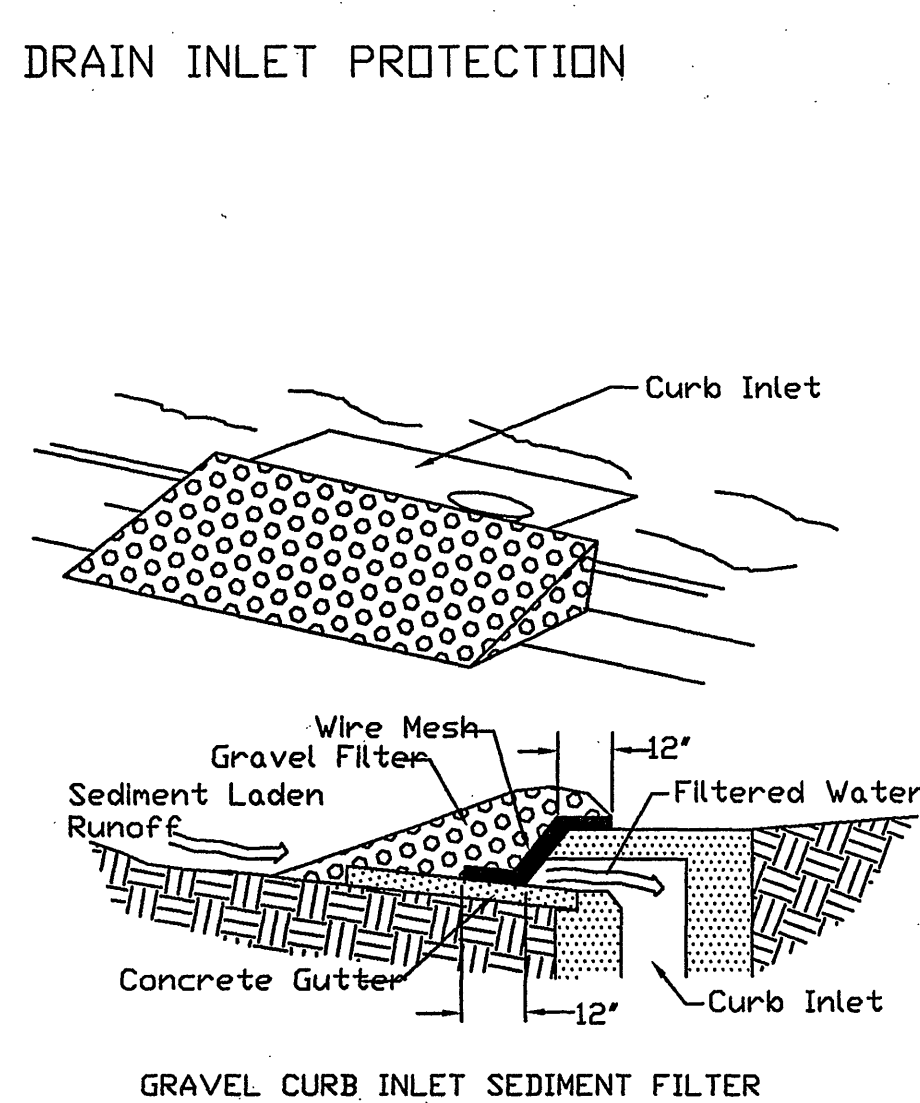

INLET PROTECTION DETAILS AS MENTIONED ON SHEET C11 "EROSION & SEDIMENT CONTROL NARRATIVE & DETAILS"

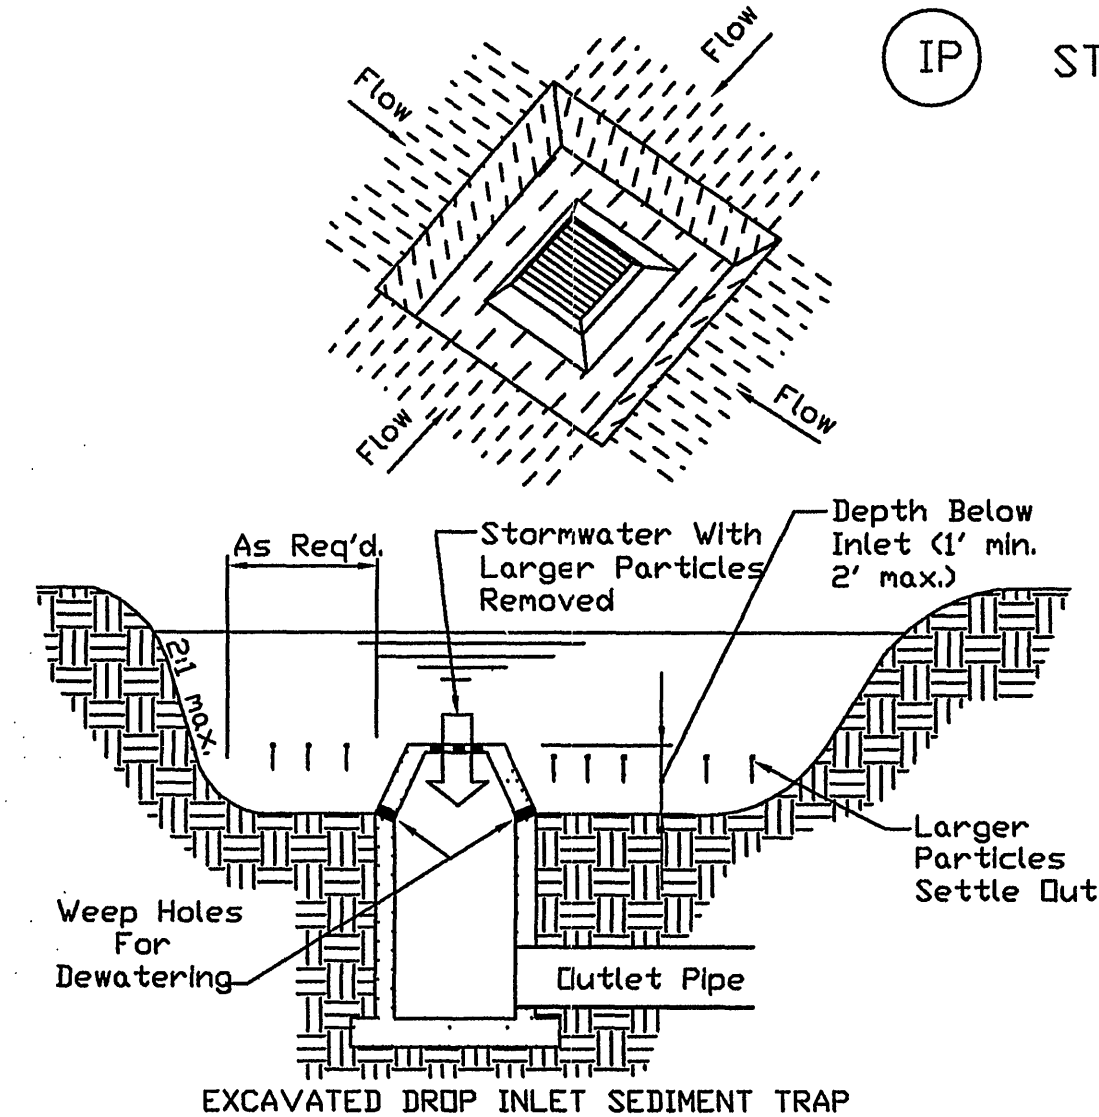

REVISED APRIL 12, 2006:
AS-BUILT PLANS FOR WATER AND SANITARY SEWER ONLY.
MANHOLE TOPS WERE LOCATED. INVERT INFORMATION WAS
PROVIDED BY THE CONTRACTOR. WATERLINE INFORMATION
WAS BASED ON CONTRACTOR MARK UPS.

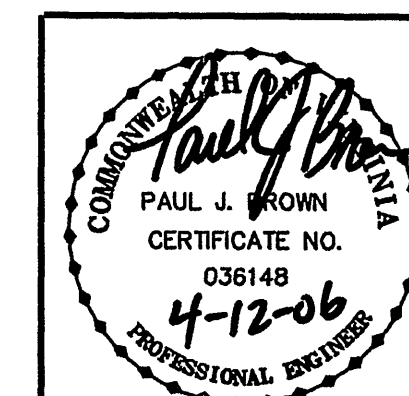

DESIGNED BY P.J. BROWN
DRAWN BY P.J.B.
CHECKED BY P.J.B.
W.O. # 04-0071
N.B. 18-248
PORTION 054.04-05-01
TAX NO.

OFFSITE WATERLINE PROFILE
& FUTURE ROADWAY LAYOUT
FOR
SECTION 5, CHEROKEE HILLS
SITUATE WARRIOR DRIVE
CATAWBA MAGISTERIAL DISTRICT
ROANOKE COUNTY, VIRGINIA
REVISED: 19 MAY 2005 SCALE: 1" = 40'
T. P. PARKER & SON
816 Boulevard
Post Office Box 39
Salem, Virginia 24153
Telephone: 540-387-1153
FAX: 540-389-8787
04-0071-DESIGN-6.DWG

WWW.ID# 6QGH8