

Section 5, Cherokee Hills
ASBUILT SURVEY OF
for WESTERN VIRGINIA WATER AUTHORITY
Catawba Magisterial District
Roanoke County, Virginia

REVISIONS:

Address Review Comment
PJB 02/07/0
Address Review Comment
PJB 04/16/0
Plan Revision #1 Per County Meeting
SRB 09/17/1
Plan Revision #1 - 2nd Submittal
SRB 10/10/1
Plan Revision #
SRB 03/22/1

Water & Sewer Asbuilts
04/01/2020

DESIGNED BY: PJR

RAWN BY: PJB/JPA/BDP

CHECKED BY: SLR/REC/MAC

SCALE: 1" = 40'

ATF: 26 MARCH 2021

SHEET TITLE:

ROAD PROFILE

ellett








1

[illegible]


2 OF 3

PROJECT NUMBER:

18-0131

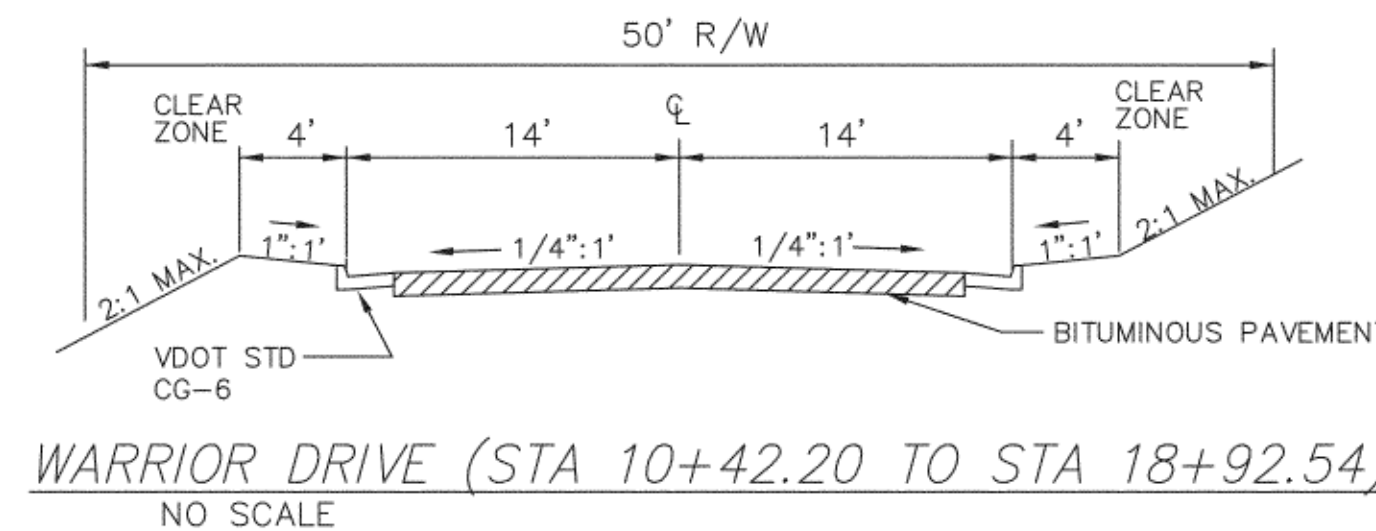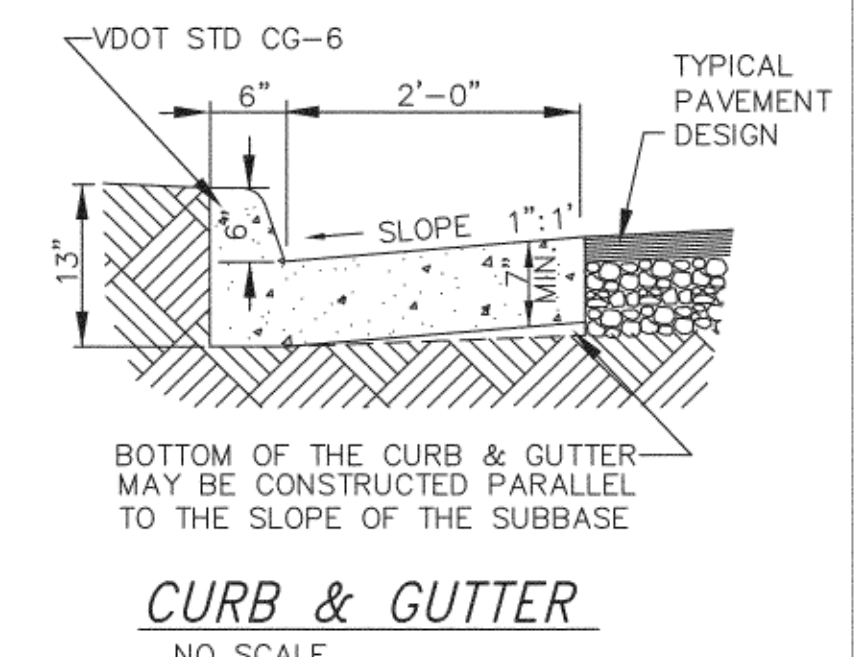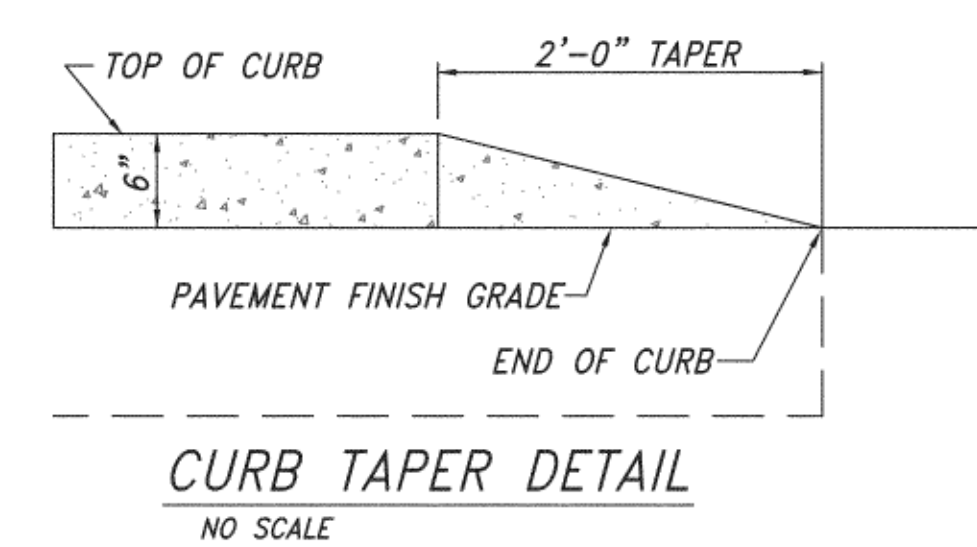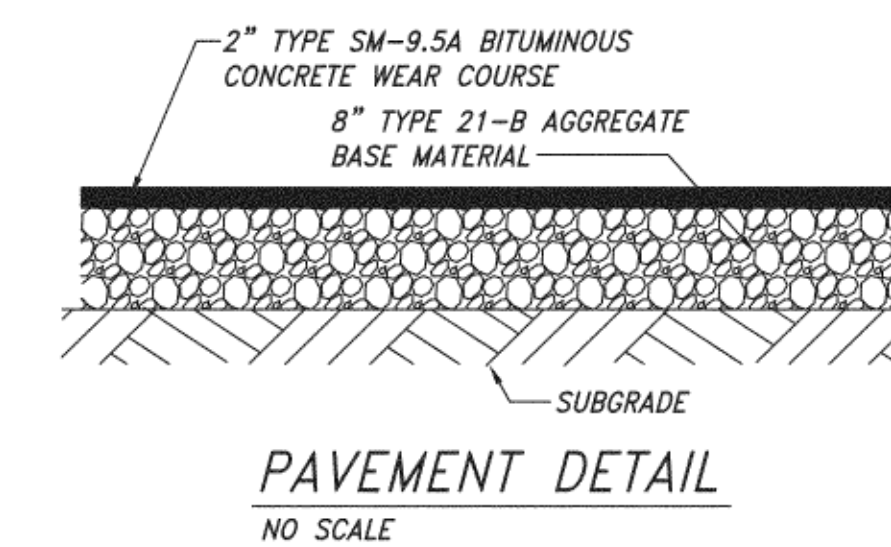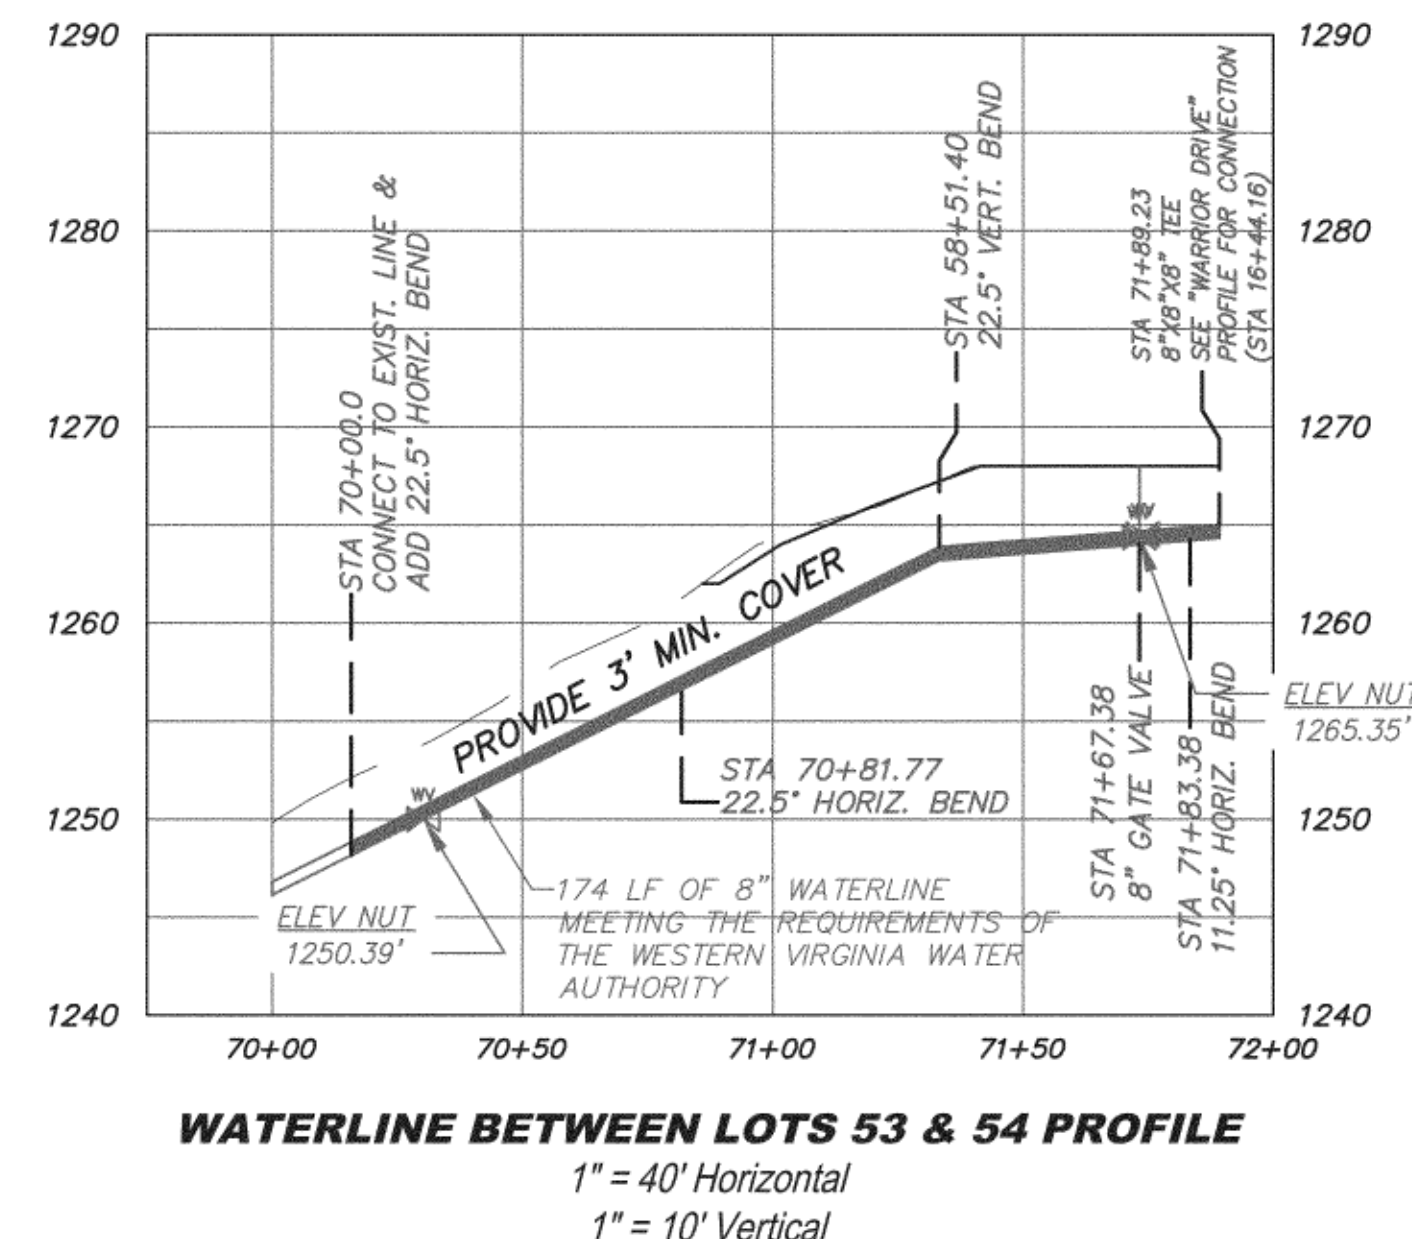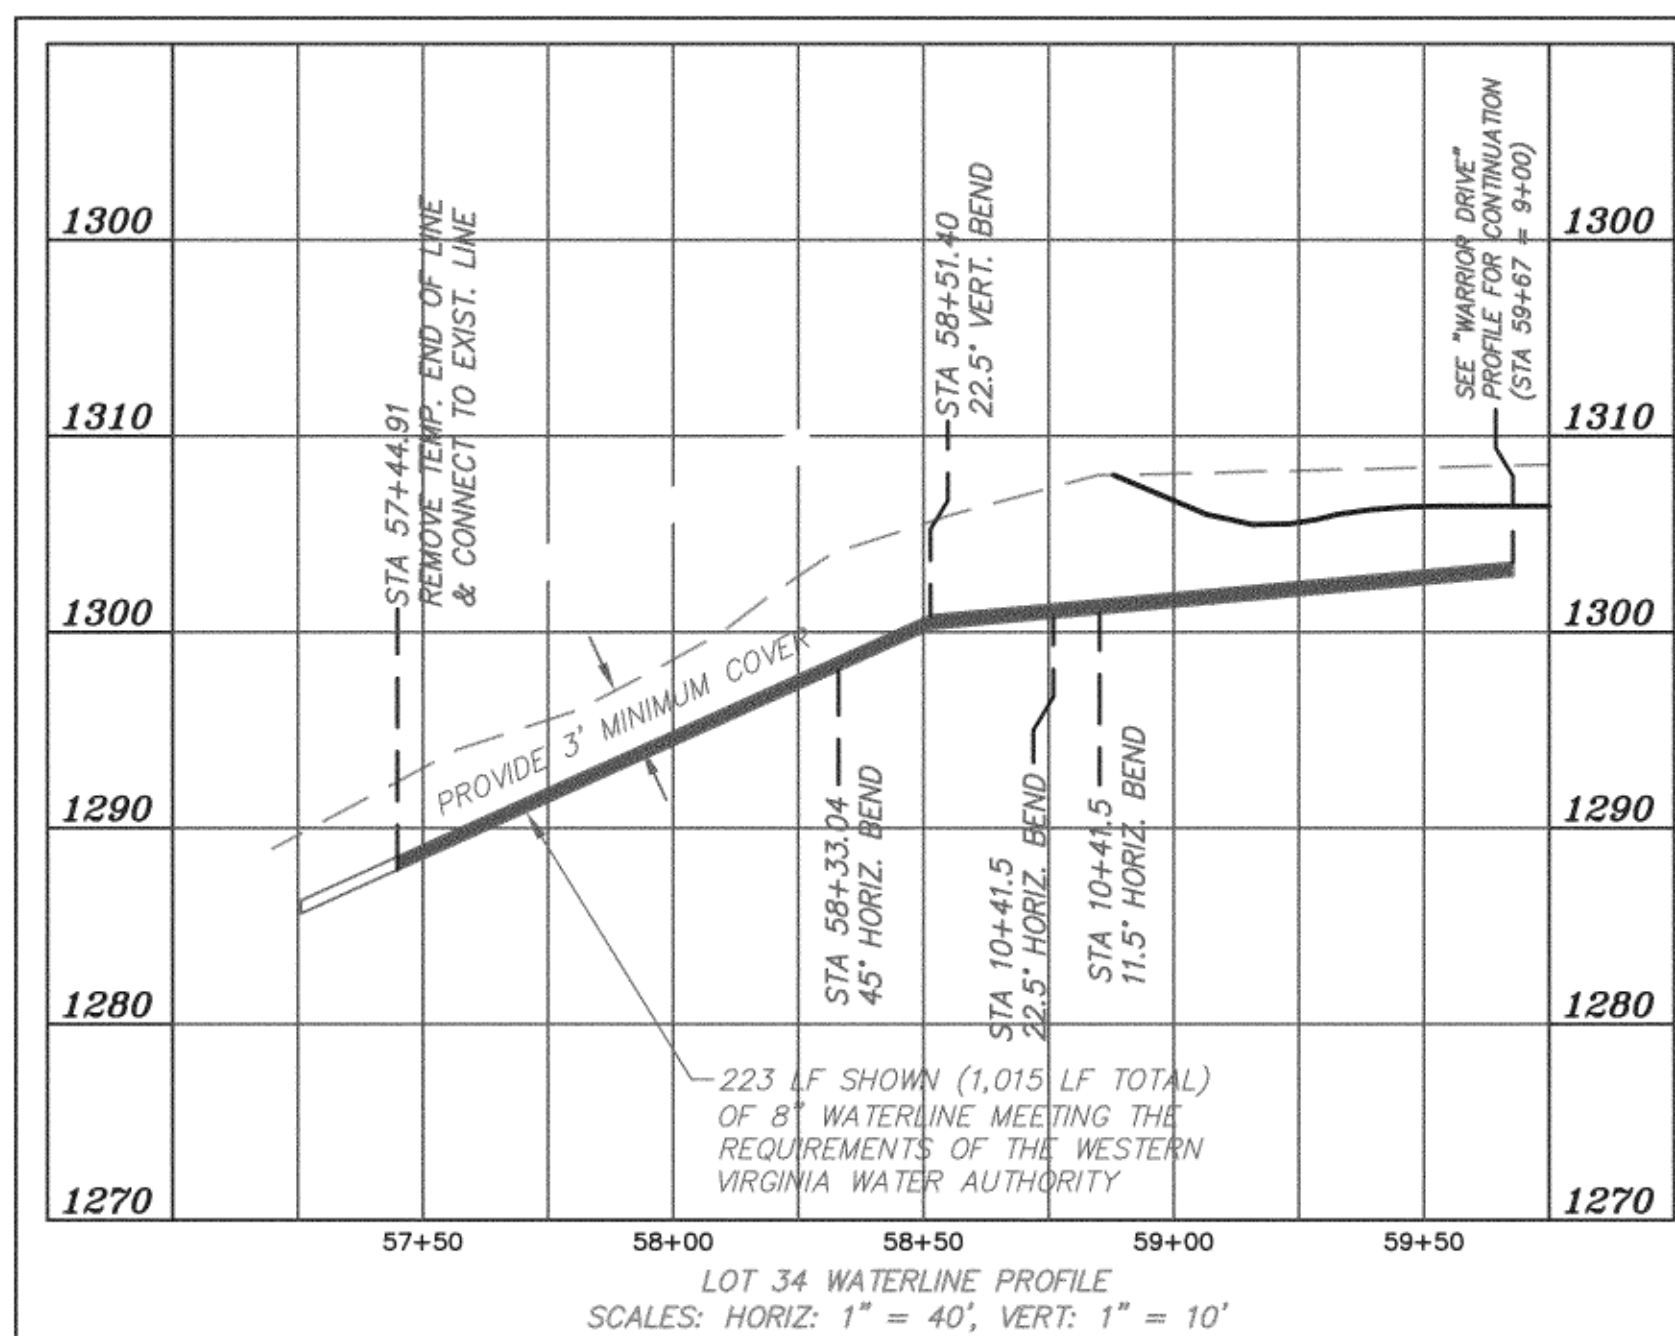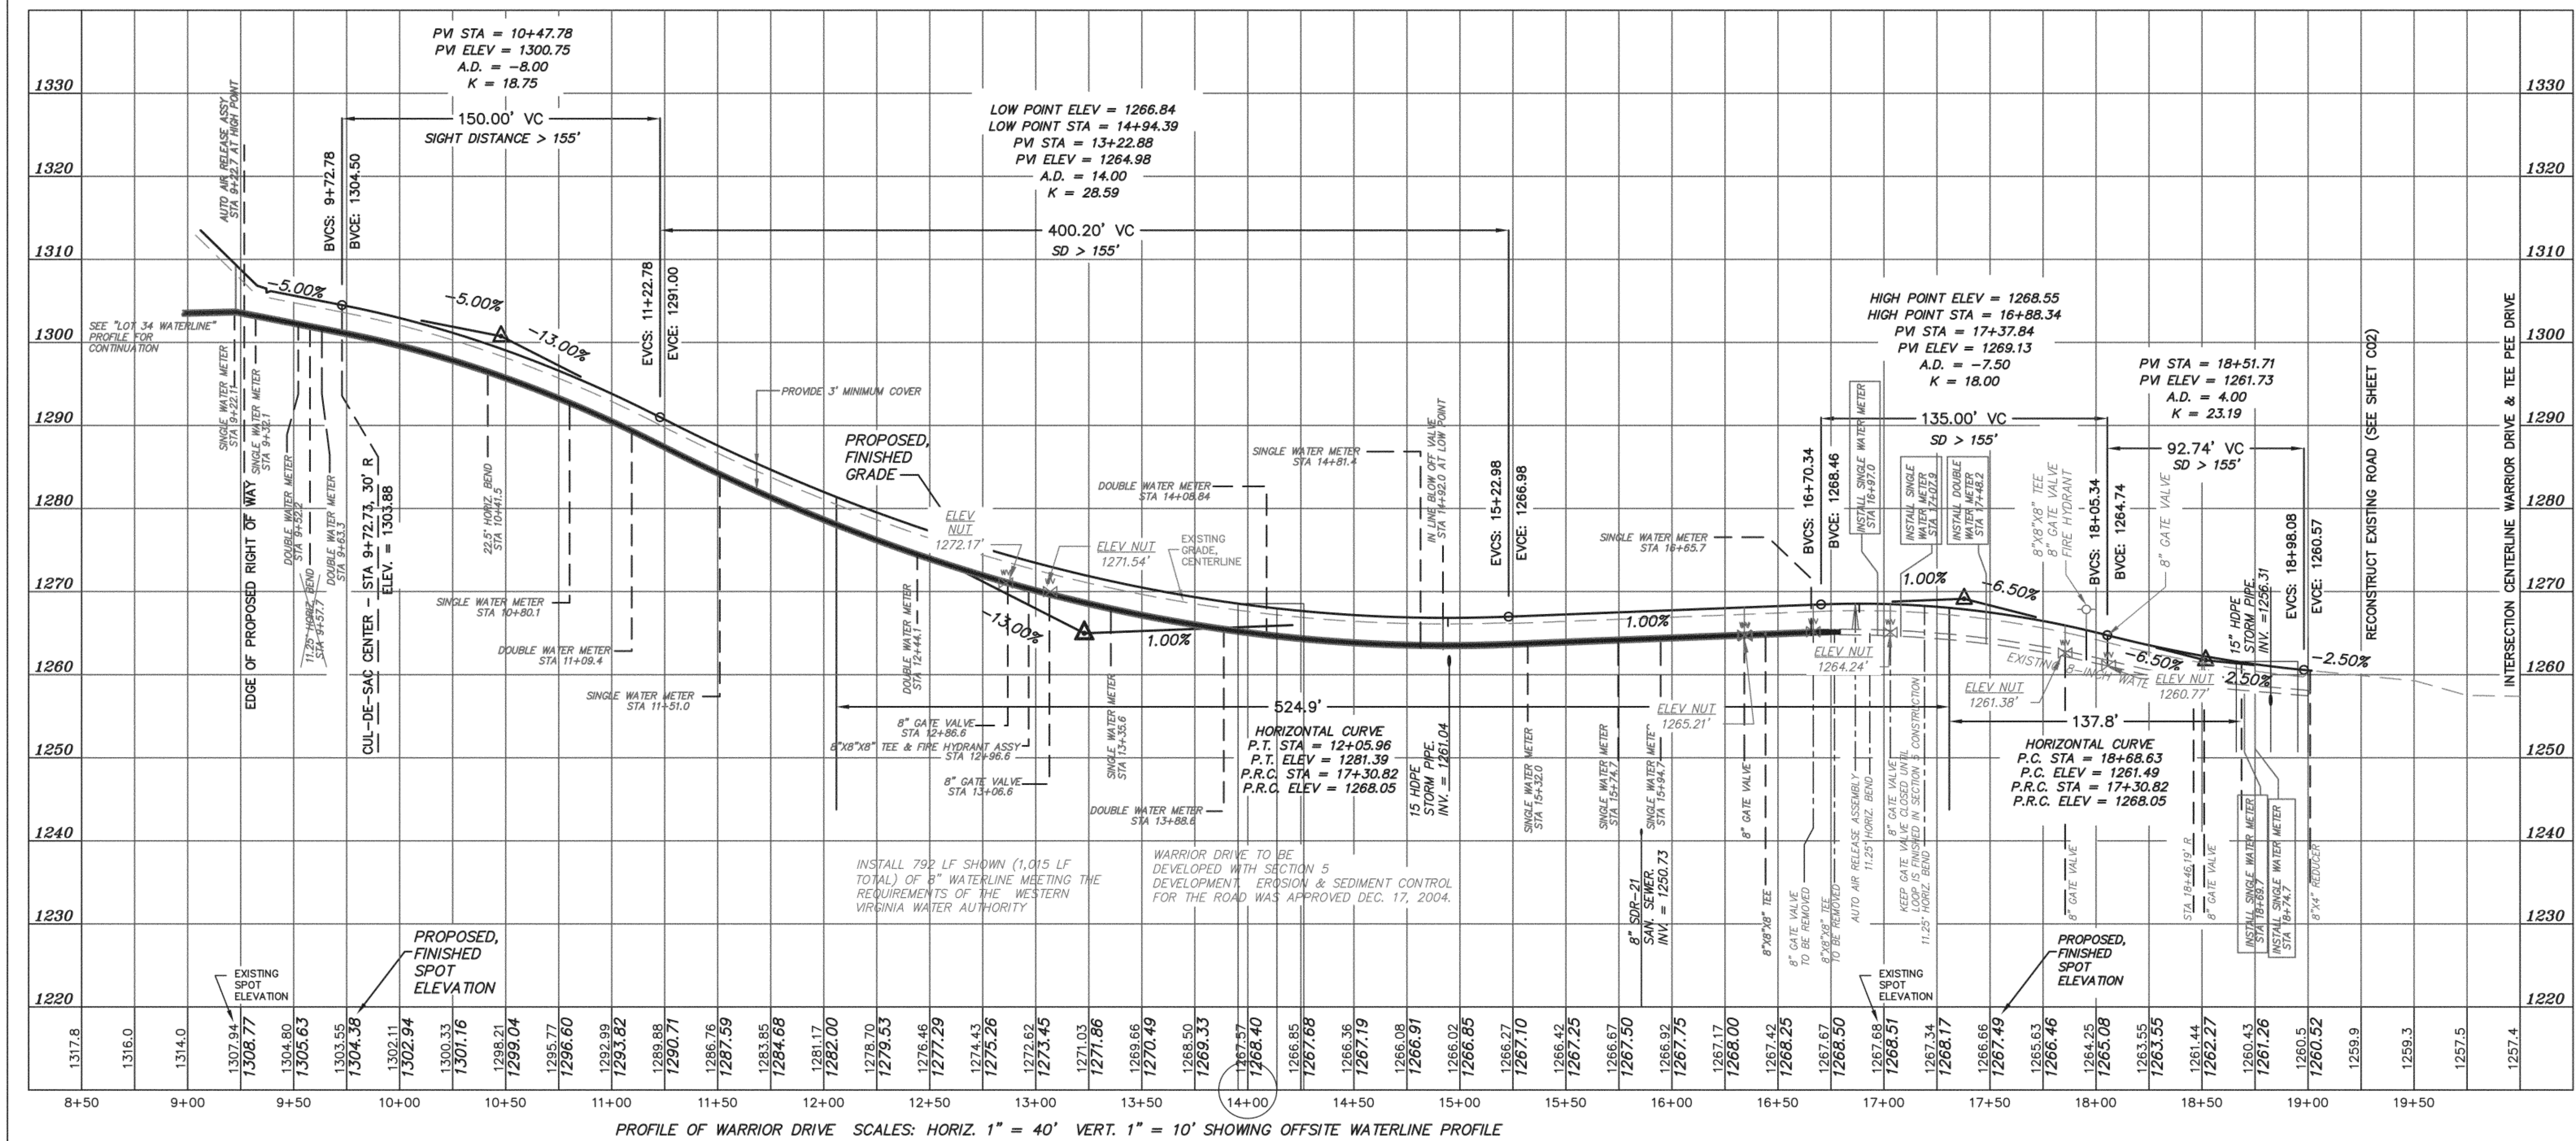

TRANSITION NOTE TO EXISTING PAVEMENT: LEFT PAVEMENT EDGE MAINTAINS THE EXISTING EP, WHICH REDUCES IN WIDTH FROM 12' WIDE TO 10' WIDE. ADDITIONAL PAVEMENT IS PLACED ON THE RIGHT PAVEMENT EDGE WHICH REDUCES IN WIDTH FROM 12' TO 11.4'. TRANSITION TO OCCUR FROM STA 18+92.54 TO STA 19+34.97. THE PROPOSED EDGE OF PAVEMENT SHALL MATCH EXISTING PAVEMENT AT STA 19+34.97. (SEE SHEET C02)

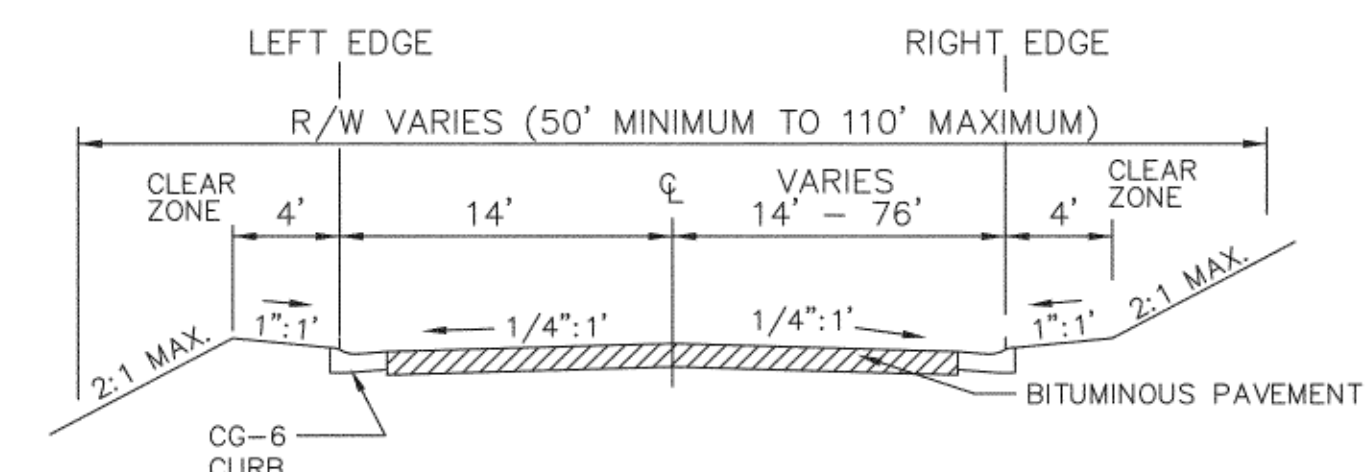

CUL-DE-SAC DETAIL (STA 9+38.57 TO STA 10+42.20)
NO SCALE

ROAD ALIGNMENT REMAINS THE CROWN OF THE ROAD. THE CUL-DE-SAC CENTER IS LOWER THAN THE ROAD ALIGNMENT POINT. THE CUL-DE-SAC HAS AN EFFECTIVE SLOPE OF 5% OR LESS IN ALL DIRECTIONS.