

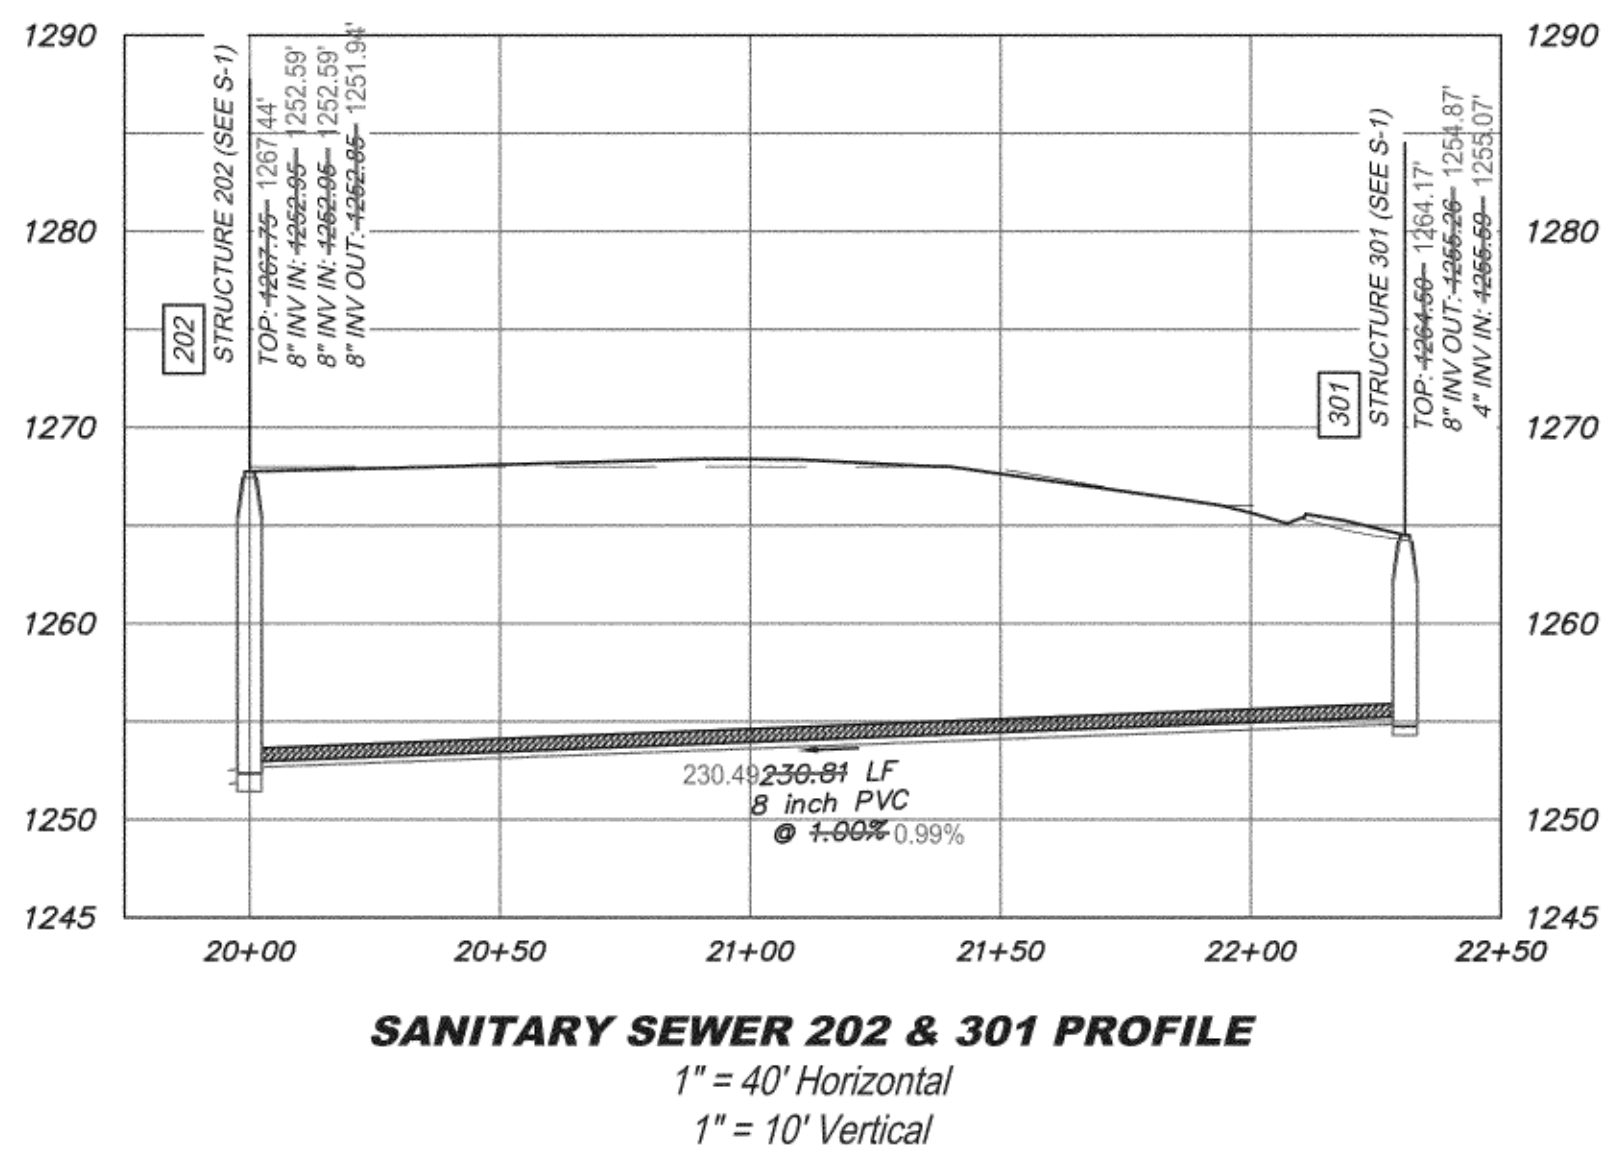


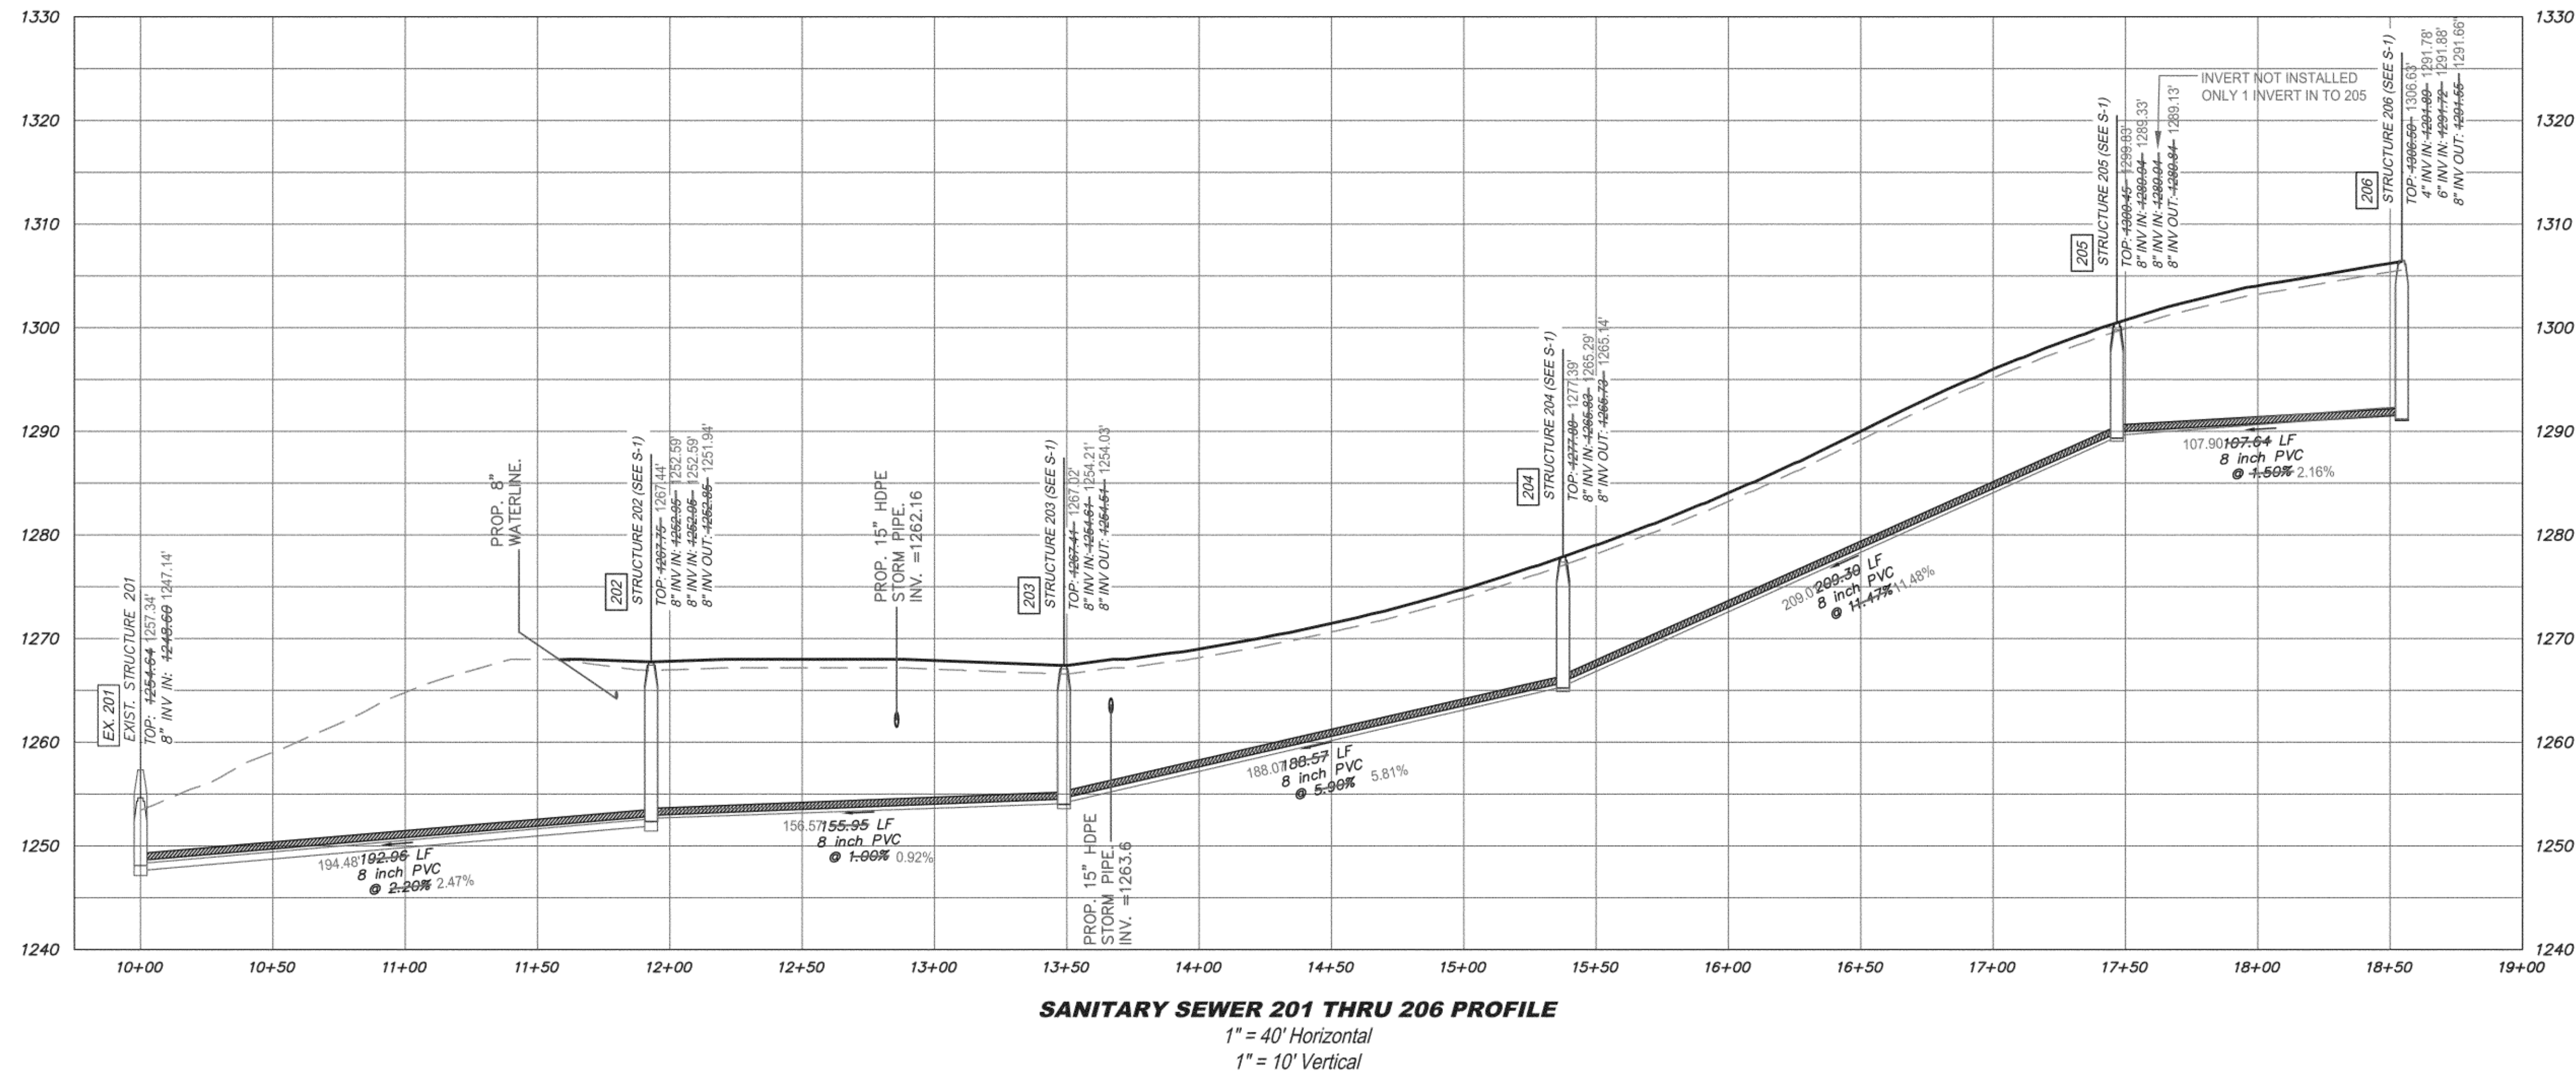

MINIMUM GRAVITY SANITARY SEWER SERVICE CHART						
Lot No.	Main Alignment Station at Lateral Connection	Proposed Road CL Elev.	Proposed Living Level	Proposed Basement Level -10	Design C.O. Elev @ Easement	Lowest San. Sewer Inv. At House
1	22+31	1264.5	1263.9	1253.9	1253.8	1256.4
2	21+78	1269.5	1268.8	1258.8	1255.1	1255.8
3	21+02	1268.4	1269.0	1259.0	1254.5	1255.2
4	20+19	1268.2	1269.5	1259.5	1253.9	1254.6
5	20+19	1267.6	1269.6	1259.6	1253.9	1254.6
6	13+17	1266.9	1269.4	1259.4	1254.9	1255.5
7	13+17	1267.6	1269.4	1259.4	1254.9	1255.5
8	14+59	1269.7	1272.7	1262.7	1262.1	1262.7
9	14+59	1276.0	1279.8	1269.8	1262.1	1262.7
10	16+03	1282.6	1285.8	1275.8	1274.5	1275.1
11	16+03	1291.4	1296.1	1286.1	1274.5	1275.1
12	16+89	1299.0	1301.5	1291.5	1284.5	1285.1
13	17+59	1304.2	1305.8	1295.8	1290.1	1290.7
14	18+54	1305.8	1308.1	1298.1	1291.9	1292.5
15	18+54	1306.5	1309.1	1299.1	1291.9	1292.5
16	18+54	1305.5	1306.1	1296.1	1293.0	1293.6
17	17+52	1303.5	1305.1	1295.1	1290.0	1290.7
18	16+80	1297.6	1300.1	1290.1	1283.4	1284.1
19	16+18	1290.8	1292.1	1282.1	1276.4	1277.1
20	15+57	1282.6	1285.3	1275.3	1269.3	1269.9
21	14+99	1277.3	1279.3	1269.3	1264.4	1265.0
22	14+34	1272.8	1275.0	1265.0	1260.6	1261.3
23	13+82	1269.7	1272.0	1262.0	1257.5	1258.1
50	13+08	1267.8	1270.5	1260.5	1254.8	1255.5
51	13+08	1266.9	1270.5	1260.5	1254.8	1255.5
52	10+33	1267.2	1269.5	1259.5	1249.7	1250.9
53	10+33	1267.8	1269.5	1259.5	1249.7	1250.9
54	20+65	1268.3	1269.5	1259.5	1254.2	1254.9
55	21+32	1268.0	1269.0	1259.0	1254.7	1255.3
56	22+12	1264.1	1265.8	1255.8	1256.5	1257.2

REPRESENTS LOTS THAT MAY REQUIRE A SANITARY LIFT SYSTEM IF THE BASEMENT HAS SERVICE.

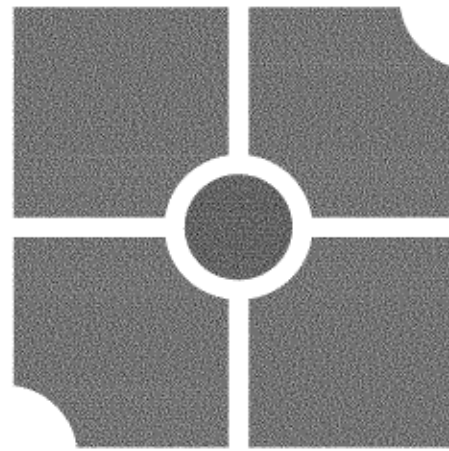

parker
DESIGN GROUP
ENGINEERS • SURVEYORS • PLANNERS • LANDSCAPE ARCHITECTS

2122 Carolina Ave, SW Roanoke, VA 24014
1915-B W. Cary Street Richmond, VA 23220
Ph: 540-387-1153 Phone: 804-358-2947
Fax: 540-389-5767 Fax: 804-359-9645
www.parkerdg.com

These documents are the property of Parker Design Group (PDG) and may not be reproduced or used without the express permission of PDG. Any reuse of these documents without authorization of PDG will be at the sole risk of the individual or entity utilizing said documents.



ASBUILT SURVEY OF
Section 5, Cherokee Hills
for WESTERN VIRGINIA WATER AUTHORITY
Catawba Magisterial District
Roanoke County, Virginia

REVISIONS:
Address Review Comments PJB 02/07/08
Address Review Comments PJB 04/18/08
Plan Revision #1 Per County Meeting SRB 09/17/18
Plan Revision #1 - 2nd Submittal SRB 10/10/18
Plan Revision #2 SRB 03/22/19
Water & Sewer Asbuilts 04/01/2020

DESIGNED BY: PJB
DRAWN BY: PJB/JPA/BDR
CHECKED BY: SLR/REC/MAC
SCALE: 1" = 40'
DATE: 26 MARCH, 2020

SHEET TITLE:
Sanitary Sewer Profiles

SHEET
3 OF 3
PROJECT NUMBER:
18-0131