


PROJECT LOCATION MAP

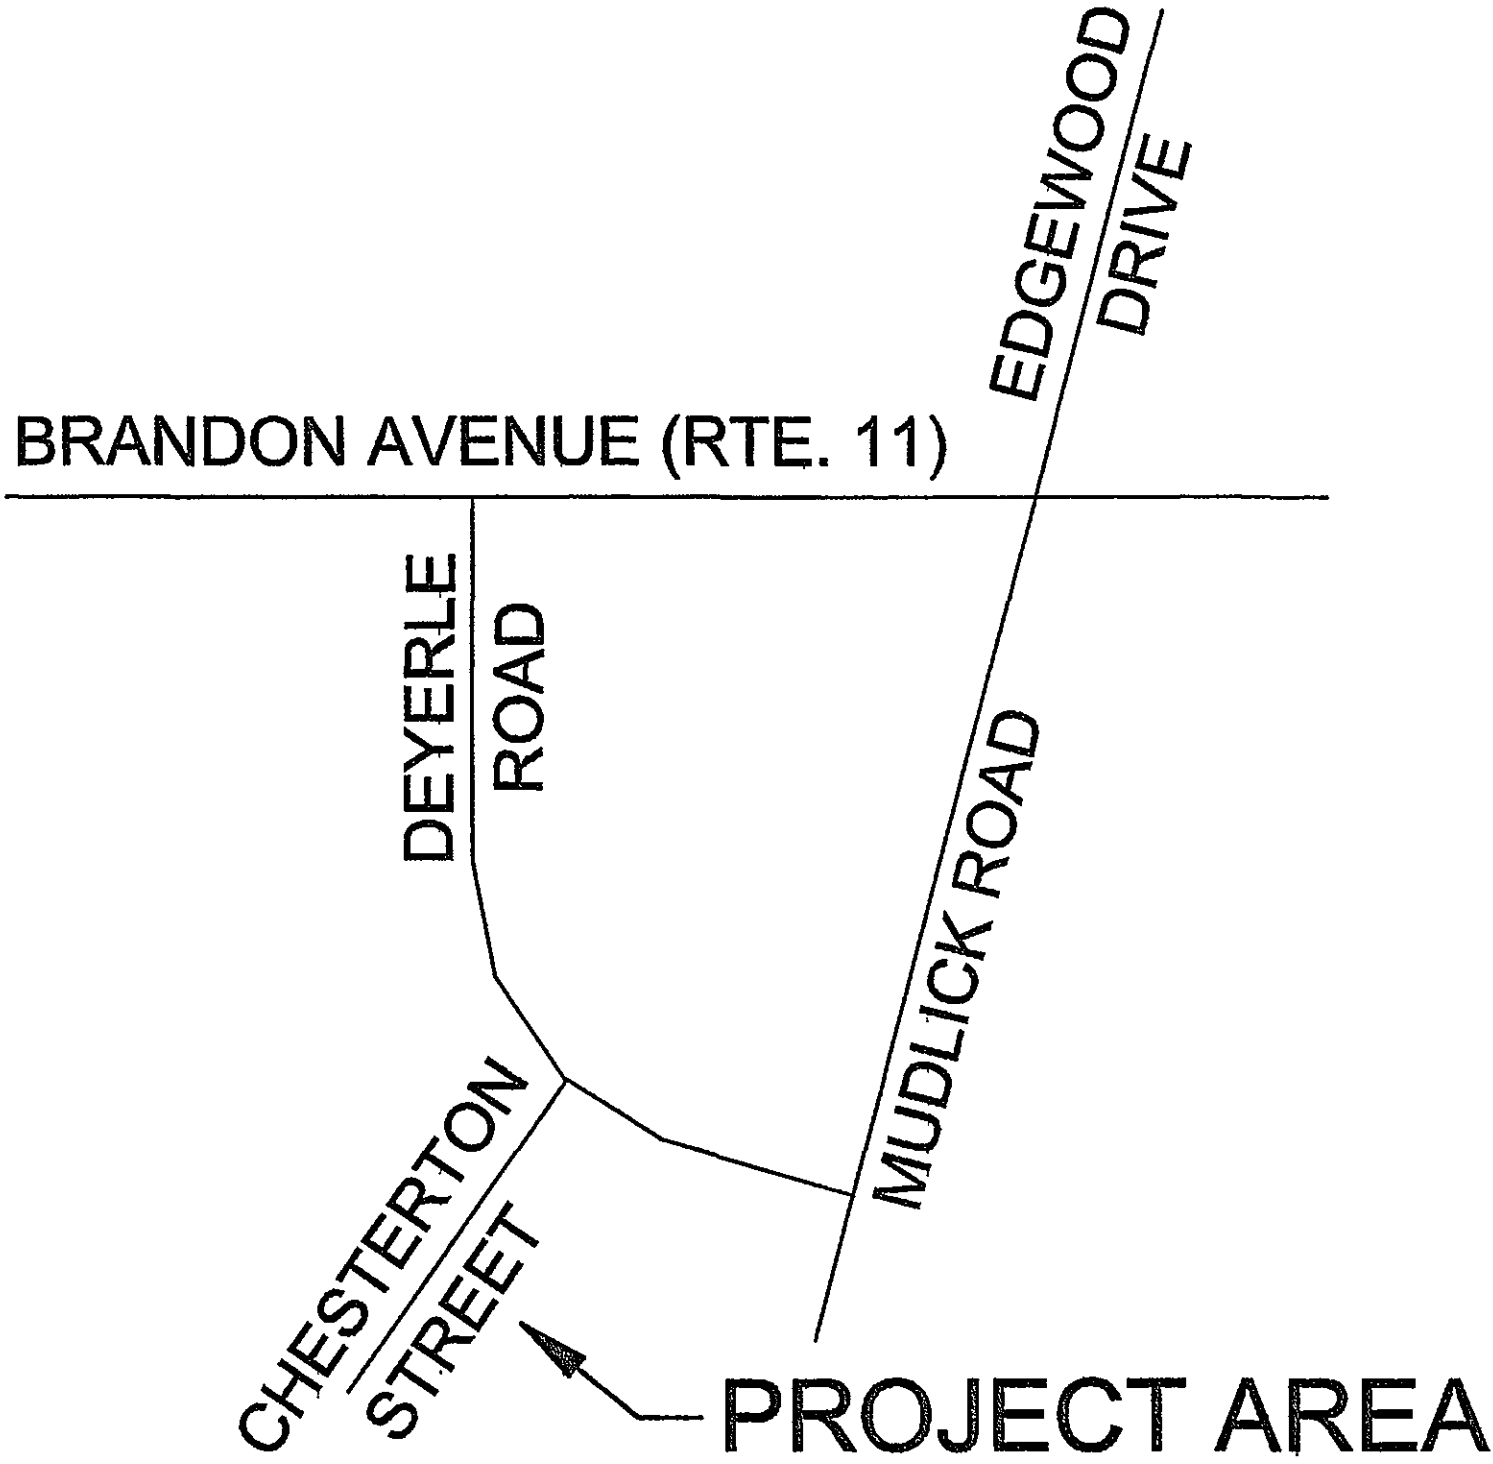

OFFICE OF CITY ENGINEER
ROOM 350
MUNICIPAL BUILDING
215 CHURCH AVENUE, S.W.
ROANOKE, VIRGINIA 24011



INDEX OF SHEETS

- SHEET #1 COVER
- SHEET #2 QUANTITIES
- SHEET #3 ABBREVIATIONS, LEGEND & GENERAL NOTES
- SHEET #4 PLAN & PROFILE
- SHEET #5 STANDARD DETAILS

CONSULTING ENGINEERS

LMW P.C.
ENGINEERING • ARCHITECTURE • SURVEYING
☎ (540) 345-0675 102 ALBEMARLE AVE., S.E.
FAX (540) 342-4456 ROANOKE, VIRGINIA 24013

COMMISSION NUMBER: 2039

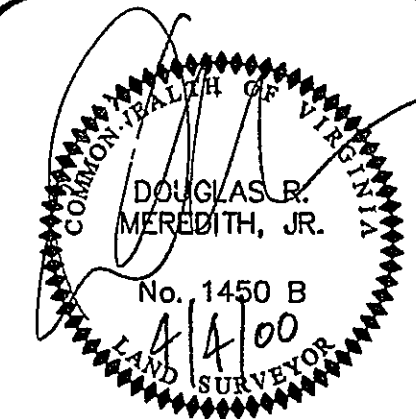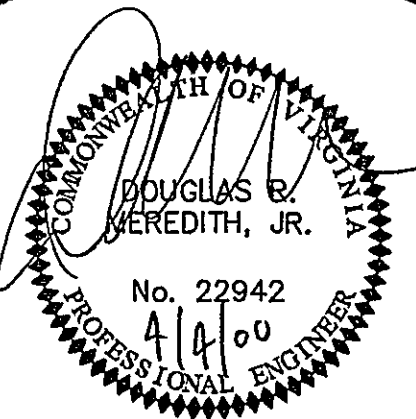

PROJECT NAME

CHESTERTON STREET SANITARY
SEWER REPLACEMENT PROJECT

PROJECT NUMBER: 6461

REVISION BY	DESCRIPTION:	DATE
REVISION BY	DESCRIPTION:	DATE
REVISION BY	DESCRIPTION:	DATE
REVISION BY	DESCRIPTION:	DATE

APPROVED FOR CONSTRUCTION

<i>Philip C. Edmister</i> ROANOKE CITY ENGINEER	<u>3-31-00</u> DATE
<i>Robert K. Benton</i> Acting DIRECTOR OF PUBLIC WORKS	<u>3-31-00</u> DATE
<i>Geoff B.</i> DIRECTOR OF UTILITIES AND OPERATIONS	<u>3/31/00</u> DATE
	DATE
	DATE

ADVERTISED DATE:

SET NUMBER:

SHEET NUMBER: 1 OF 5

"RECORD DRAWING"
Nov. 14, 2000