


PLAN	DATE	
	BY	
NOTE BOOK	NO.	


PROFILE	DATE	
	BY	
NOTE BOOK	NO.	

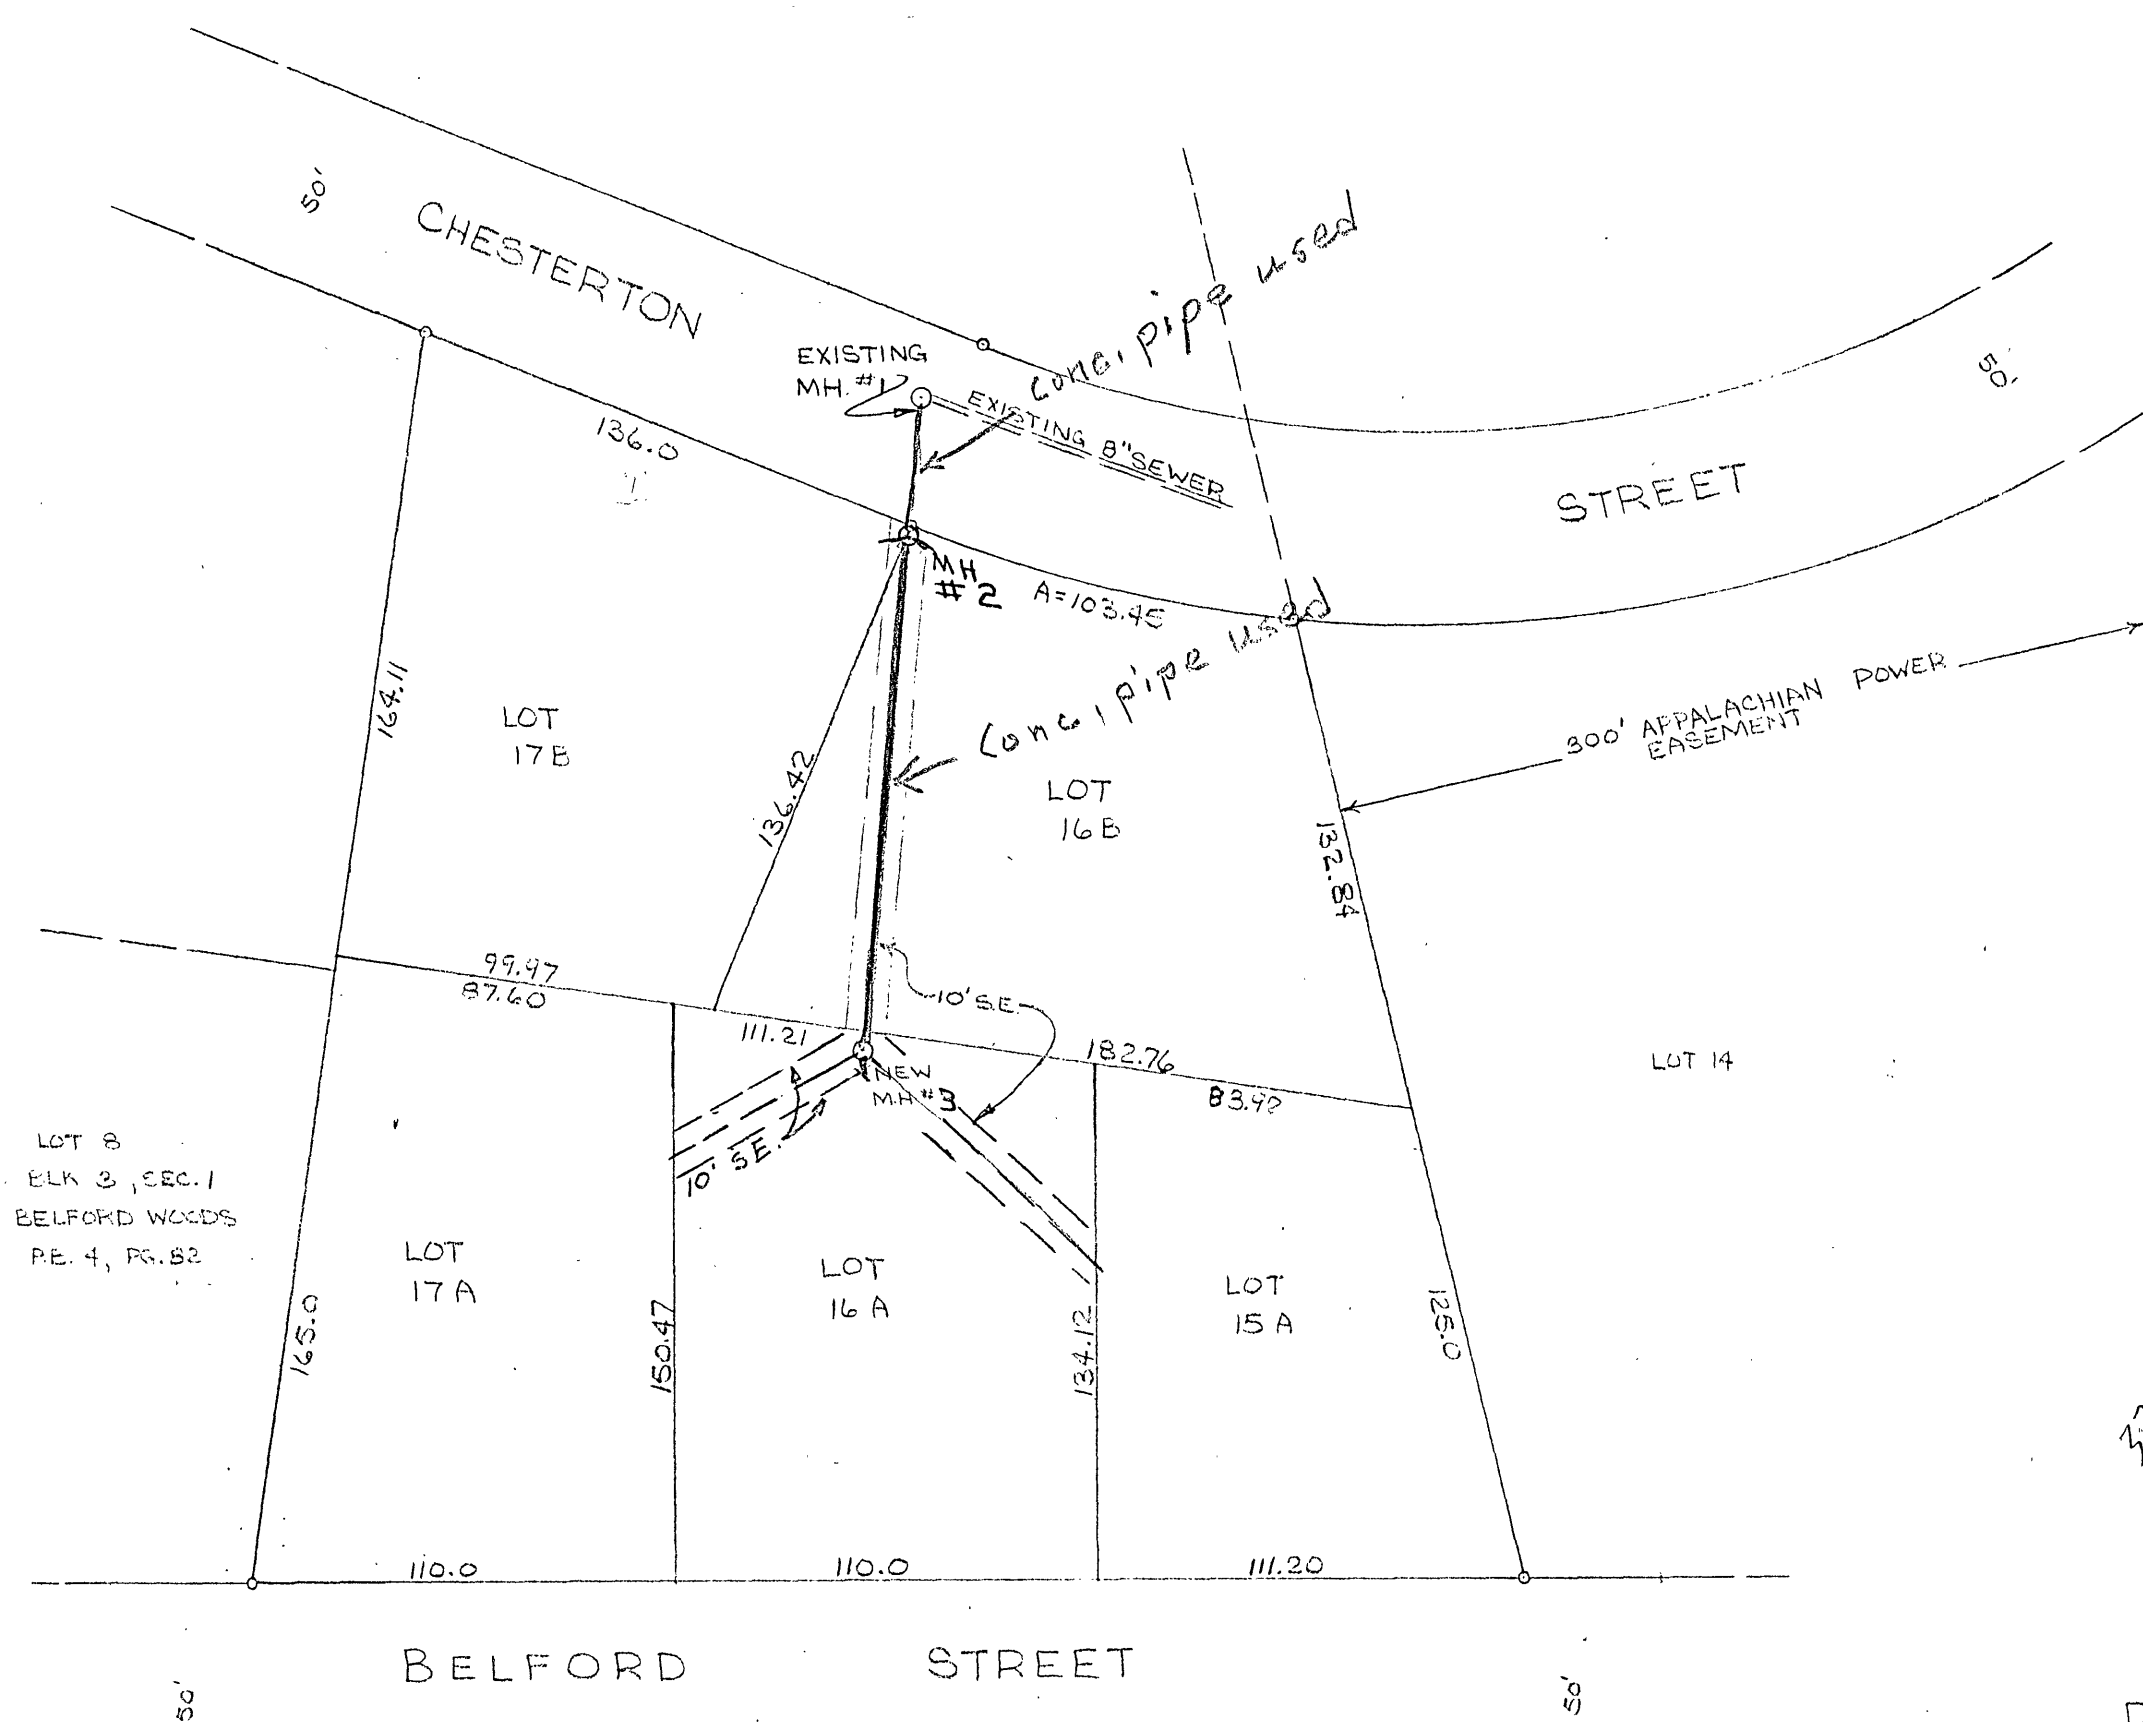

PLAN SCALE: 1" = 50'

NOTE: SEWER LINE TO BE BUILT BY SPECIFICATIONS AND STANDARDS OF ROANOKE COUNTY PUBLIC SERVICE AUTHORITY.

ANCHOR BLOCK DETAIL

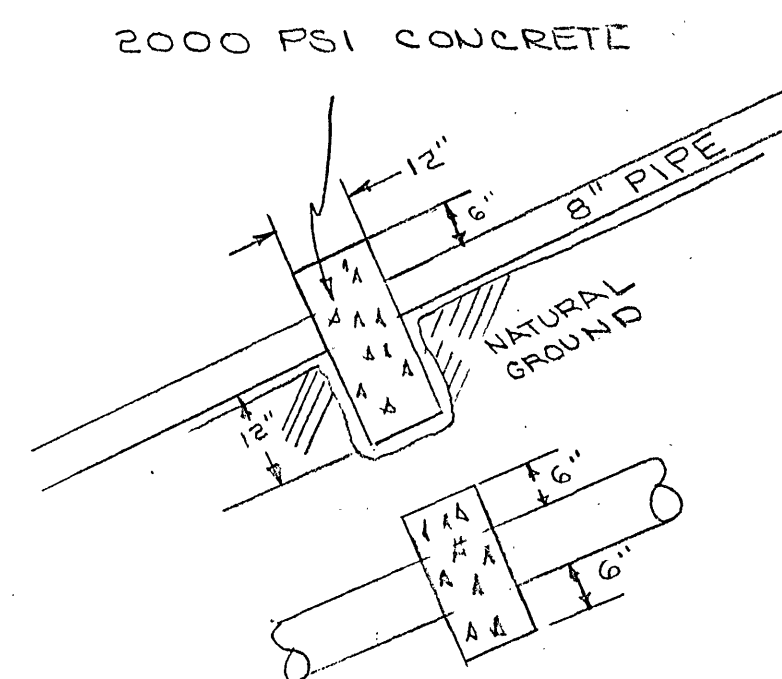

AS BUILT SANITARY SEWER EXTENSION FOR G. W. DREWRY

THRU NEW LOT 16B BEING A PART OF SUBDIVISION OF LOTS 16, 17 & PART OF LOT 15, BLOCK 10, SEC. 2, WESTCHESTER, VIRGINIA, FEB. 9, 1973

BY: T. P. PARKER & SON, ENGINEERS & SURVEYORS

APPROVED:

ROANOKE CO. PUBLIC SERVICE AUTHORITY DATE

