

GENERAL NOTES

PRE-CONSTRUCTION MEETING AND CONSTRUCTION COMMENCEMENT:

- All construction methods and materials shall conform to the Construction Standards and Specifications of Roanoke County, the Western Virginia Water Authority, and the Virginia Department of Transportation.
- Stormwater Management Agreements with an attached 8 1/2" x 11" or 8 1/2" x 14" plat must be approved and recorded prior to the pre-construction meeting.
- Once all required items are submitted to the County of Roanoke, the developer must contact the Development Review Coordinator to indicate that a pre-construction meeting needs to be scheduled. The pre-construction meeting will be scheduled with the owner/developer two (2) working days later.
- Please note the 2001 General Assembly revisions to Va Erosion and Sediment Control Law. Effective July 1, 2001, all land disturbing projects that require approval of an erosion and sediment control plan, grading or clearing permit shall require that the applicant provide the name of an individual who will be Responsible Land Disturber (RLD) Certificate from the Department of Conservation and responsible for land disturbing activities and that this individual hold a Recreation. The Responsible Land Disturber can be anyone from the Project team that is certified by the State of Virginia to be in charge of carrying out the land disturbing activity for the project.
- It is the responsibility of the owner/developer to notify the certified Responsible Land Disturber and the Utility Contractor to attend the pre-construction meeting.
- The Development Review Coordinator will schedule the pre-construction meeting with the County Review Engineer, the County Inspector, and the Western Virginia Water Authority and the Town of Vinton Public Works Department if applicable.
- An approved set of plans and all permits must be available at the construction site at all times.
- The developer and/or contractor shall supply all utility companies with copies of approved plans, advising them that all grading and installation shall conform to approved plans.
- The project engineer will inform the owner/developer verbally and in writing of the County's obligation to perform inspections on site. Everyone in the meeting will be required to sign a pre-construction checklist indicating their knowledge of Roanoke County's obligation to perform inspections on site.

- The Erosion Control Permit is given to the developer at this pre-construction meeting.
- The developer MUST contact the project inspector 24 hours before beginning any grading or construction on the property.
- The project inspector will visit the site within 48 hours of the developer's call to ensure that all necessary erosion and sediment control measures are properly installed according to the approved plan.
- All work shall be subject to inspection by Roanoke County, the Western Virginia Water Authority and the Virginia Department of Transportation inspectors.
- Contractors shall notify utilities of proposed construction at least two (2), but not more than ten (10) working days in advance. Area public utilities may be notified thru "Miss Utility": 1-800-552-7001.
- 100 year Floodway and Floodplain information shall be shown where applicable. FIRM Index Date shall be shown on the plans. The 100 year Floodway shall be staked prior to any construction.
- Grade stakes shall be set for all curb and gutter, culvert, sanitary sewer and storm sewer at all times of construction.
- The Department of Community Development shall be notified when a spring is encountered during construction.
- Construction debris shall be containerized in accordance with the Virginia Litter Control Act. No less than one litter receptacle shall be provided on site.
- The contractor shall provide adequate means of cleaning mud from trucks and/or other equipment prior to entering public streets or rights of ways. It is the contractors responsibility to insure that the streets are in a clean, mud and dust free condition at all times.
- Plan approval in no way relieves the developer or contractors of the responsibilities contained within the erosion and sediment control policies.
- Field construction shall honor proposed drainage divides as shown on plans.
- Field corrections shall be approved by the Roanoke County Engineering Division and/or the Western Virginia Water Authority and the Professional of Record, prior to such construction.
- The developer or contractor shall supply the County and the Western Virginia Water Authority with correct As-Built plans before final acceptance.


VIRGINIA DEPARTMENT OF TRANSPORTATION:

- Plan approval by Roanoke County does not guarantee issuance of any permits by the Virginia Department of Transportation.
- A permit must be obtained from the Virginia Department of Transportation, Salem Residency Office prior to construction in the highway right-of-way.
- The preliminary pavement designs should be based on a predicted sub-grade CDR value of 7.0 and with a Resiliency Factor (RF) of 2.0 as shown in Appendix I of the 2000 Virginia Department of Transportation Pavement Design Guide for Subdivision and Secondary Roads. The sub-grade soil is to be tested by an independent laboratory and the results submitted to the Virginia Department of Transportation prior to base construction. Should the sub-grade CDR value and/or the RF value be less than the predicted values, additional base material will be required in accordance with Departmental specifications. Refer to the same manual as the number and locations of the required soil samples to be tested. All pavement designs shall be submitted to the Department for review and approval. The sub-grade shall be approved by the Virginia Department of Transportation prior to placement of the base. Base shall be approved by the Virginia Department of Transportation for depth, template, and compaction before the surface is applied.
- Standard guardrail with safety end sections may be required on fills or in areas where hazards exist as deemed necessary. After completion of rough grading operations, the County Engineer and Virginia Department of Transportation shall be contacted to schedule a field review. Where guard rail is warranted, the standard shoulder width shall be provided and the guard rail shall be installed in accordance with the 2001 VDOT Road and Bridge Standards as part of this development.
- Standard street and traffic control signs shall be erected at each intersection by the developer prior to final street acceptance.
- All traffic devices shall be in accordance with current edition of the manual: "Uniform Traffic Control Devices (MUTCD)".
- All unsuitable material shall be removed from the construction limits of the roadway before placing embankment.


The Project Engineer shall provide electronic copies of the approved plans to the Development Review Coordinator within 5 working days of the pre-construction meeting. This sheet may not be modified.

See Sheet _____ for Stormwater Site Statistics Table.
See Sheet _____ for New BMP Information Table.

The Project Engineer shall provide electronic copies of the approved plans to the Development Review Coordinator within 5 working days of the pre-construction meeting.
The notes on this sheet shall not be modified.

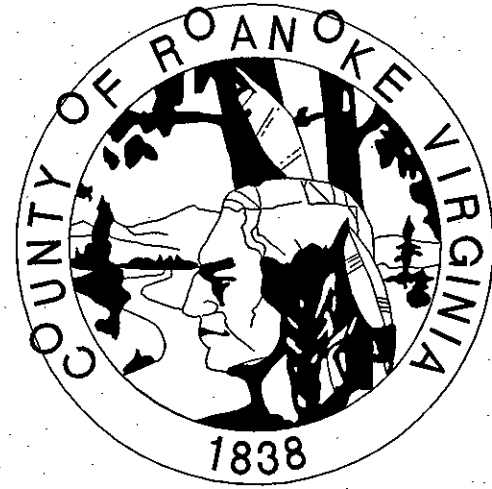

NAME OF DEVELOPMENT	CHRIST THE KING PRESBYTERIAN CHURCH		
MAGISTERIAL DISTRICT(S)	WINDSOR HILLS		
OWNER (name, address, telephone)	2335 ELECTRIC ROAD		
DEVELOPER (name, address, telephone)	CHRIST THE KING PRESBYTERIAN CHURCH (ATTN: Justin Davies) 2335 ELECTRIC ROAD		
ENGINEER, ARCHITECT OR SURVEYOR (name, address, telephone)	Pierson Engineering and Surveying, Inc. Ph: 540-966-3027 P.O. Box 311 Fax: 540-966-5906 Daleville, VA 24083 Email: rpierson@rbnet.com		
TAX MAP NO(S)	076.11-03-76.00-0000 (CHURCH SITE) & 076.00-03-75.00-0000 (CHURCH OFFICE SITE)		

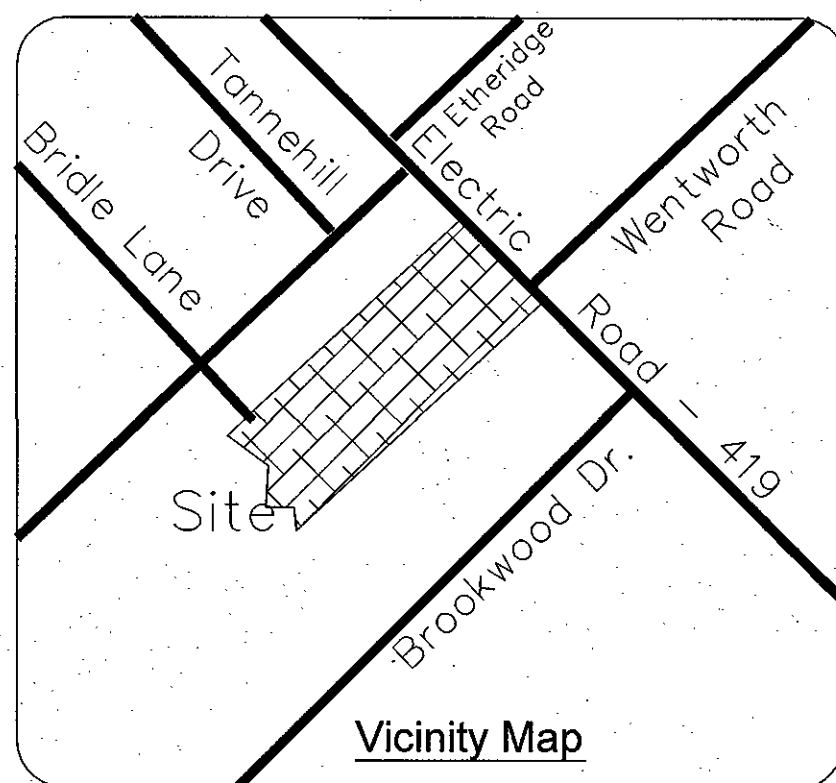

SEWER NOTES

All sewer facilities shall be installed according to the Town of Vinton Water/ Western Virginia Regional Design and Construction Standards.

A minimum cover of three (3) feet is required over proposed lines.

Contractor shall be responsible for locating and uncovering all manholes after paving. Manhole tops shall be adjusted to grade if necessary.

All existing utilities may not be shown in their exact location. The contractor shall comply with (State Water Works Regulations, Section 12.05.03, where lines cross.)

All trenches in existing or future rights-of-way shall be compacted according to Virginia Department of Transportation standards.

Lines shall be staked prior to construction.

RETAINING WALLS

A separate review and building permit application are required for all retaining wall(s). A copy of the approved site plan must be submitted with the building permit application for the retaining wall(s) plan.

PRIVATE UTILITIES

Underground utilities installed on private property or in private utility easements and building related storm drains shall be designed and installed per the current edition of the Virginia Uniform Statewide Building Code. Design and installation requirements issued by the Vinton Public Works Department that meet or exceed the USBC requirements are acceptable for private utilities. All private utilities are to be permitted through and inspected by the Roanoke County Inspections Office. Vaults, valves and other devices installed by or under the control of the Vinton Public Works Department may not substituted for the code required devices.

LEGEND

Property Line	— P —
Right-of-way	— R/W —
Centerline	— CL —
Minimum Building Line	— MBL —
Existing Storm Sewer	— 18" SD — 18" SD —
Existing Sanitary Sewer	— 8" SS — 8" SS —
Existing Water Main	— 4" W — 4" W —
Existing Contour	— 1045 —
Proposed Contour	— 1045 —
Proposed Drainage Divide	— < — < —
Proposed Limits of Clearing	— 24" S.D. —
Proposed Storm Sewer	— 8" M.H. —
Proposed Sanitary Sewer	— 8" M.H. —
Proposed Water Main	— HYDRANT VALVE — BLOWOFF —

County of Roanoke, VA

I, Justin Davies, OWNER/DEVELOPER, AM AWARE OF THE SITE DESIGN REQUIREMENTS IMPOSED BY THIS SITE DEVELOPMENT PLAN AND OTHER APPLICABLE TOWN OF VINTON AND ROANOKE COUNTY CODES. I HEREBY CERTIFY THAT I AGREE TO COMPLY WITH THESE REQUIREMENTS AND THE THIRTY (30) POINTS SHOWN ON THIS COVER SHEET UNLESS MODIFIED IN ACCORDANCE WITH LOCAL LAW.

SHEET LIST

- COVER SHEET
- ABBREVIATIONS, NOTES, AND LEGEND
- DIMENSIONAL LAYOUT PLAN
- GRADING PLAN
- UTILITY PLAN
- EROSION & SEDIMENT CONTROL PHASE 1
- EROSION & SEDIMENT CONTROL PHASE 2
- EROSION & SEDIMENT CONTROL NOTES
- EROSION & SEDIMENT CONTROL DETAILS
- ENTRANCE & STORM DRAIN PIPING PROFILES
- STORM DRAIN PIPING PROFILES
- STORMWATER MANAGEMENT POND DETAILS
- ADS, FILTERRA AND STORMDRAIN DETAILS
- WATER & SEWERLINE PROFILES
- WATERLINE DETAILS
- SANITARY SEWER DETAILS
- MISCELLANEOUS NOTES AND DETAILS
- EXISTING DRAINAGE DIVIDES
- NEW DRAINAGE DIVIDES
- IMPERVIOUS AREAS
- 100 YEAR FLOODPLAIN
- LANDSCAPING, PHASING AND ACCESS EASEMENT
- LANDSCAPING DETAILS
- SUGGESTED MAINTENANCE OF TRAFFIC PLAN
- STRIPPING AND GUARDRAIL PLAN

WATER NOTES

All water facilities shall be installed according to the Town of Vinton Water/ Western Virginia Regional Design and Construction Standards.

A minimum cover of three (3) feet is required over proposed lines.

Contractor shall be responsible for locating and uncovering valve vaults after paving and adjustment to final grade if necessary.

All existing utilities may not be shown in their exact location. The contractor shall comply with the (State Water Works Regulations, Section 12.05.03, where lines cross.

All trenches in existing or future highway right-of-ways shall be compacted according to Virginia Department of Transportation standards.

Lines shall be staked prior to construction.

Water main shall be minimum Class 350 Ductile Iron in accordance to AWWA C151.

Availability Letter Number is 14-200.

SURVEY INFORMATION

Horizontal and vertical control surveys were performed in year: 2014
By: Pierson Engineering and Surveying, Inc.

All vertical elevations must be referenced to the National Geodetic Vertical Datum of 1929 or 1988. All horizontal elevations must be referenced to the North American Datum of 1927 or 1983.

Source of topographic mapping is: Pierson Engineering and Surveying, Inc.

Boundary was performed by Pierson Engineering dated: 2014

Benchmark Information:

The professional seal and signature certifies the boundary survey and topographic mapping to be accurate and correct.

SITE BENCHMARKS

POINT NAME	NORTHING	EASTING	ELEVATION	DESCRIPTION
BM#1	3614772.56	11031555.45	1127.60'	NAIL SET WITH STAKE

DATE: 05/02/2014

11/16/2015

12/16/2015

07/12/2016

PIERSON ENGINEERING & SURVEYING


P.O. BOX 311
44 CATAWBA ROAD
DALEVILLE, VA 24083

(540) 966-3027 TEL
(540) 966-5906 FAX
e-mail: rpierson@rbnet.com

APPROVED

DEVELOPMENT PLAN APPROVED FOR CONSTRUCTION BY ROANOKE COUNTY	Date
Department	2/15/17
Development Review	MC 2/15/17
Engineering	2/15/17
Water & Sewer	2/15/17
Planning & Zoning	2/15/17

COVER SHEET

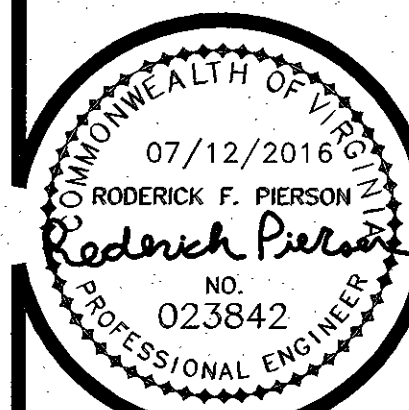

COMMISSION
R201410

SHEET
C1

As-Built
02/19/2019
See Sheet C5 - Utilities

4th Review