


15" RCP, CL III, SLOPE = 0.60%
 1002.54; INV. OUT = 1002.15
 TE ELEV. = 1005.00
 MP IN = 1002.54; INV. RCP OUT = 1002.54
 15" CMP, SLOPE = 0.60% WITH 30' LF OF TRENCH DRAIN
 1003.00; INV. OUT = 1002.54
 TE ELEV. = 1005.50
 MP OUT = 1003.00
 15" RCP, CL III, SLOPE = 0.60%
 1005.00; INV. OUT = 1004.66
 TE ELEV. = 1007.50
 UT = 1005.00
 15" RCP, CL III, SLOPE = 1.00%
 998.21; INV. OUT = 997.79
 2.5'; TOP ELEV. = 1003.11
 JT = 998.21
 15" RCP, CL III, SLOPE = 1.00%
 1004.68; INV. OUT = 1004.34
 8'; TOP ELEV. = 1009.50
 JT = 1004.68
 15" MANHOLE, RIM ELEV. = 998.00
 = 995.35; INV. 30" IN = 994.35
 JT = 994.35
 30" RCP, CL III, SLOPE = 1.50%
 96.54; INV. OUT = 994.35
 8'; TOP ELEV. = 1003.36
 = 997.79; INV. 27" IN = 996.79
 OUT = 996.54

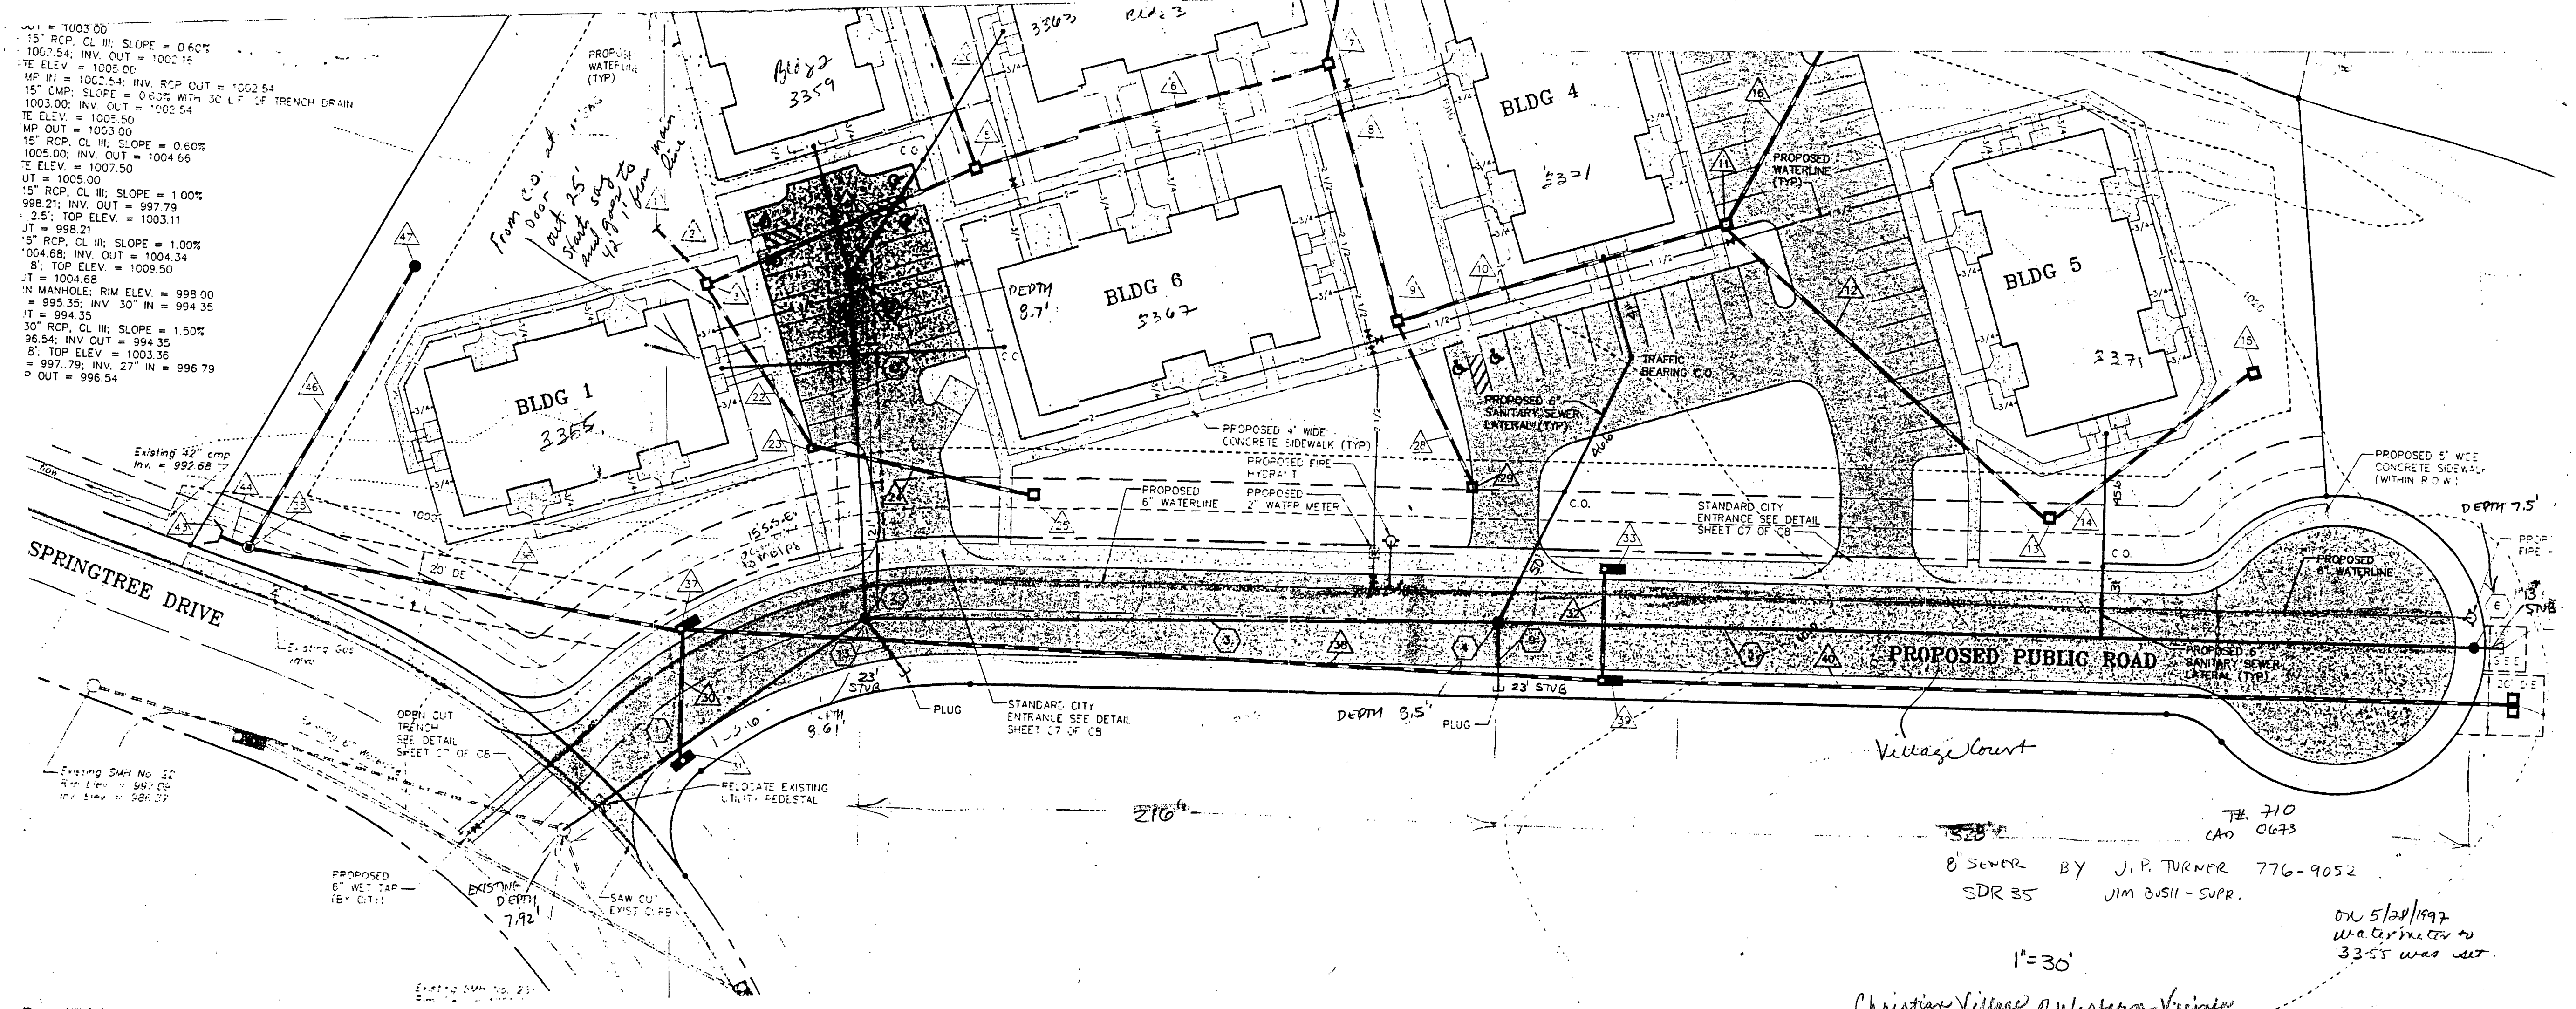

THE 710
 CAN 0673
 8" SEWER BY J.P. TURNER 776-9052
 SDR 35 JIM BUSH - SUPR.

1"=30'
 Christian Village of Western Virginia
 ON 5/28/1997
 watermeter to
 3355 was set