


STORMWATER MANAGEMENT COST ESTIMATE

ALL COSTS GIVEN ARE COMPLETE IN PLACE


DESCRIPTION	UNIT	QUANTITY	UNIT COST	TOTAL COST
CLEARING & GRUBBING	LS		\$	\$
EXCAVATION	CY			
EMBANKMENT	CY			
FENCING	LF			
STRUCTURES				
ACCESS ROAD				
AS-BUILTS				
SUB-TOTAL			\$	\$
10% CONTINGENCY			\$	\$
TOTAL PROJECT COST			\$	\$

DETENTION BASIN, STORM
DRAIN INLETS & PIPING,
& PERMANANT VEGETATIVE
IN PLACE VIA PREVIOUS
CONSTRUCTION


SEDIMENT BASIN SCHEMATIC ELEVATIONS

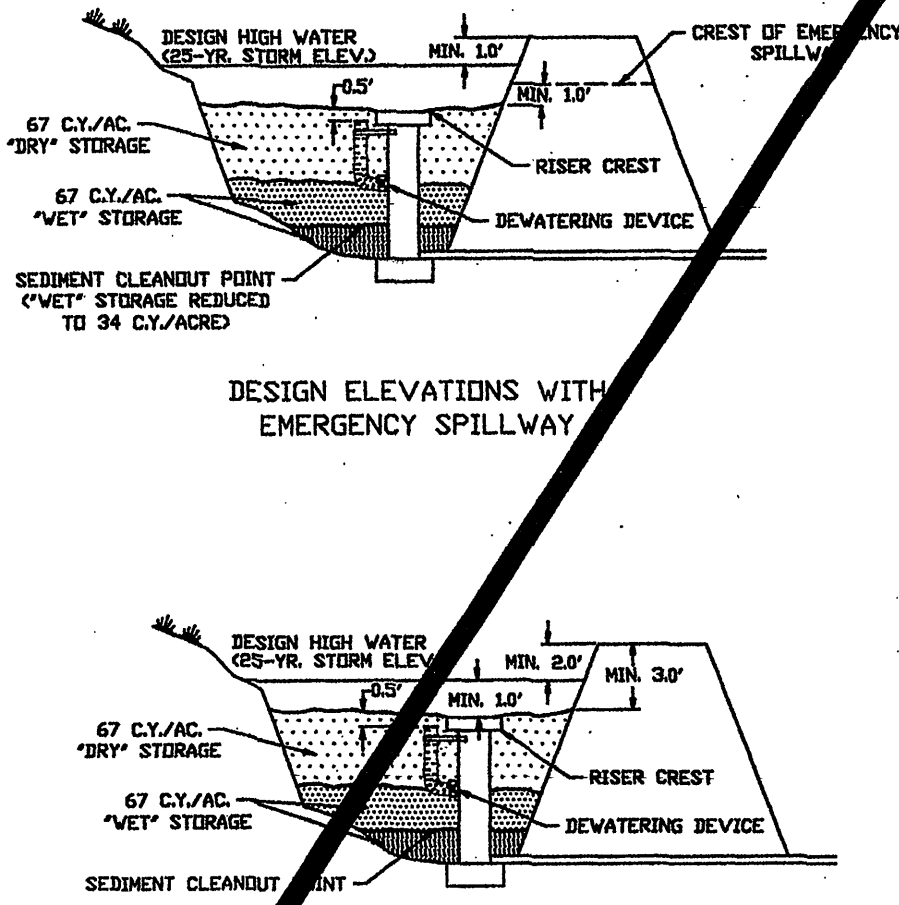

DESIGN ELEVATIONS WITH EMERGENCY SPILLWAY

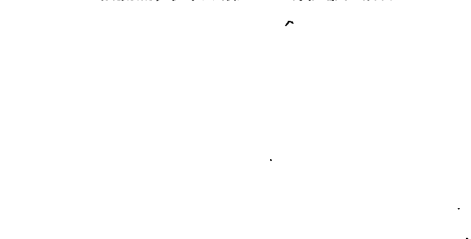

DESIGN ELEVATIONS WITHOUT EMERGENCY SPILLWAY

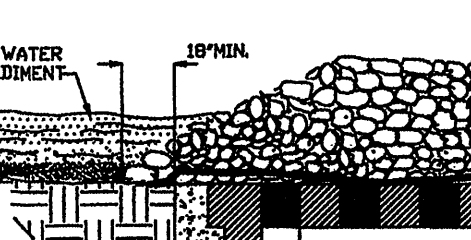

SPECIFIC APPLICATION
This method of inlet protection is applicable where heavy concentrated flows are expected, but not where ponding around the structure might cause excessive inconvenience or damage to adjacent structures and unprotected areas.

* Gravel shall be VDOT #3, #37 or #5 coarse aggregate.

IP GRAVEL AND WIRE MESH DROP INLET SEDIMENT FILTER

GENERAL NOTES

- DESIGN OF DETENTION BASINS SHALL CONFORM TO THE REQUIREMENTS OF THE COUNTY OF ROANOKE DRAINAGE STANDARDS (REF. SECTIONS 903.02, 903.03, AND 903.02). THE DESIGN OF THE FACILITY AND PREPARATION OF AS-BUILT PLANS SHALL BE BY A CERTIFIED PROFESSIONAL ENGINEER LICENSED TO PRACTICE IN THE COMMONWEALTH OF VIRGINIA.
- ACCESS TO THE FACILITY MUST BE PROVIDED IN ACCORDANCE WITH THE COUNTY OF ROANOKE DESIGN AND CONSTRUCTION STANDARDS FOR DETENTION PONDS, LATEST EDITION.
- IF THE FACILITY IS OVER FOUR (4) FEET DEEP, TAKES OVER TWO (2) HOURS TO DRAIN, OR THE INTERIOR SLOPE EXCEEDS 3 (H) : 1 (V), PERMANENT FENCING MAY BE REQUIRED. ADDITIONALLY, IF THE FACILITY IS IN A CONGESTED AREA OR VIEW IN ANY WAY POSE A HAZARD TO THE GENERAL PUBLIC, FENCING MAY BE REQUIRED. FENCING SHALL BE A MINIMUM OF SIX (6) FEET HIGH, A MINIMUM OF STANDARD NINE GAUGE LINK FENCE, AND MUST HAVE ONE OR MORE LOCKING DOUBLE GATES (MINIMUM TEN FEET WIDE) FOR ACCESS.
- DETENTION PONDS SHALL BE BOUND IN ACCORDANCE WITH THE ROANOKE COUNTY BONDING POLICY FOR SUBDIVISION AND SITE DEVELOPMENT. A SEPARATE BOND FOR THE DETENTION FACILITY WILL BE REQUIRED AND ADMINISTERED APART FROM THE SUBDIVISION DEVELOPMENT BOND. REFERENCE ESTIMATE - THIS SHEET.
- REFERENCE THE COUNTY OF ROANOKE DESIGN AND CONSTRUCTION STANDARDS FOR DETENTION PONDS, LATEST EDITION, FOR ACCEPTANCE AND MAINTENANCE OF THE FACILITY. CERTIFIED AS-BUILTS ARE REQUIRED AND MUST INCLUDE:


- DIMENSIONS OF THE FACILITY
- VOLUME OF MAXIMUM DEPTH
- ELEVATIONS OF STRUCTURES, SPILLWAYS, AND TOP
- MATERIALS VERIFICATION INCLUDING RESULTS OF DENSITY TESTS CONDUCTED BY AN INDEPENDENT SOIL TESTING LABORATORY
- LOCATION AND ELEVATION OF BENCHMARK
- FOOT MINIMUM FREEBOARD REQUIRED FOR THE 100 YEAR WATER SURFACE ELEVATION

CONSTRUCTION NOTES


- SITE PREPARATION SHALL BE IN ACCORDANCE WITH THE COUNTY OF ROANOKE DESIGN AND CONSTRUCTION STANDARDS FOR DETENTION PONDS, LATEST EDITION.
- SLOPES STEEPER THAN 3 TO 1 (HORIZONTAL TO VERTICAL) SHALL BE BENCHED OR STEPPED PRIOR TO PLACING FILL ON THEM.
- ON-SITE FILL MATERIAL OR BORROW FILL MATERIAL MAY BE UTILIZED. FILL MATERIAL SOILS, IN GENERAL:
 - SHALL BE COMPACTABLE
 - SHALL BE WITHIN AN ACCEPTABLE RANGE OF MOISTURE CONTENT WHICH IS READILY CONTROLLED
 - SHALL NOT BE HIGHLY SUSCEPTIBLE TO VOLUME CHANGE (SHRINKAGE OR SWELL) OR SETTLEMENT
- FILL MATERIAL CONTAINING ROCKS LARGER THAN SIX (6) INCHES C152 C10 SHALL NOT BE USED. THE UPPERMOST TWO (2) FEET C61 C10 SHALL NOT HAVE ANY ROCK LARGER THAN TWO (2) INCHES C51 C10 IN DIAMETER.
- THE APPROVED FILL SHALL BE PLACED IN EIGHT (8) INCH C80 C10 LOOSE LIFTS. EACH LIFT SHALL BE SPREAD IN UNIFORM LAYERS. FILL SOIL SHALL BE UTILIZED ONLY WITHIN A MOISTURE RANGE OF +/- 5% OF THE OPTIMUM MOISTURE CONTENT. COMPACTION OF THE FILL SHALL BE PERFORMED WITH APPROVED EQUIPMENT. COMPACTION OF THE LAYERS SHALL BE CONTINUOUS AND UNIFORM.
- EMBANKMENT MATERIAL IN FILL AREAS SHALL BE PLACED IN LIFTS NOT EXCEEDING EIGHT (8) INCHES AND SHALL BE COMPACTED TO A MINIMUM 95% DENSITY IN ACCORDANCE WITH SECTION 903 OF THE VIRGINIA DEPARTMENT OF TRANSPORTATION ROAD AND BRIDGE SPECIFICATIONS.
- FIELD DENSITY TESTS ARE TO BE CONDUCTED BY AN INDEPENDENT SOILS TESTING LABORATORY UNDER THE SUPERVISION OF A QUALIFIED GEOTECHNICAL ENGINEER. THE RESULTS OF THESE TESTS SHALL BE SUBMITTED TO THE COUNTY OF ROANOKE VIA AS-BUILT PLANS AS A CONDITION OF ACCEPTANCE OF THE FACILITY BY THE COUNTY. FIELD DENSITY TESTS, AS DIRECTED BY THE ENGINEER, SHALL BE PERFORMED PERIODICALLY TO DETERMINE THE DEGREE OF COMPACTION. ANY AREAS FAILING TO MEET THE ABOVE REQUIREMENTS SHALL BE REWORKED AND/OR RECOMPACTED UNTIL THE REQUIRED DEGREE OF COMPACTION IS ACHIEVED.
- ANTI-SLEEP COLLARS SHALL BE INSTALLED IN ACCORDANCE WITH THE REQUIREMENTS OF THE VIRGINIA EROSION AND SEDIMENT CONTROL HANDBOOK, LATEST EDITION.
- ALL DISTURBED AREAS SHALL BE COVERED WITH FOUR (4) INCHES OF TOPSOIL AND SEED.
- THE MINIMUM SLOPE OF THE BASIN FLOOR SHALL BE ONE (1) PERCENT GRADED TO DRAIN TO THE PRINCIPAL SPILLWAY.

SPECIFIC APPLICATION


This method of inlet protection is applicable where heavy flows are expected and where an overflow capability and ease of maintenance are desirable.

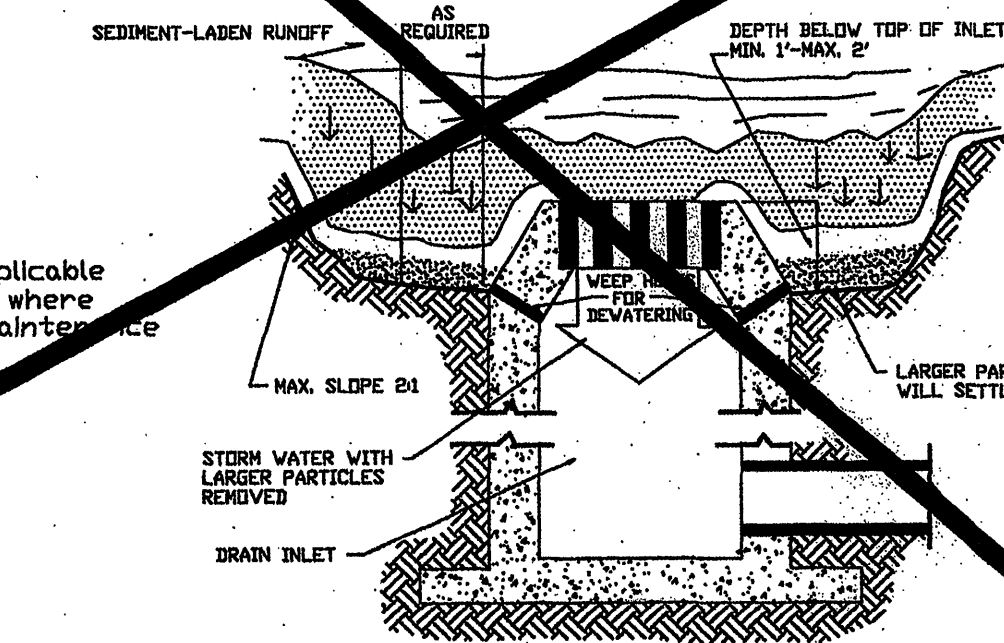


IP EXCAVATED DROP INLET SEDIMENT TRAP

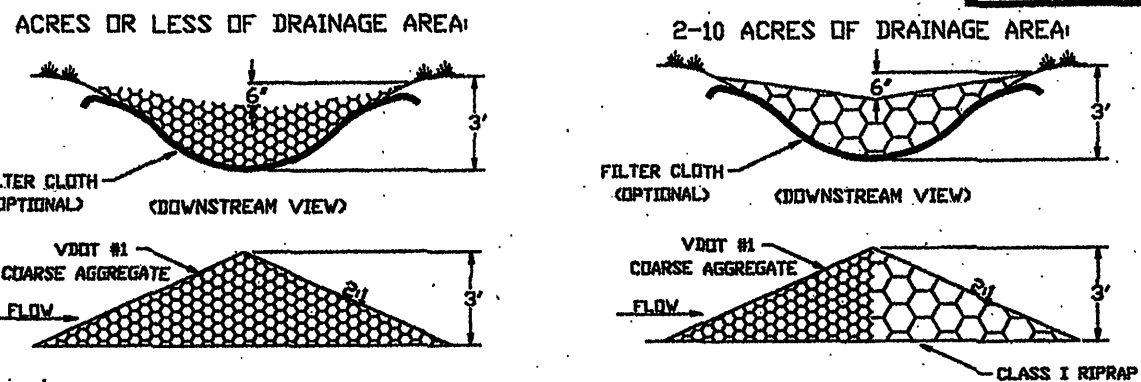

CD ROCK CHECK DAM

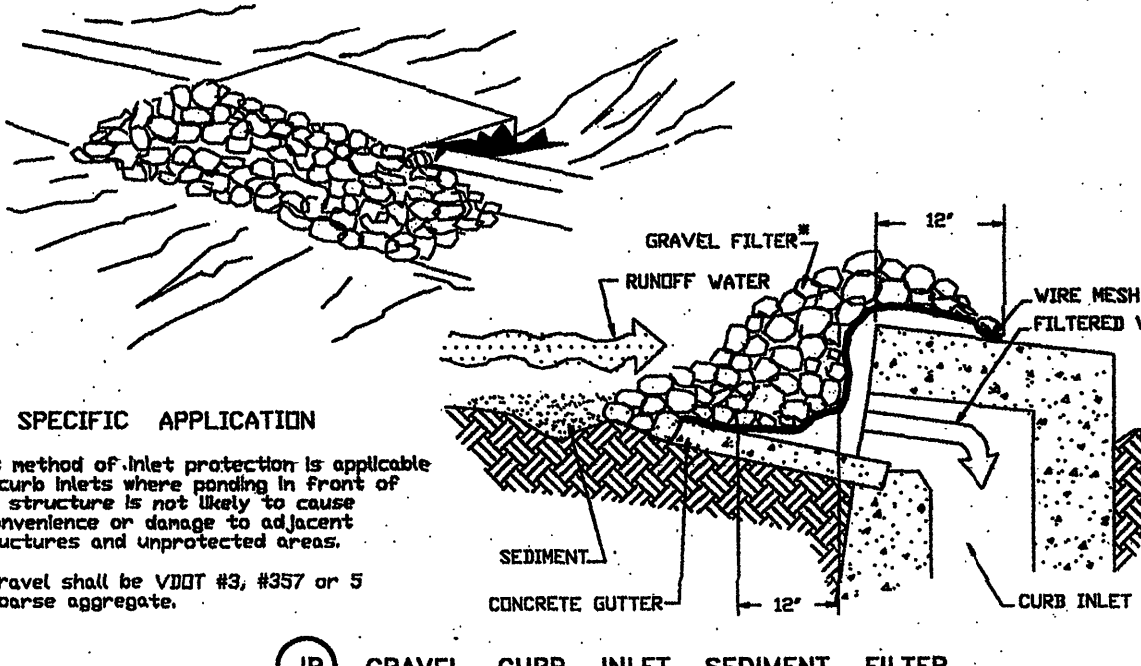

IP GRAVEL CURB INLET SEDIMENT FILTER

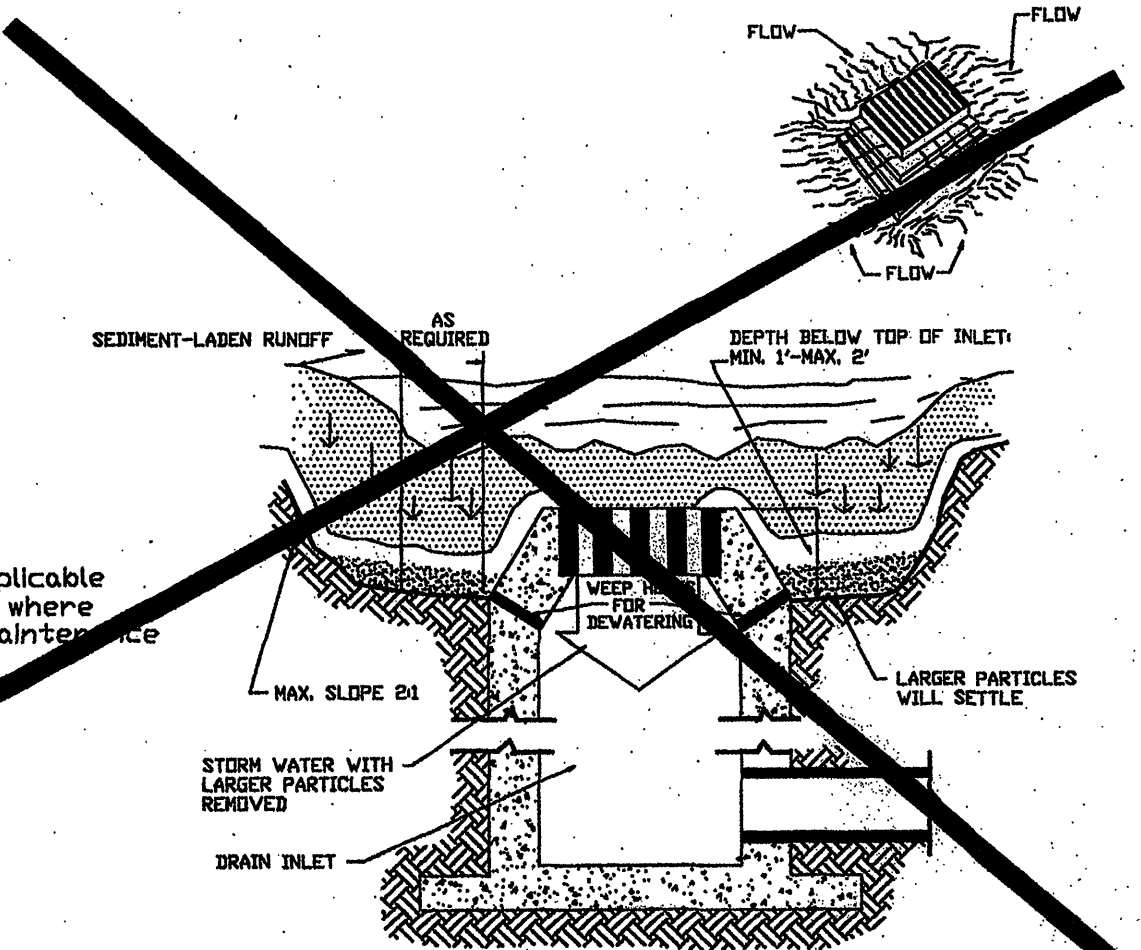

IP SAFETY FENCE

IP TEMPORARY GRAVEL CONSTRUCTION ENTRANCE

IP TEMPORARY DIVERSION DIKE

IP TEMPORARY FILL DIVERSION

IP TEMPORARY RIGHT-OF-WAY DIVERSION

IP DIVERSION

IP DUST CONTROL

IP TOPSOILING

IP TEMPORARY SEEDING

IP PERMANENT SEEDING

IP SODDING

IP BERMUDA GRASS AND ZOYSIAURASS ESTABLISHMENT

IP MULCHING

IP SOIL STABILIZATION

IP BLANKETS AND MATTING

IP TREES, SHRUBS, VINES AND GROUND COVERS

IP TREE PRESERVATION AND PROTECTION

IP RIPRAP

IP OUTLET PROTECTION

IP SUBSURFACE DRAIN

IP TURBIDITY CURTAIN

IP DEWATERING STRUCTURE

IP TEMPORARY VEHICULAR STREAM CROSSING

IP STRUCTURAL STREAMBANK STABILIZATION

IP VEGETATIVE STREAMBANK STABILIZATION

IP LEVEL SPREADER

IP ROCK CHECK DAMS

IP SAFETY FENCE

IP TEMPORARY GRAVEL CONSTRUCTION ENTRANCE

IP TEMPORARY DIVERSION DIKE

IP TEMPORARY FILL DIVERSION

IP TEMPORARY RIGHT-OF-WAY DIVERSION

IP DIVERSION

IP DUST CONTROL

IP TOPSOILING

IP TEMPORARY SEEDING

IP PERMANENT SEEDING

IP SODDING