


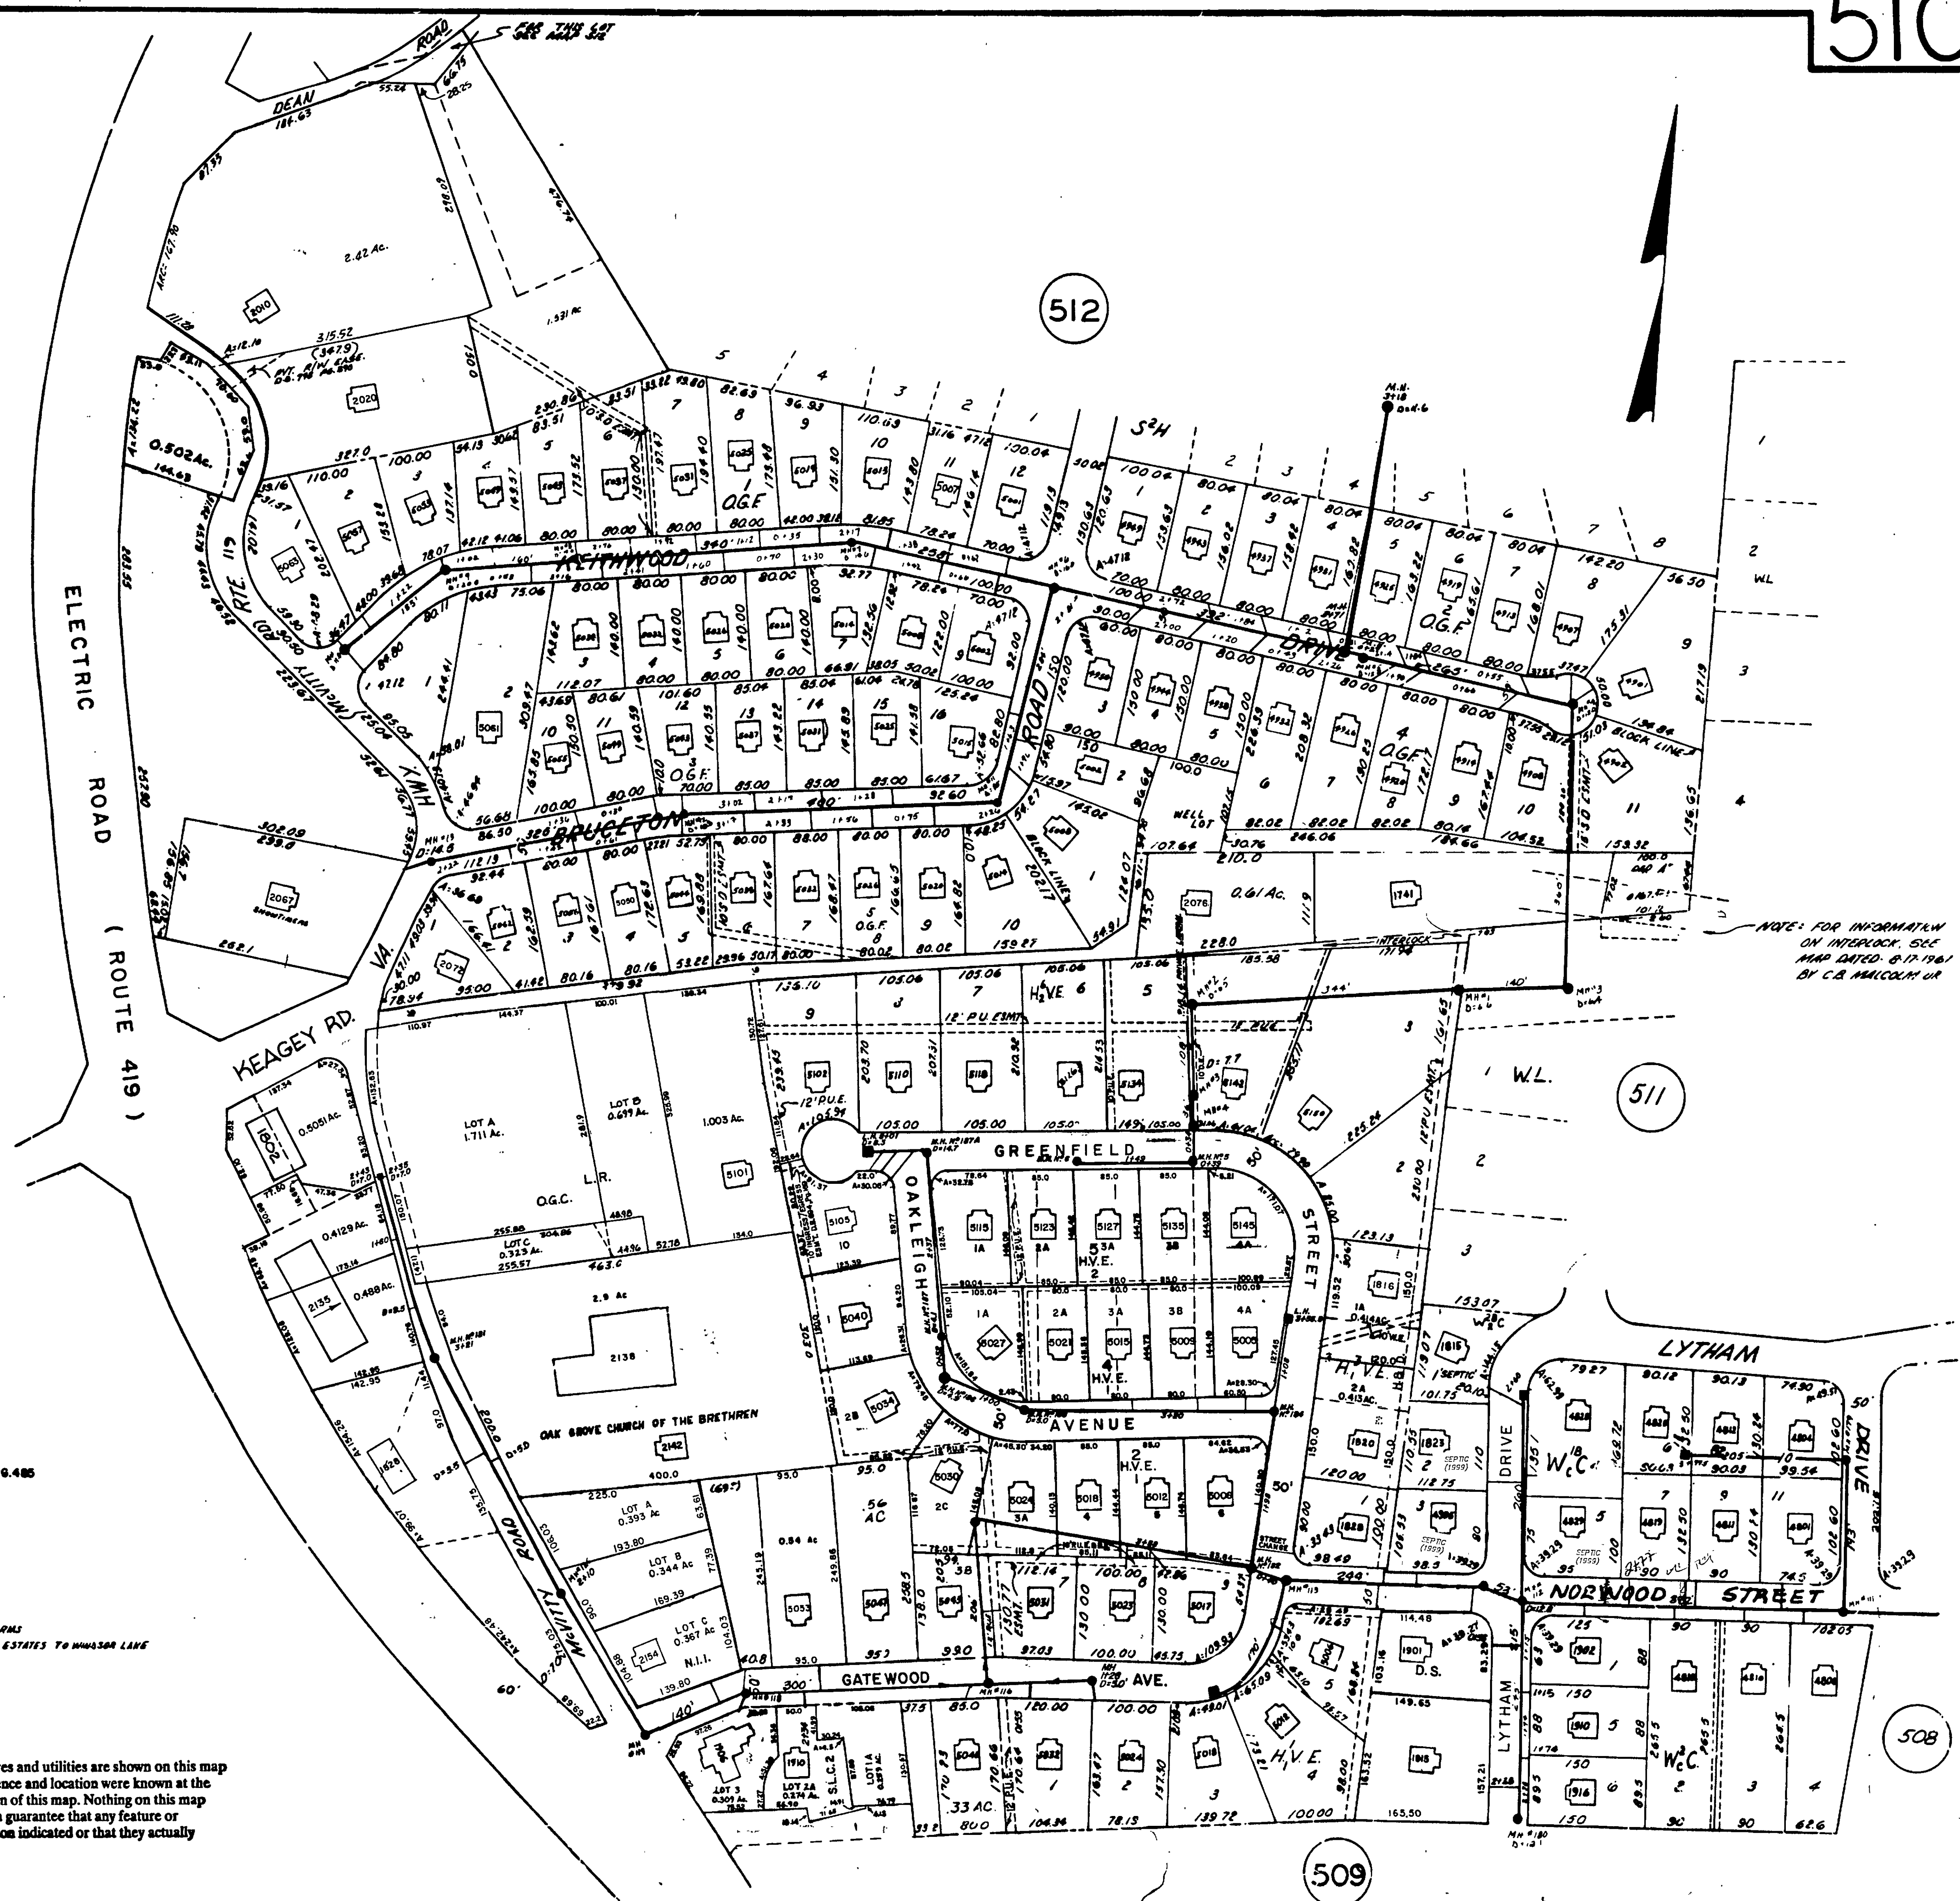

() = DISTANCE TO POINT IN ROAD
 WC - WESTCHESTER COURT SECT. PB.3 Pg. 286
 S.H. - SUNSET HILLS PB.6 Pg. 74
 O.G.F. - OAK GROVE FARMS: PB.6, Pg. 8
 H.V.E. - HIDDEN VALLEY ESTATES: SECT. 2, PB.3 Pg. 242
 H.V.E. - HIDDEN VALLEY ESTATES: SECT. 1, PB.3 Pg. 196
 H.B.D. - EVELYN F. & IRA C. HARRIS, JR. & RICHARD M. & JEANNE M. DUDY: M.B.1 Pg. 485
 D.S. - DOMIS H. SWITZER: M.B.1 Pg. 738
 N.I.I. - NABS INVESTMENTS, INC. M.B.1 Pg. 1165
 L.R. - LOUIS B. RAMBO ESTATE-M.B.1 Pg. 1192
 S.L.C.2 - SUGARLOAF CROSSING, PHASE 2-M.B.1, Pg. 1615 / M.B.1, Pg. 1712, 1717
 O.G.C. - OAK GROVE CHURCH - M.B.1, Pg. 2006-2007

SEWER MAP

CITY OF ROANOKE, VA.
 SHEET NO. 510
 OFFICE OF THE CITY ENGINEER

DRAWN BY: L.H. LOSAN DATE:
 F.L.D. WORK BY: DATE:
 RECORD WORK BY: DATE:
 CHECKED BY: DATE:
 SCALE: 1"=100' REVISED:

CITY ENGINEER

AS BUILTS
 6-1-16 11/12
 P.B. OAK GROVE FARMS
 P.B. HIDDEN VALLEY ESTATES TO HUNTER LAKE

NOTICE

The location of features and utilities are shown on this map in so far as their existence and location were known at the time of the preparation of this map. Nothing on this map shall be construed as a guarantee that any feature or utility are in the location indicated or that they actually exist.

NOTE: FOR INFORMATION ON INTERLOCK, SEE MAP DATED: 8-17-1961 BY C.B. HALLCOCK JR.