


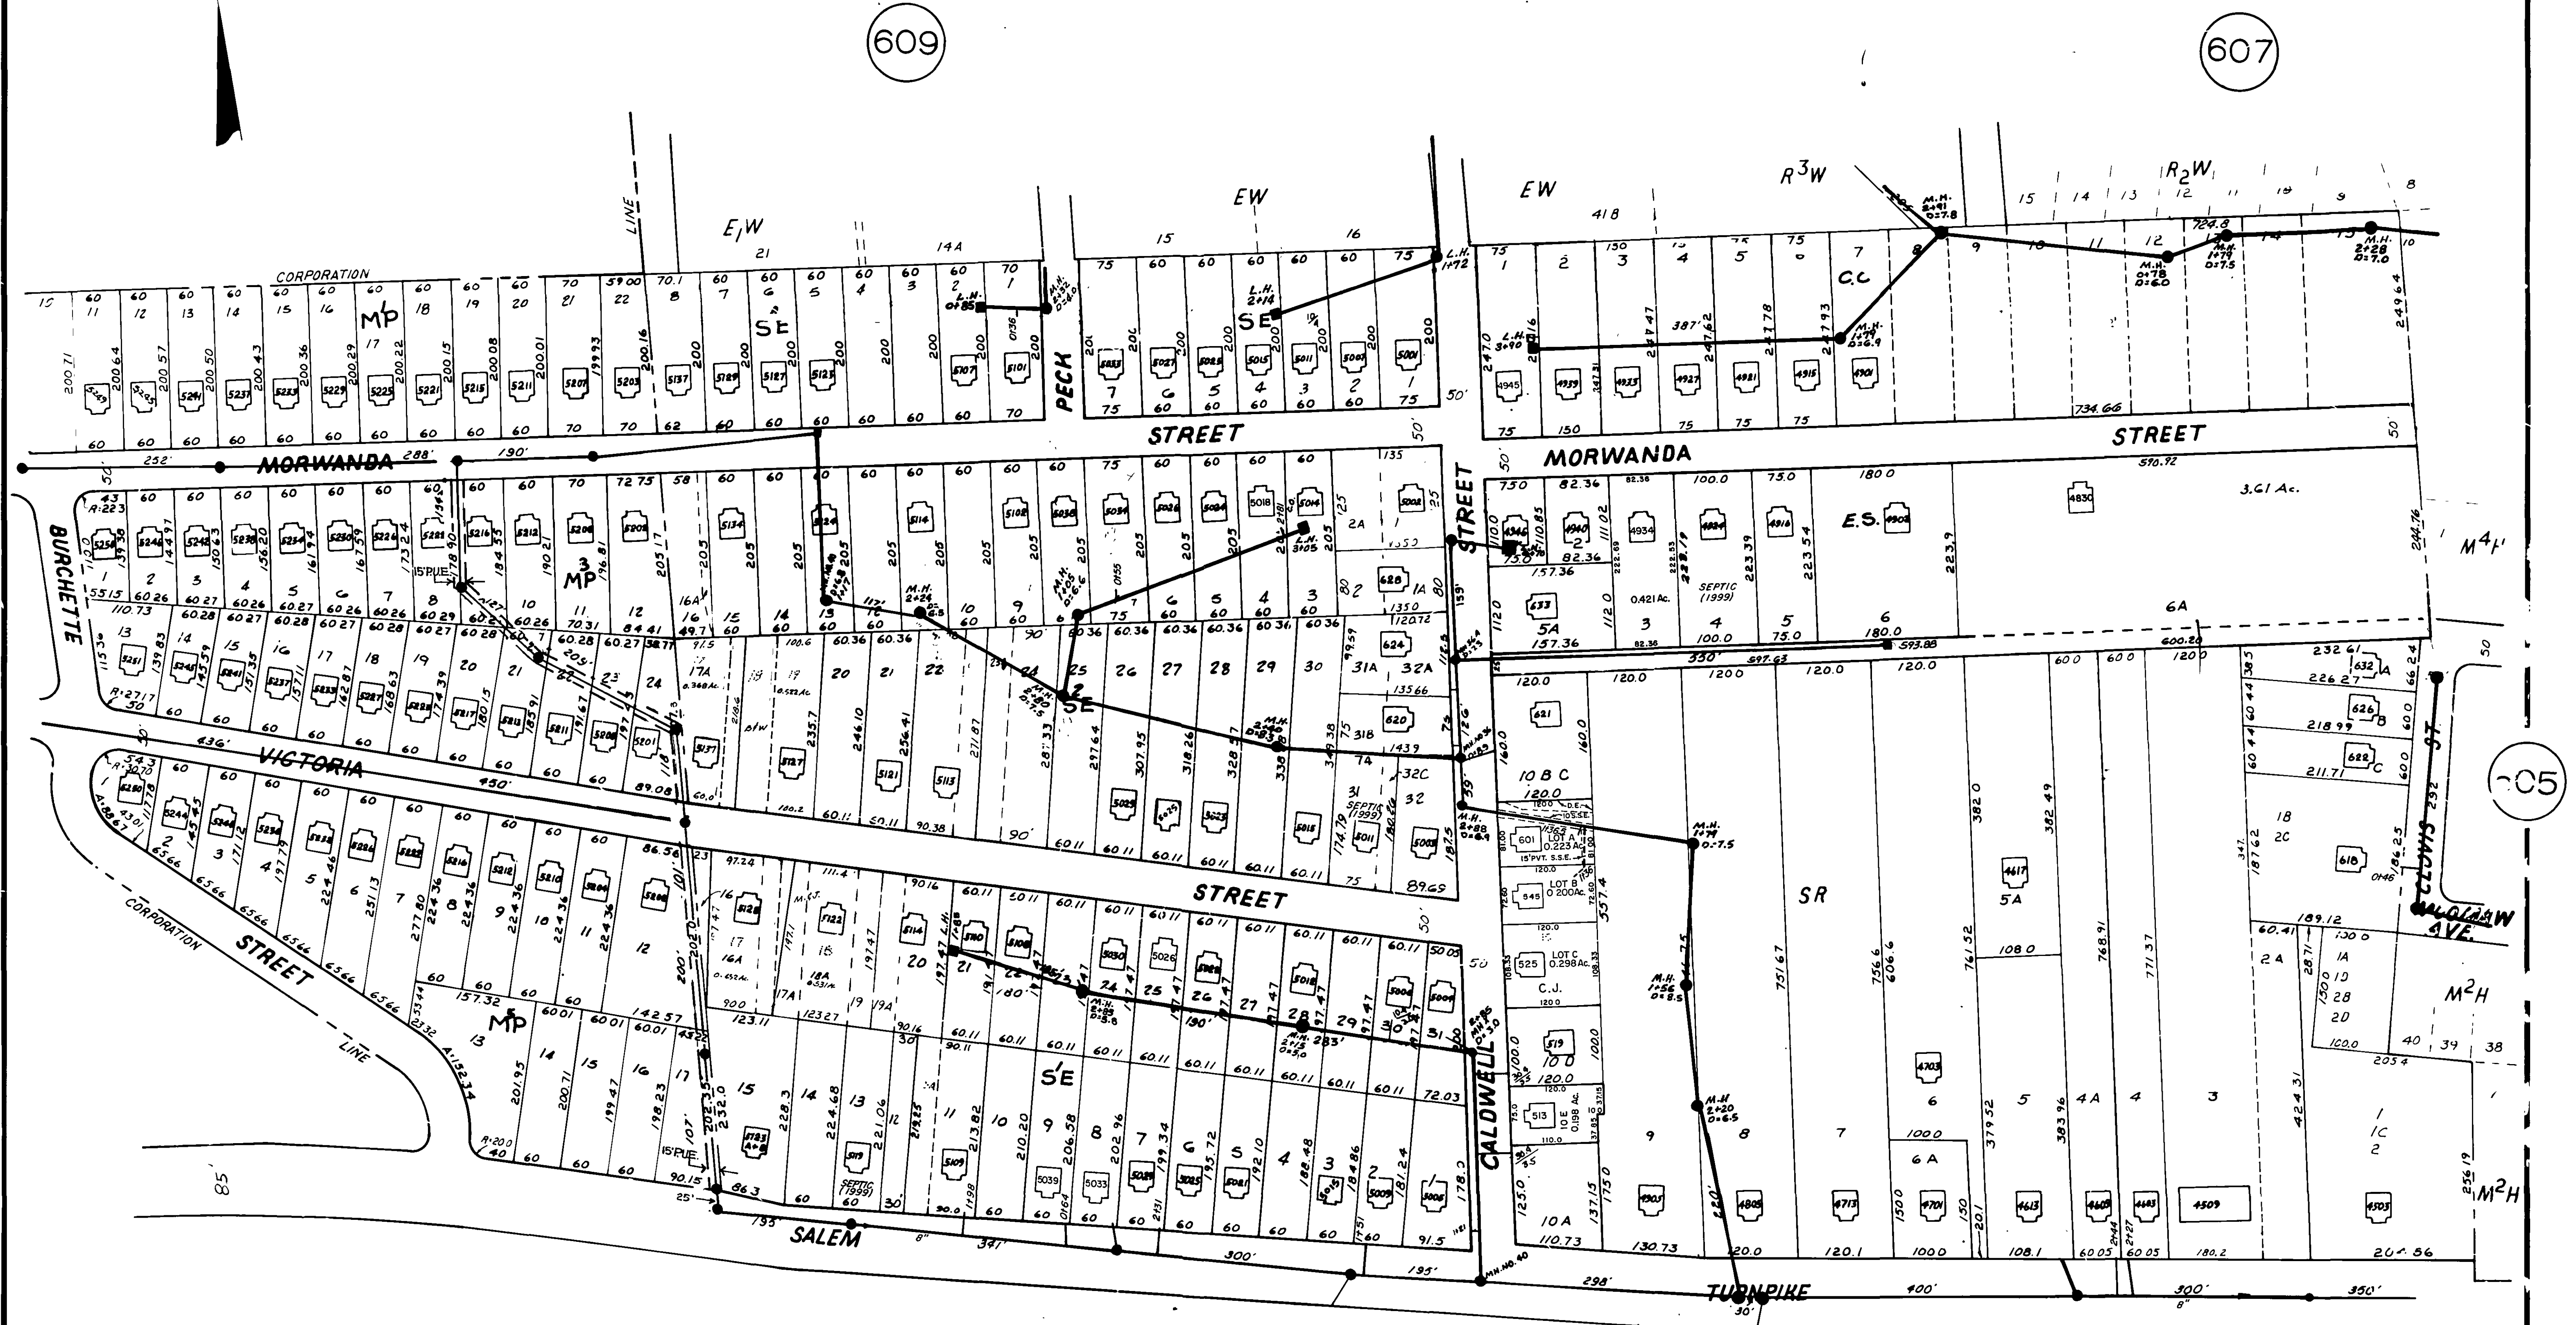

SEWER INFORMATION: AS BUILT PLANS 64-6

NOTICE:
The location of features and utilities are shown on this map in so far as their existence and location were known at the time of the preparation of this map. Nothing on this map shall be construed as a guarantee that any feature or utility are in the location indicated or that they actually exist.

CESAL REFERENCE
M.R. - MORWANDA PARK - P.B. 3, P. 212
S.E. - SOUTH EDEWOOD - P.B. 2, P. 128
E.S. - E.F. SPOED SUBDIVISION
C.C. - C.R. CLARK SUBDIVISION
S.R. - SUNNY RIDGE
M.H. - MOOMAW HEIGHTS - P.B. 2, P. 216
P.W. - ROLLING WOODS - P.B. 8, P. 54
P.W. - ROLLING WOODS - SEC. 2, P.B. 9, P. 13
C.W. - EDEWOOD - P.B. 1, P. 122
E.W. - EDEWOOD ADDITION - P.B. 1, P. 243
C.J. - LAURA J. CONLEY & ROXIE H. JOHNSON - M.B. 1, P. 1225

SEWER MAP
CITY OF ROANOKE, VA.
SHEET NO. 608
OFFICE OF THE CITY ENGINEER

DRAWN BY: _____ DATE: _____
FIELD WORK BY: _____ DATE: _____
RECORD & JURY BY: _____ DATE: _____
CHECKED BY: _____ DATE: _____
SCALE: 1" = 100' REVIS: _____

CITY ENGINEER