


DATE COMP.	825 87 8			
FEET MAIN	SIZE	VALVE	VAULT	BOX
300	6" #1			
BLOWOFF	2"			1
F. H. COMP.	-0-			
F. H. STUB ONLY	-0-			
SERV. INS. BY:	<i>Alv. O. Paine</i>			
MAIN INS. BY:	<i>Alv. O. Paine</i>			
NO. 3/4" SERV. INS.				
CITY OR CO.	ROANOKE			
DEPT. INSP.				

507

400' 505
600' #3
original
Water Sheet

AS BUILT:
Alv. O. Paine

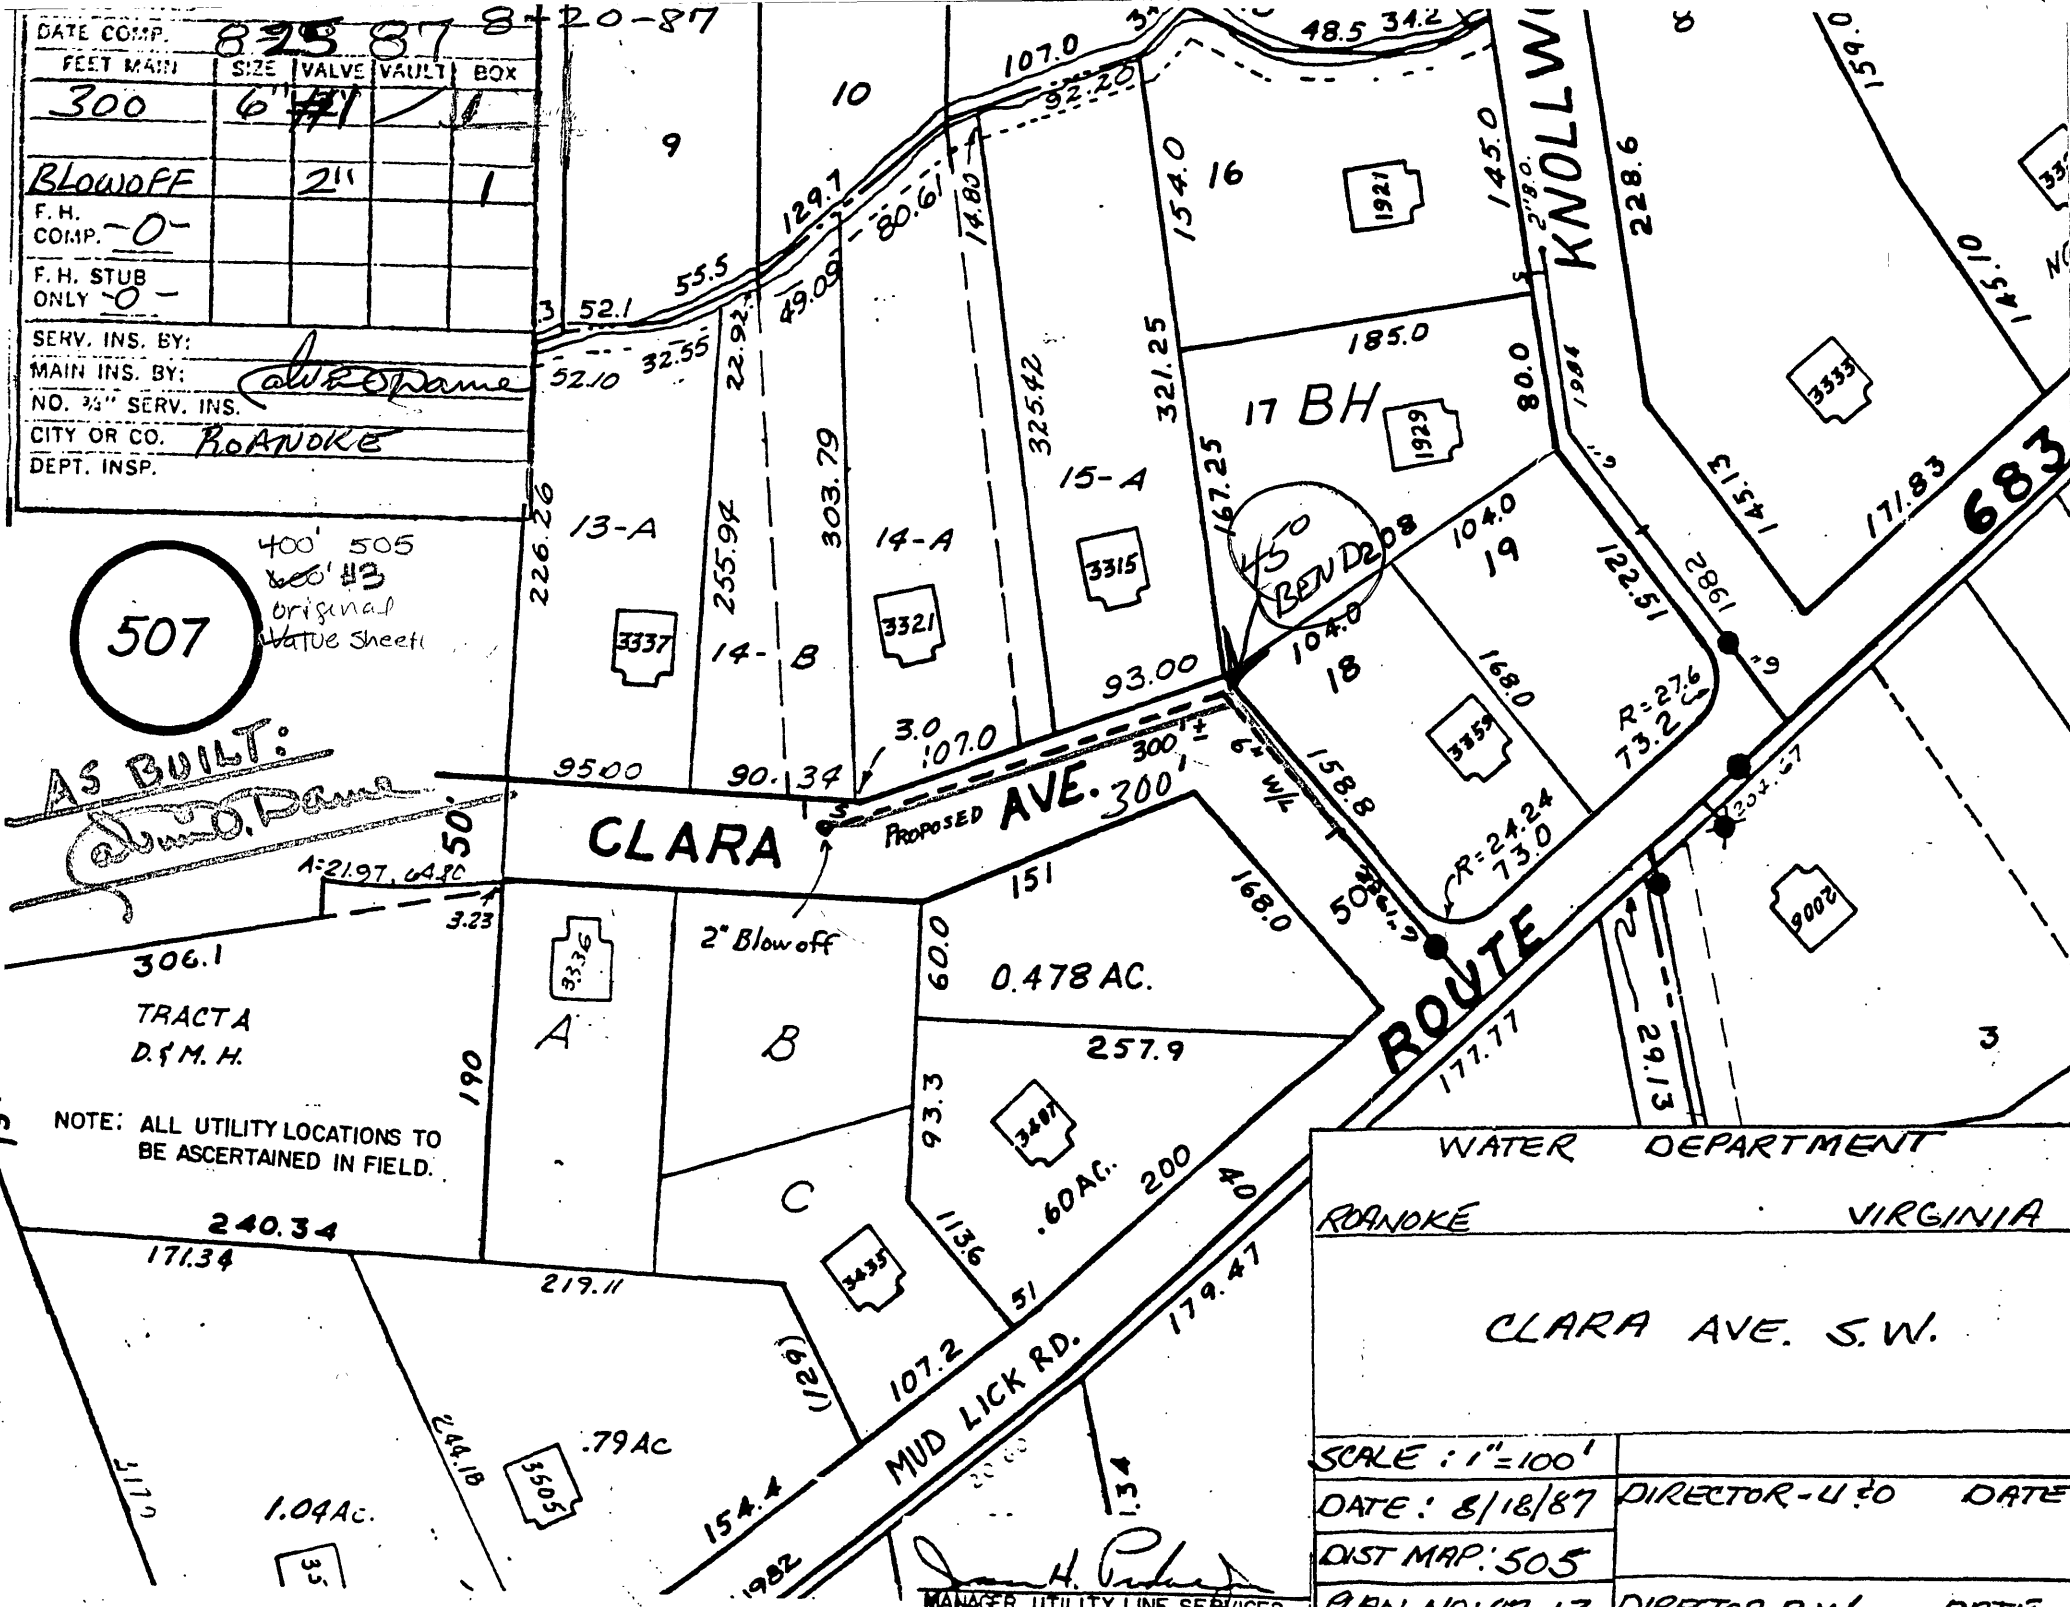

NOTE: ALL UTILITY LOCATIONS TO BE ASCERTAINED IN FIELD.

WATER DEPARTMENT
ROANOKE VIRGINIA

CLARA AVE. S.W.

SCALE: 1"=100'	
DATE: 8/18/87	DIRECTOR-UFO DATE
DIST MAP: 505	
PLAN NO: 87-12	DIRECTOR-P.W. DATE

James H. Paine
MANAGER, UTILITY LINE SERVICES