



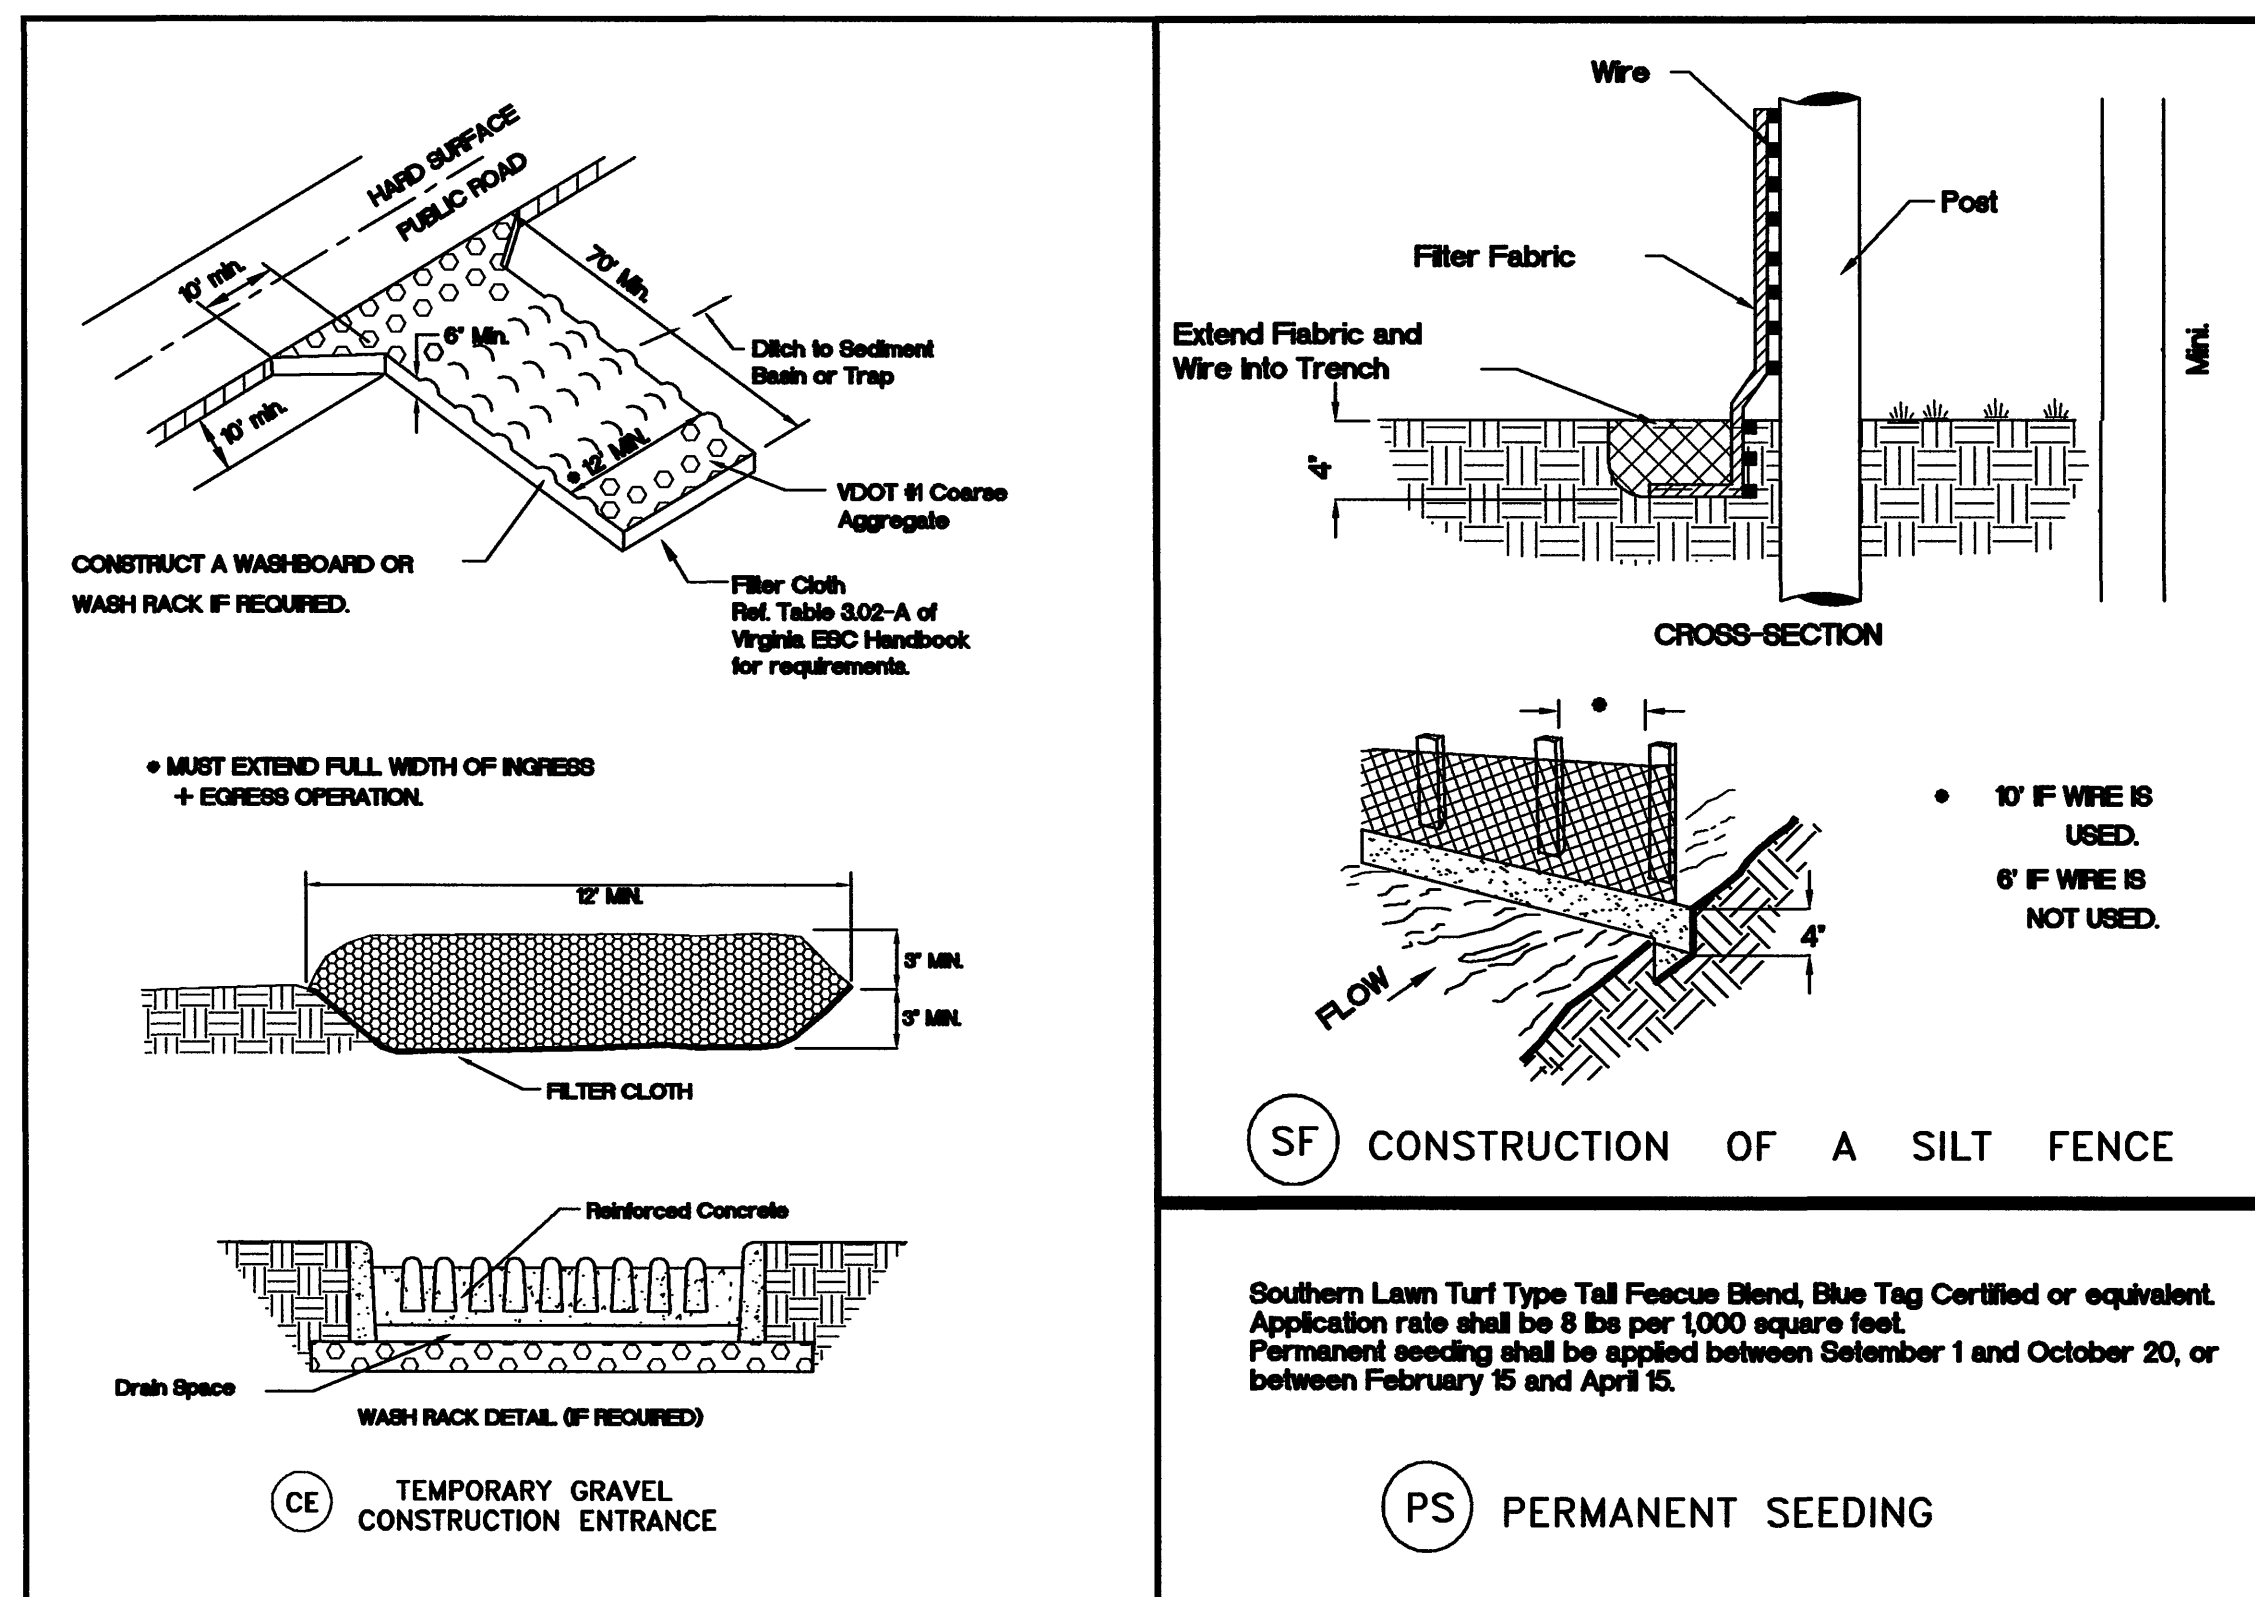


Record Drawings 5/1/2006

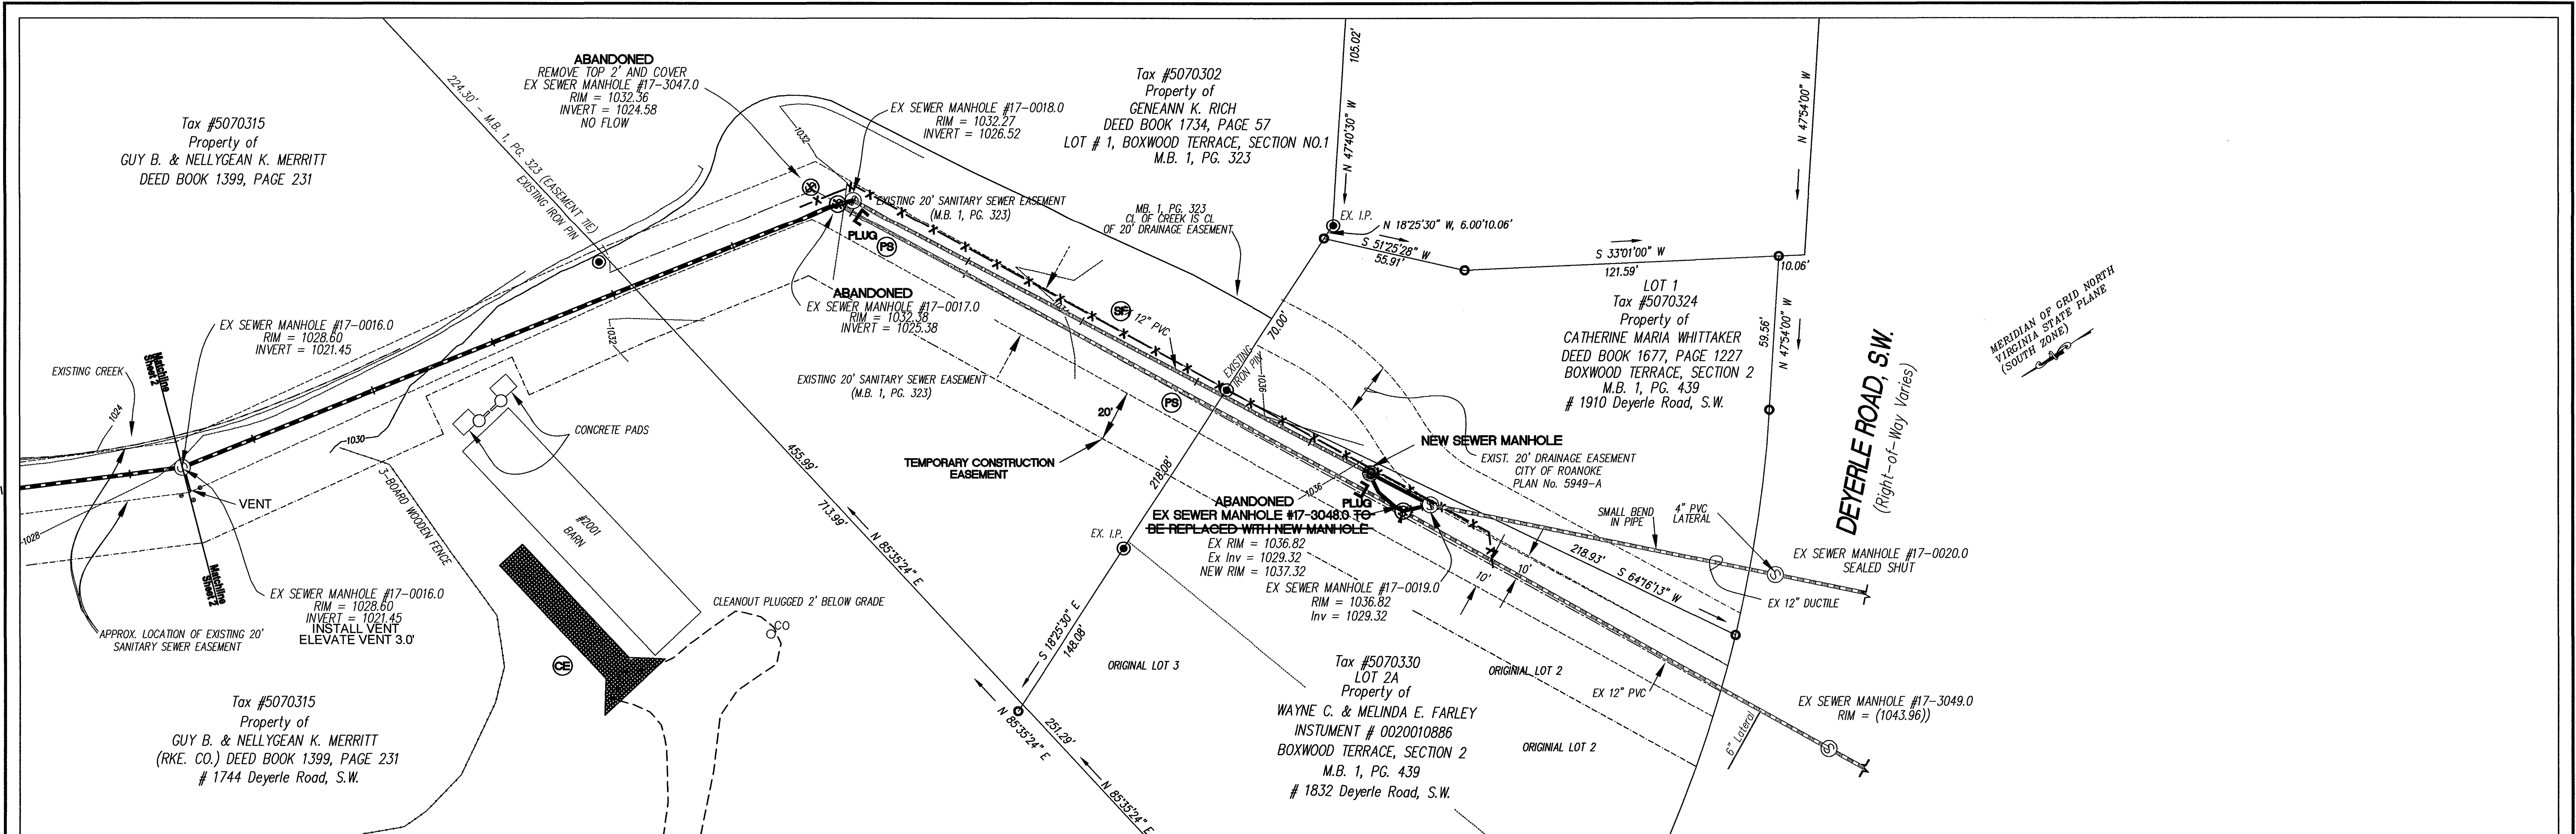

ENGINEERING SERVICES
601 S. JEFFERSON STREET
ROANOKE, VIRGINIA 24011
PHONE: (540) 853-5641

DESIGNED:
CDA
DRAWN:
CDA
CHECKED:
JGR

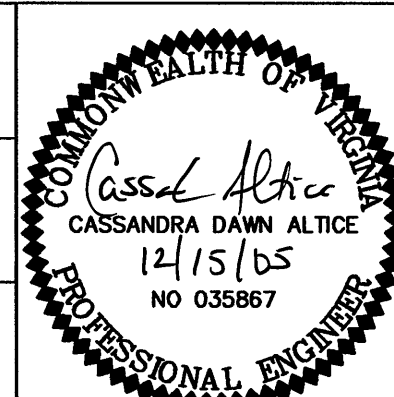

VERTICAL SCALE:
1" = 5'
HORIZONTAL SCALE:
1" = 30'

REV.	DATE:	DESCRIPTION
	5/1/06	ASBUILT

DATE:
3/15/06
AUTOCAD DRAWING NAME:

CLARA AVENUE SEWER UPSIZING -
PIPEBURSTING/OPEN CUT OPTION
EROSION AND SEDIMENT CONTROL PLAN
CITY of ROANOKE, VIRGINIA

SHEET
4 of 5
PLAN NO.
6HAL94