


* All 8" Pipe, AND 8" BENDS WERE
 MEGA LUGED AND RODDED FROM 8"
 METER VAULT TO 16" WATER MAIN.
 3455 Colonial Ave, S.W.
 8" meter + vault on 16" water main.



AEP
 301-2095

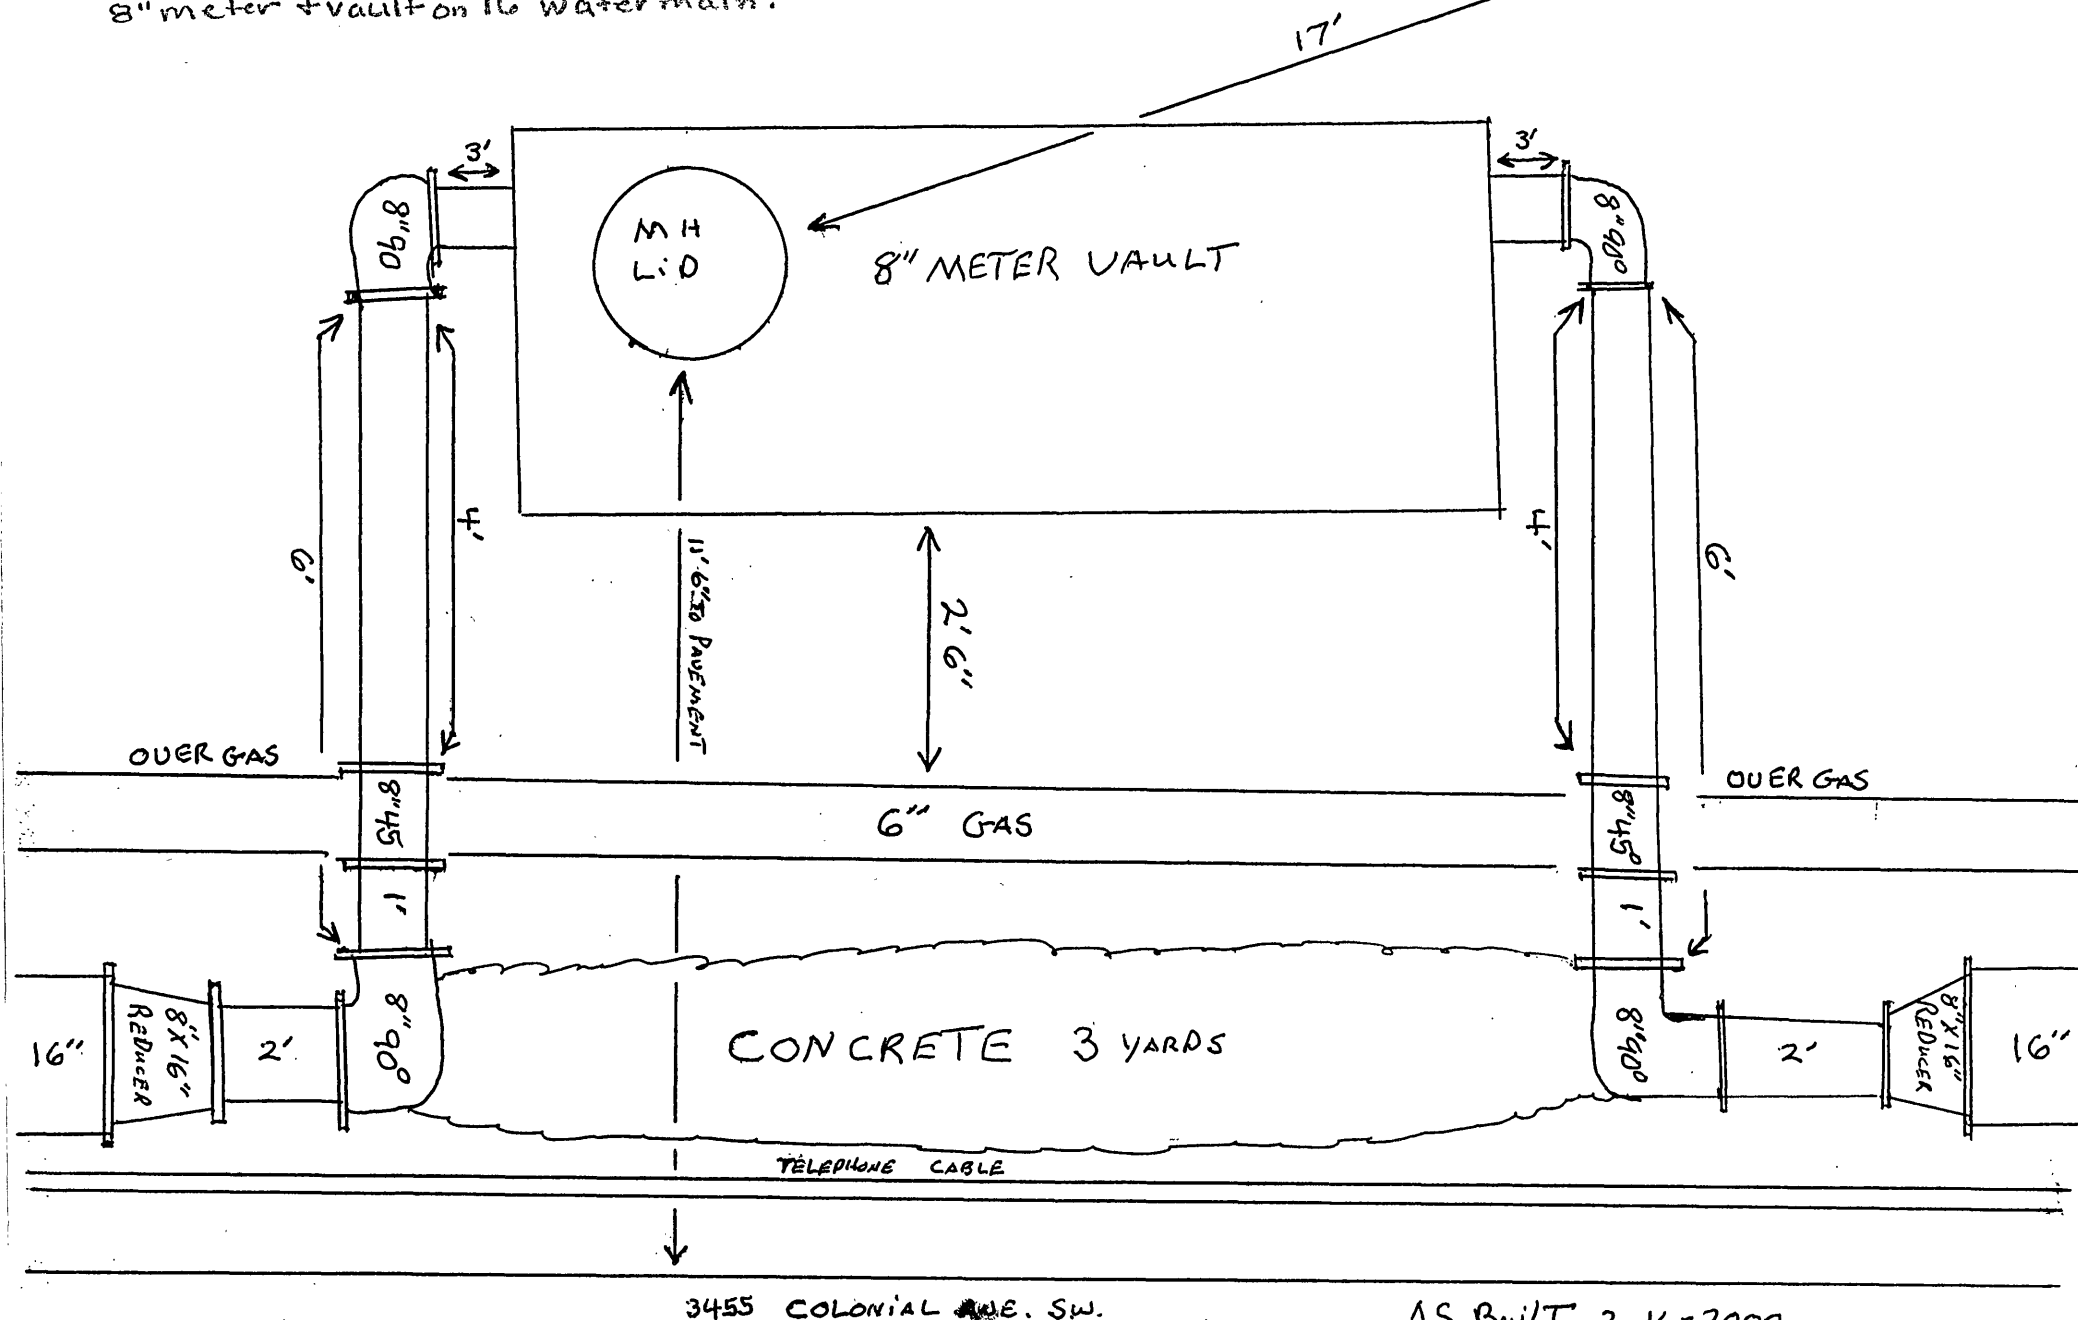

3455 COLONIAL AVE. SW.

AS BUILT 2-16-2000

Handwritten signature