


FISHBURN PARK
ELEMENTARY SCHOOL
(ing valve)

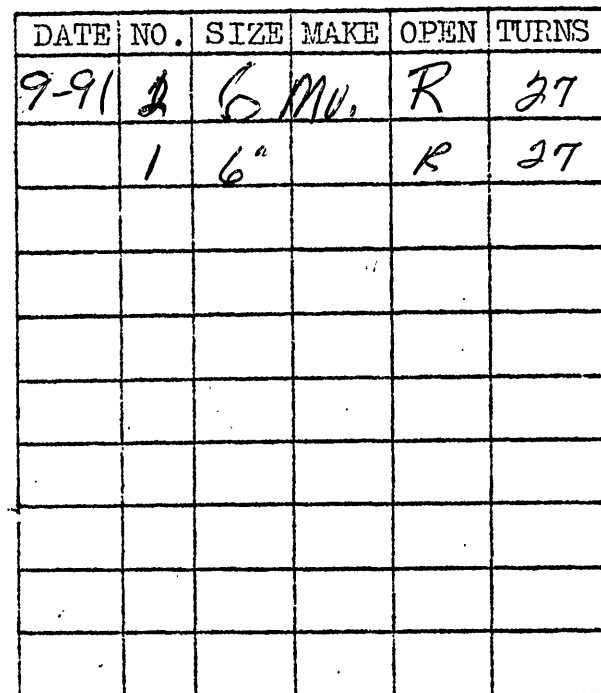

CITY OF ROANOKE - WATER DEPT.	
VALVE DIAGRAM	
COLONIAL AVE SW	
at Fishburn Park School	
Sec. Map	
Date	Page No.