


COLONIAL AVENUE AS-BUILTS

SYMBOL LEGEND	
	Sign
	Water Manhole
	Fire Hydrant
	Water Valve
	Sanitary Sewer Manhole
	Storm Drainage Manhole
	Communication Vault
	Light Pole
	Electric Vault
	Bike Lane
	Mailbox
	Handi-Cap Parking

ABBREVIATIONS	DESCRIPTION
BWL	Broken White Line
C	Communication/Utility Vault
CC-2	VOT Curb (6 inch)
CC-3	VOT Curb (4 inch)
CC-9	VOT Concrete Entrance
CC-12	VOT Handi-Cap Ramp
CP	Corrugated Plastic Pipe
DI	VOT Drop Inlet
DL	Ductile Iron Line
EL	Electric Vault
EM	VOT Drainage Manhole
EM-2	VOT Concrete Shoulder
PVC	Polyvinyl Chloride Pipe
RCP	Reinforced Concrete Pipe
SML	Solid White Line
SYL	Solid Yellow Line
X	Existing

Pattern Legend	
	Asphalt (Road/Parking)
	Concrete
	Mulched or Planted Bed
	Vegetation
	Rip-Rap
	Metal

Linetype Legend	
Linetype	Description
	Metal Fence
	Storm Drainage Pipe

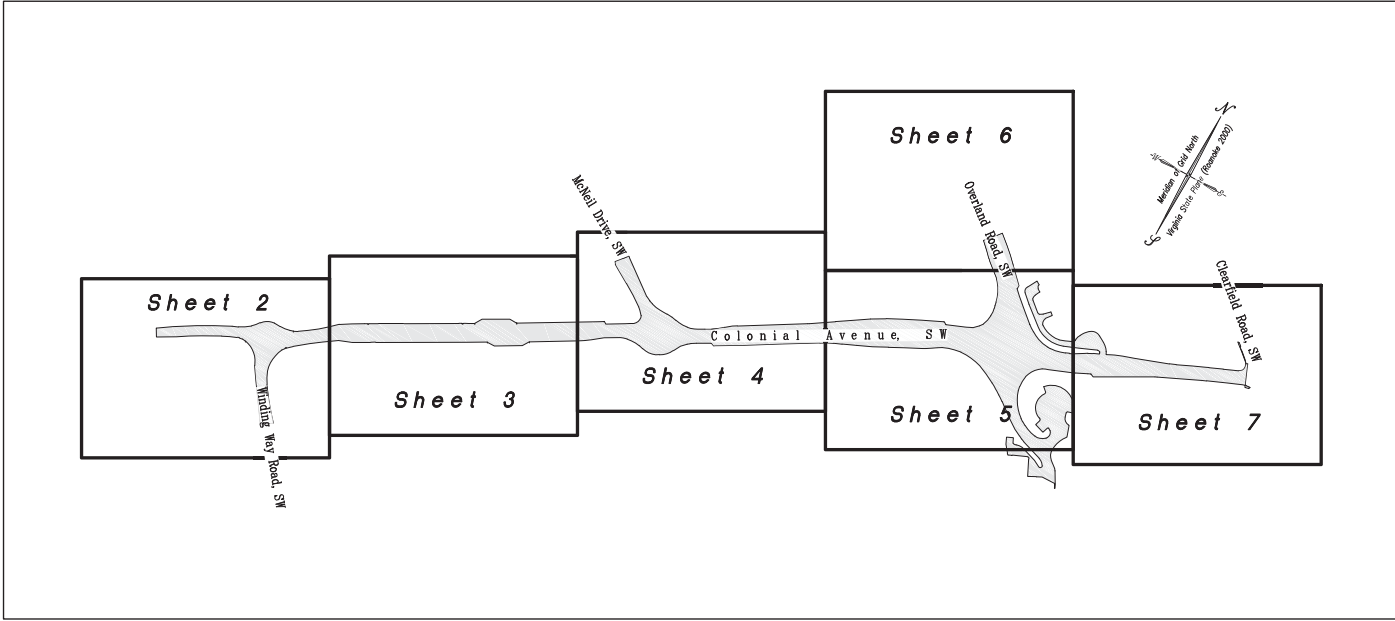

LEGEND
 AEP - RED
 COX - MAGENTA
 RVBA - ORANGE
 VERIZON - CYAN
 WINDSTREAM - GREEN
 WWA - BLUE

NOTE: DUCTBANK WAS
 INSTALLED ON THE NORTH SIDE
 OF COLONIAL AVENUE UNDER
 AND BEHIND THE SIDEWALK.
 SEE ATTACHED DETAIL FOR
 TYPICAL LAYOUT.

Graphic Scale
 0' 25' 50' 100'
 1" inch = 50' feet

Construction As-Built Survey of a portion of
COLONIAL AVENUE, S.W.
 situated along Colonial Avenue, SW from the intersection of Winding Way Road, SW
 running easterly to the intersection with Clearfield Road, SW
 prepared for
 Roanoke, Virginia
The City of Roanoke, Virginia

NO.	DATE	DESCRIPTION

DATE: September 29, 2020

SCALE: None

COMMISSION NO: 2020-129

SHEET 1 OF 7