


As-Built Storm Drainage Table #1

#	STRUCTURE	THROAT	R/W	GRATE	TOP	INV.OUT	INV.IN	INV.IN(2)
SD-8	D-1					1071.95 (15" RCP)		
SD-7	D-3A	2.5'	1079.69'	1078.06'		1071.77 (18" RCP)	1071.98 (18" RCP)	
SD-5	D-1					1069.68' (24" RCP)	1070.18 (18" RCP)	
SD-3	D-3B	8'	1078.19'			1066.99' (24" RCP)	1067.04' (24" RCP)	
SD-2	D-2B	10'			1068.75'	1070.29'	1069.25' (24" RCP)	
SD-1	D-1					1069.15'	1067.81' (24" RCP)	1068.30' (15" RCP) SW

As-Built Storm Drainage Table #2

#	STRUCTURE	THROAT	R/W	GRATE	TOP	INV.OUT	INV.IN	INV.IN(2)	INV.IN(3)
SD-6	D-2B	12'			1075.10'	1075.67'	1070.65' (15" RCP)		
SD-1	D-1					1057.61' (24" RCP)	1058.30' (15" RCP) SW	1058.02' (24" RCP) NE	
M-5	MH-2 (5')				1067.21'	1055.87' (x36" RCP)	1055.98' (24" RCP) W	1062.64' (48" PVC) SW	1055.98' +/- (x24" RCP) NW
M-6	MH-2 (5')				1064.12'	1052.92' (x36" RCP)	1053.19' (36" RCP) W	1060.47' (6" PVC) S	
ST-5	MH-2 (4')				1060.85'	1052.19' (x36" RCP)	1052.22' (x36" RCP)		1053.28' (15" RCP) NW
ST-6	MH-2 (5')				1057.23'	1050.53' (36" RCP)	1050.83' (x36" RCP) SW	1050.73' (15" RCP) NW	
SD-13	D-3C	10'			1052.83'	1041.28' (36" RCP)	1041.38' (36" RCP) SW	1042.79' (15" RCP) NW	
M-8	MH-2 (5')				1041.23'	1037.45' (36" RCP)	1037.69' (36" RCP) SW	1037.73' (15" RCP) NW	
M-9	MH-2 (5')				1042.88'	1032.70' (x30" RCP)	1035.30' (36" RCP) SW	1033.05' (30" RCP) NW	1032.75' (18" RCP) NE

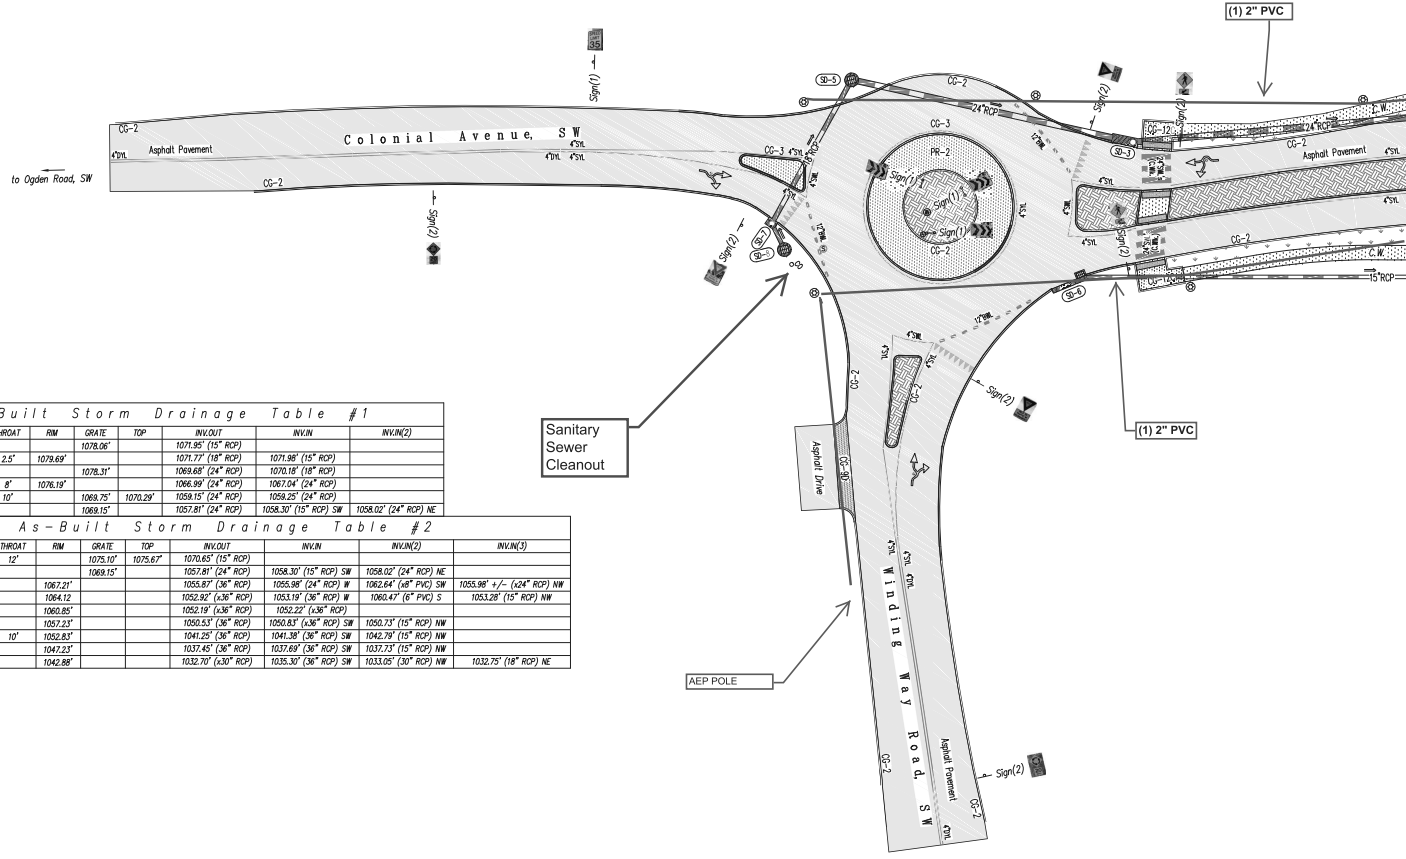

Matchline Sheet 3

Matchline Sheet 3

Construction As-Built Survey of a portion of
 Colonial Avenue, SW
 situated along Colonial Avenue, SW from the intersection of Winding Way Road, SW
 running easterly to the intersection with Charfield Road, SW
 prepared for
 The City of Roanoke, Virginia

NO.	DATE	DESCRIPTION
1		
2		
3		
4		
5		

DATE: September 29, 2020
 SCALE: None
 COMMISSION NO.: 2020-129
 SHEET 2 OF 7

Graphic Scale
 0' 25' 50' 100'
 1" inch = 50' feet