



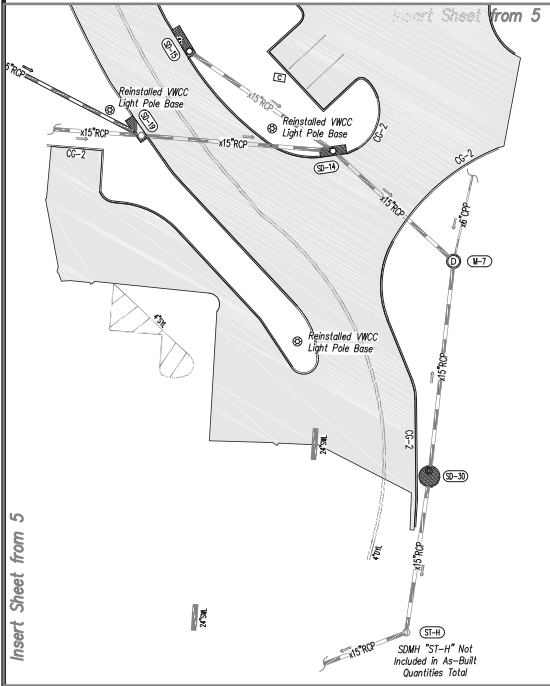

Insert Sheet from 5

Matchline Sheet 5

As-Built Storm Drainage Table #12						
#	STRUCTURE	THROAT	RIW	GRATE	INV.OUT	INV.IN
ST-C	DI		1034.77		1031.67 (x18" RCP)	
ST-B	MI-2 (4')		1036.26		1026.39 (x18" RCP)	1030.44 (x18" RCP) SE
As-Built Storm Drainage Table #13						
#	STRUCTURE	THROAT	RIW	GRATE	INV.OUT	INV.IN
SD-17	D-3B	8"	1035.68		1029.01 (15" RCP)	
SD-16	D-3B	4"	1030.39		1024.66 (15" RCP)	
SD-19	D-3B	8"	1027.41		1020.96 (x15" RCP) SW	1020.91 (15" RCP) W
SD-14	D-3C	8"	1024.33		1020.27 (x15" RCP)	1020.38 (x15" RCP) W
M-7	MI-2 (4')		1022.42		1018.40 (x15" RCP)	1018.62 (x15" RCP)
SD-30	MI-2 (6')		1018.82		1015.26 (x15" RCP)	1015.36 (x15" RCP)
ST-H	MI-2 (3')		1015.99		1011.03 (x15" RCP)	1011.44 (x15" RCP)

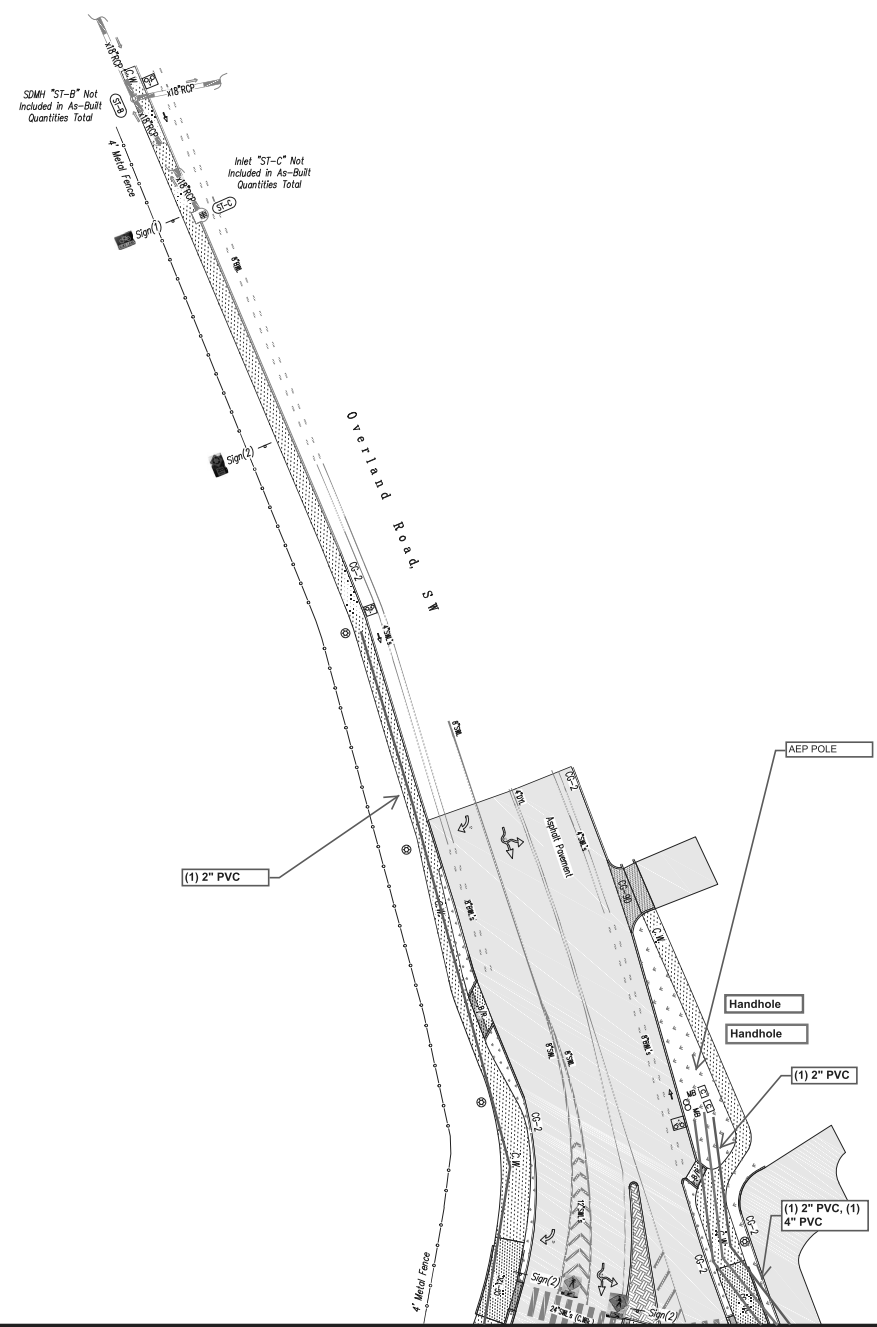

Matchline Sheet 5

Construction As-Built Survey of a portion of
Colonial Avenue, SW from the intersection of Windy Way Road, SW
running easterly to the intersection with Oakfield Road, SW
Prepared for
The City of Roanoke, Virginia

NO.	DATE	DESCRIPTION
1	9/29/2020	Initial Survey
2		
3		
4		
5		

DATE: September 29, 2020
SCALE: None
COMMISSION NO: 2020-129
SHEET 6 OF 7