

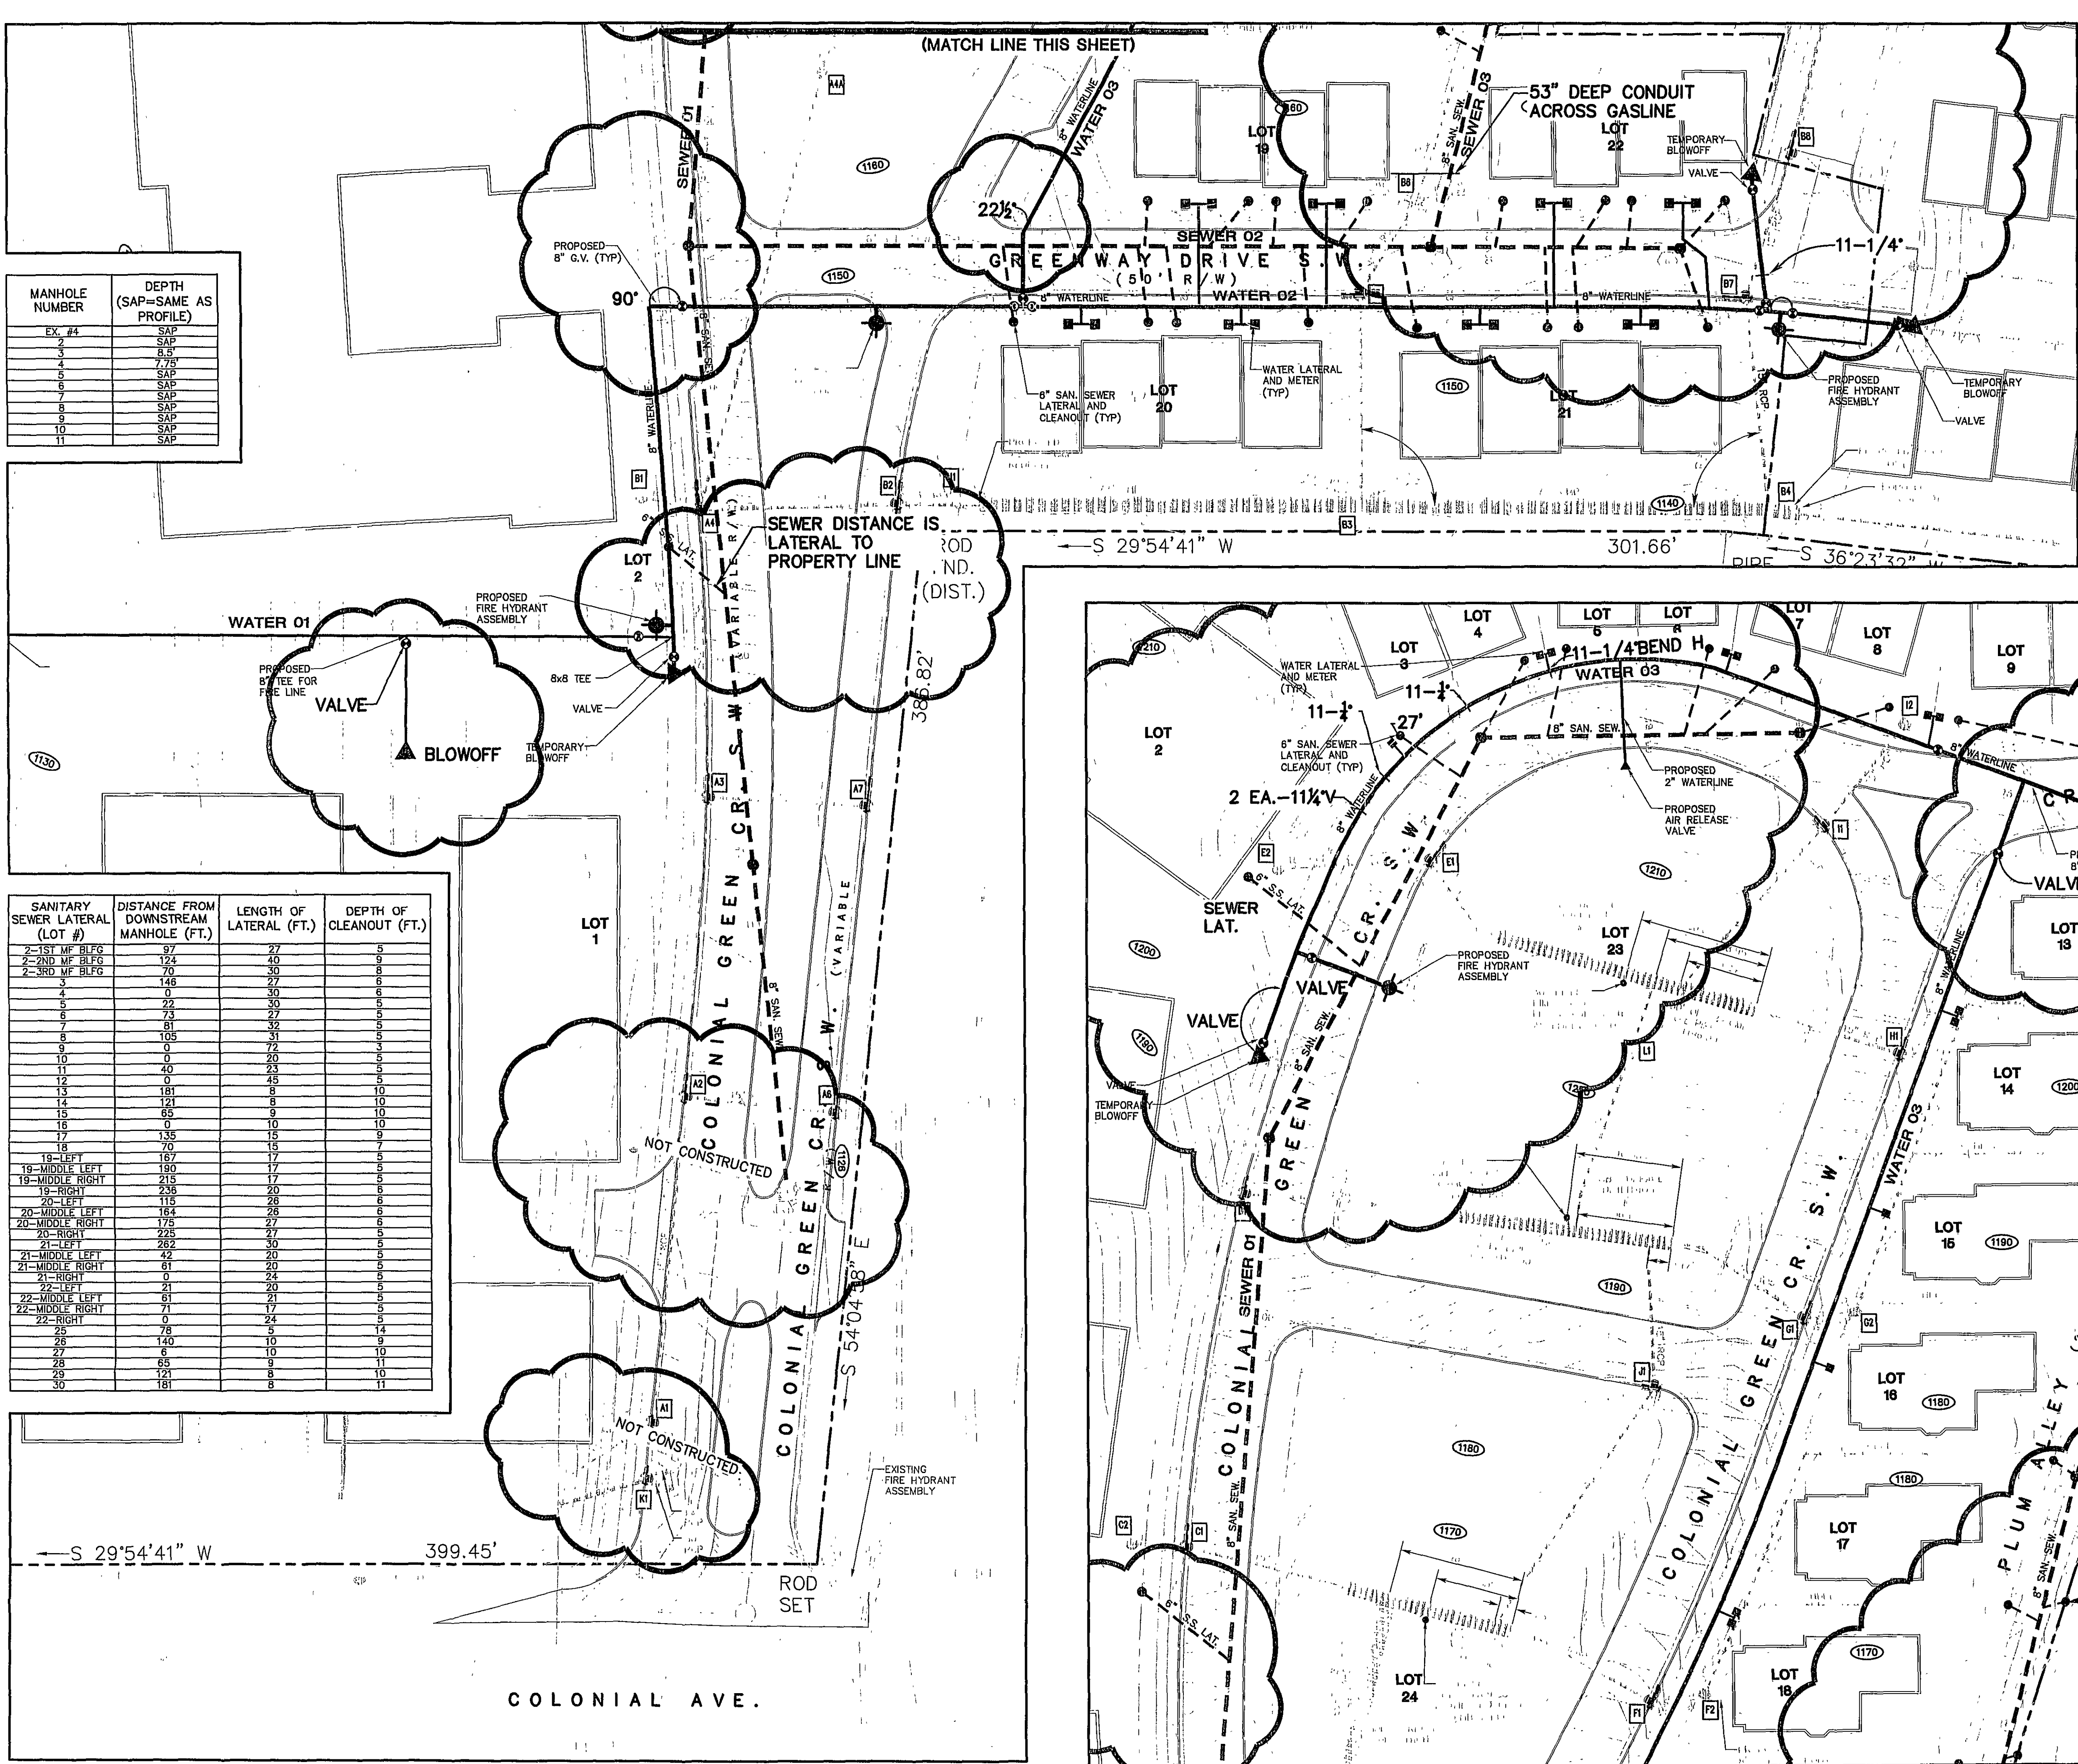


MANHOLE NUMBER	DEPTH (SAP=SAME AS PROFILE)
EX. #4	SAP
2	SAP
3	SAP
4	SAP
5	SAP
6	SAP
7	SAP
8	SAP
9	SAP
10	SAP
11	SAP

SANITARY SEWER LATERAL (LOT #)	DISTANCE FROM DOWNSTREAM MANHOLE (FT.)	LENGTH OF LATERAL (FT.)	DEPTH OF CLEANOUT (FT.)
2-1ST MF BFLG	97	27	5
2-2ND MF BFLG	124	40	6
2-3RD MF BFLG	146	30	6
3	0	30	6
4	0	30	6
5	22	30	5
6	73	27	5
7	81	32	5
8	105	31	5
9	0	72	5
10	0	20	5
11	40	23	5
12	0	45	10
13	181	15	10
14	121	8	10
15	65	9	10
16	0	10	10
17	70	15	9
18	187	17	5
19-MIDDLE LEFT	190	17	5
19-MIDDLE RIGHT	215	17	5
19-RIGHT	236	20	6
20-LEFT	115	28	6
20-MIDDLE LEFT	164	25	6
20-MIDDLE RIGHT	175	27	5
20-RIGHT	225	20	5
21-LEFT	262	30	5
21-MIDDLE LEFT	42	20	5
21-MIDDLE RIGHT	61	20	5
21-RIGHT	0	24	5
22-LEFT	0	20	5
22-MIDDLE LEFT	61	21	5
22-MIDDLE RIGHT	71	17	5
22-RIGHT	0	24	5
23	78	3	14
24	140	10	9
25	6	10	10
26	65	6	10
27	121	8	10
30	181		11

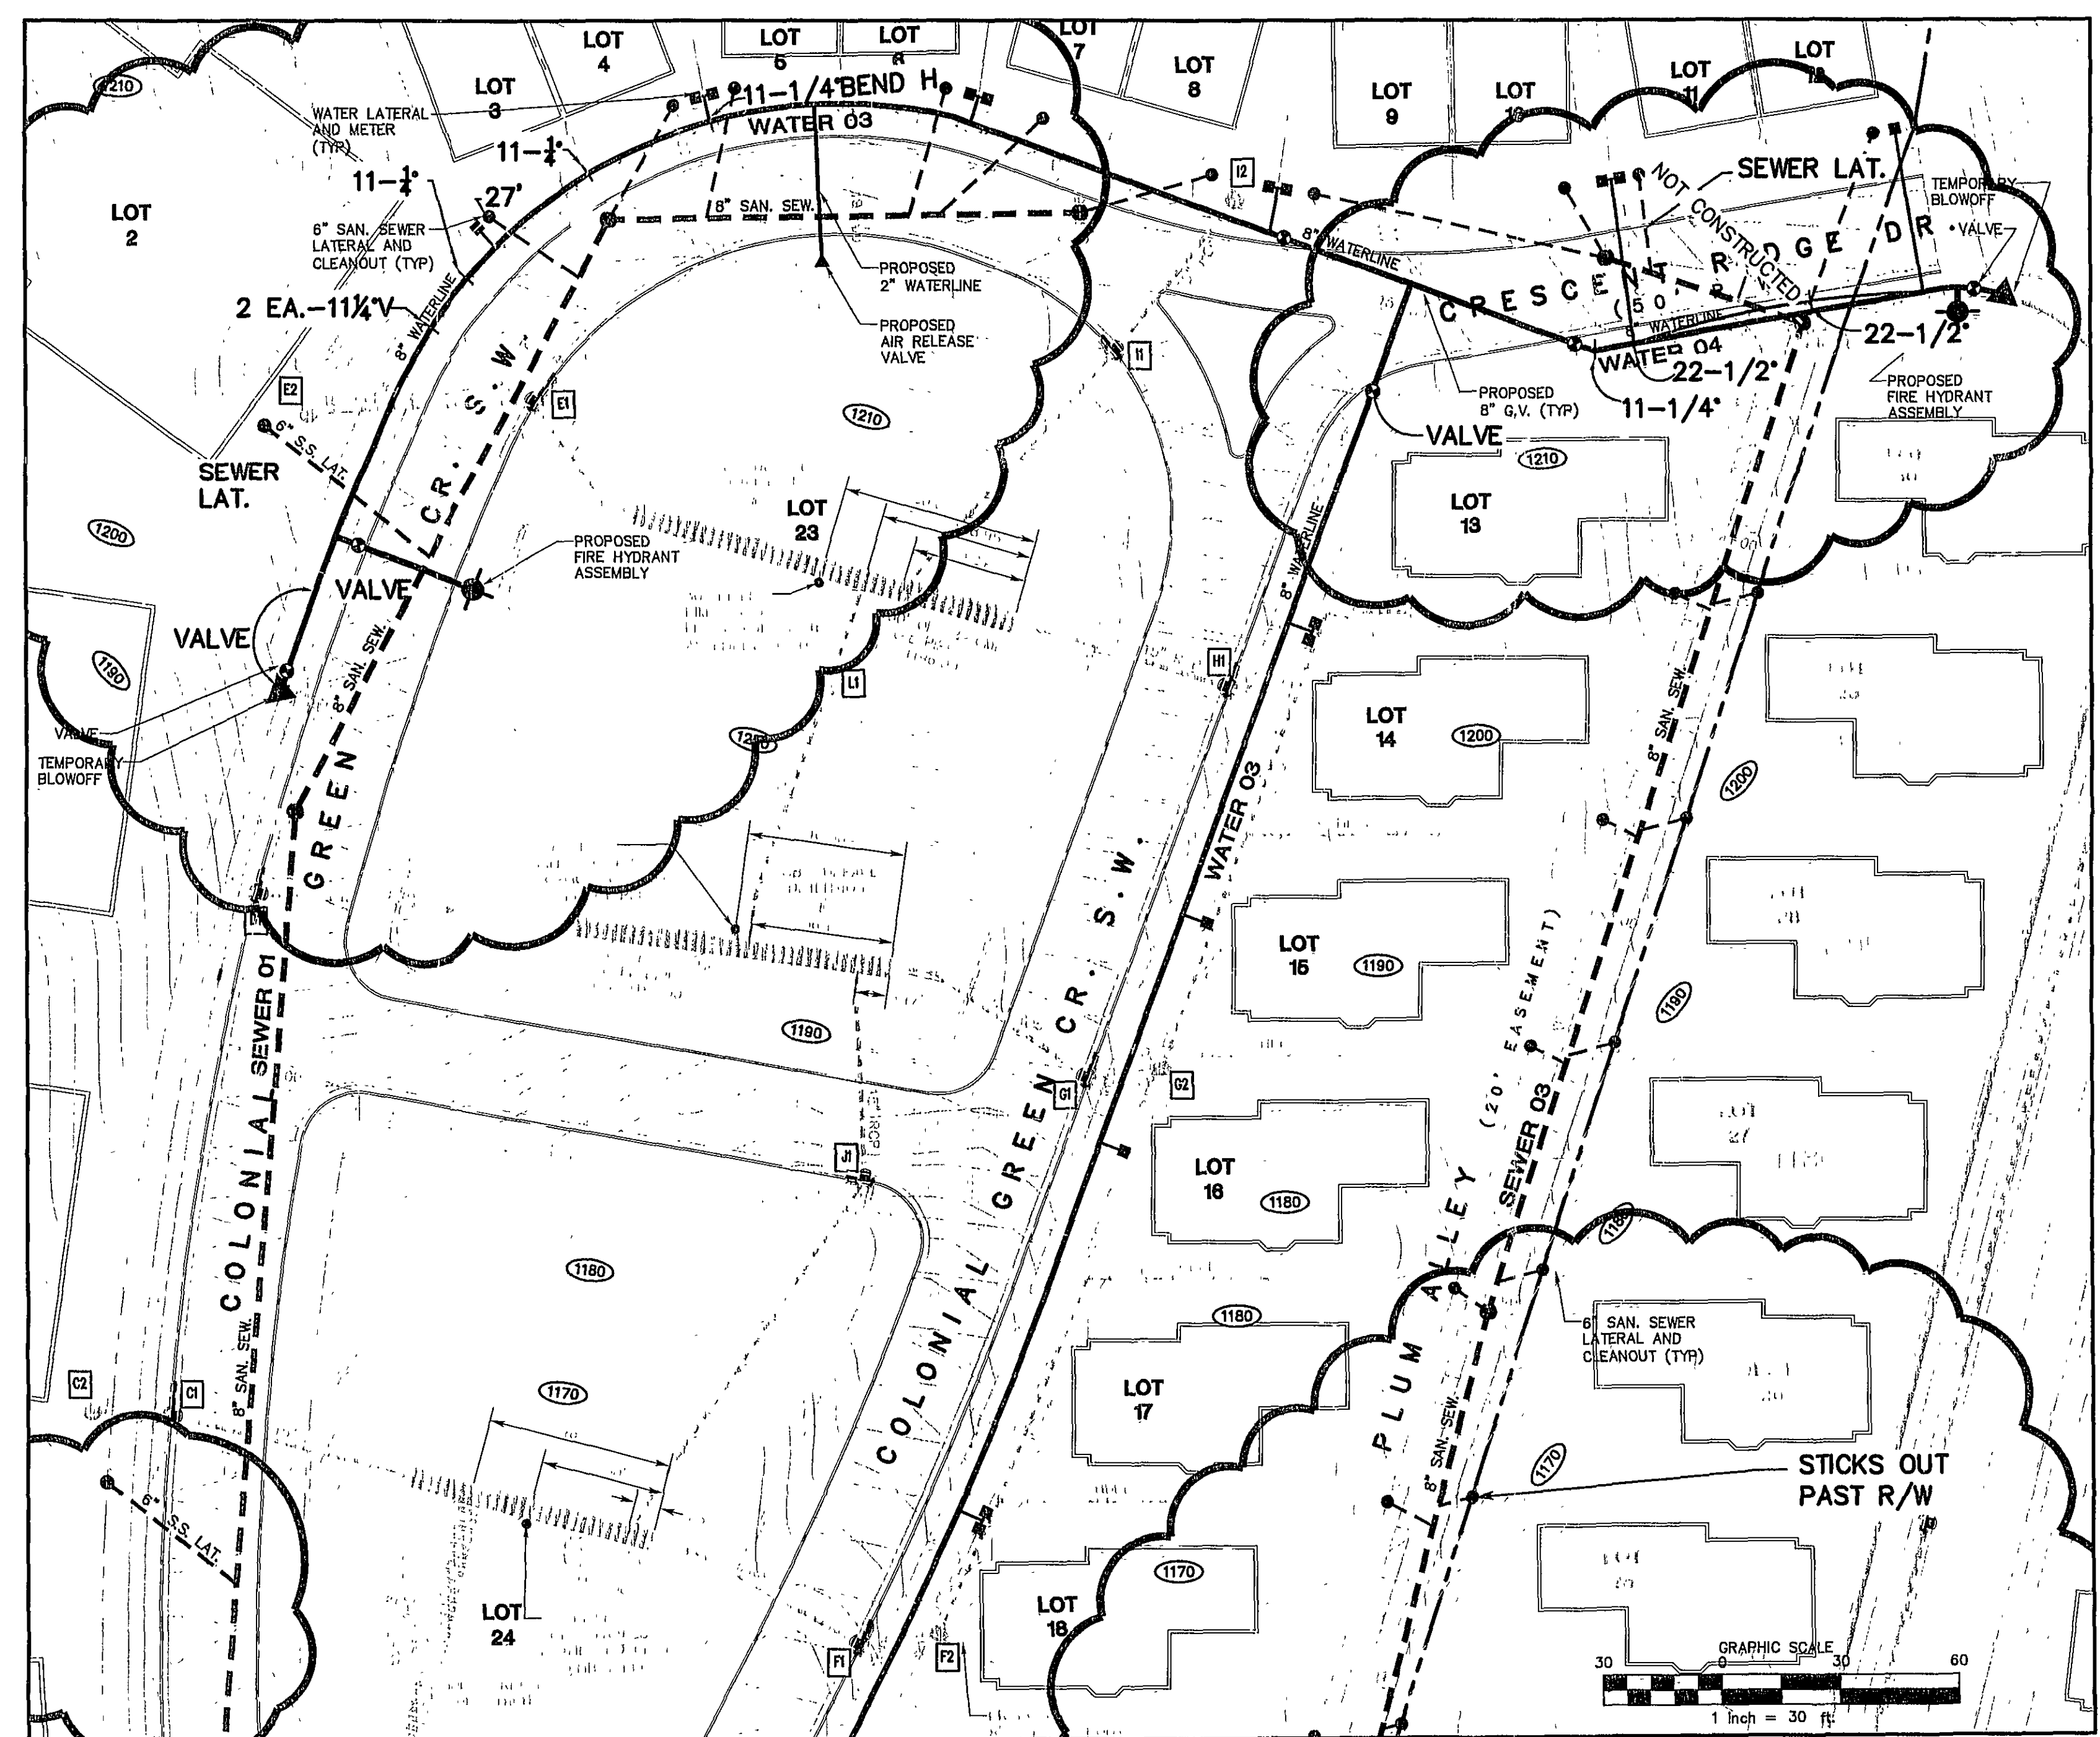


- NOTES:**
1. AS-BUILT INFORMATION AS SHOWN HEREON HAS BEEN PROVIDED BY PROPERTY OWNER AND CONTRACTOR. INFORMATION IS SHOWN FOR INFORMATIONAL PURPOSES ONLY.
 2. ALL CLEANOUTS WERE INSTALLED AT PROPERTY LINES.
 3. NO FIELD SURVEY HAS BEEN PERFORMED AS A PART OF THIS AS-BUILT PLAN.

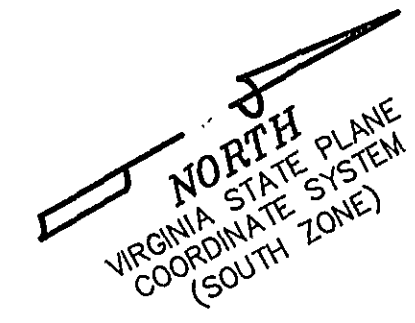

GAY AND NEEL, INC.
 CIVIL ENGINEERING
 LAND PLANNING
 SURVEYING
 328 Mountain Avenue S.W.
 Roanoke, Virginia 24016
 Phone: (540) 345-1110 Fax: (540) 345-5560
 Email: info@gayandneel.com

Water and Sewer
 AS-BUILTS

Colonial Green
 Phase I Plan
 for Colonial Green, L.C.
 Located on Colonial Avenue
 City of Roanoke, Virginia

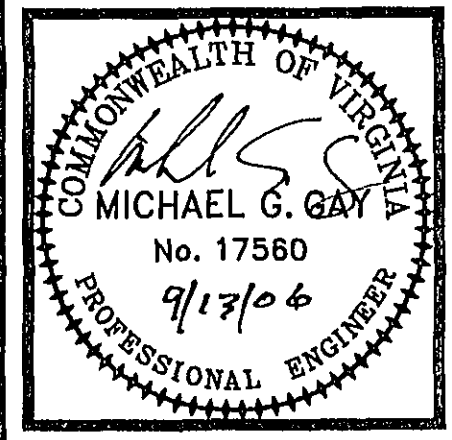

REVISED:
 09/12/06
PRINTED ON
 SEP 13 2006
 WWW.ID# 606MLK

DESIGNED/CALC.: RBF
 CHECKED: AJM
 DRAWN: 1"=30'
 SCALE: 07/20/06
 DATE:
 JOB NO. 1380.4
 SHEET 1 OF 1