


DATE STARTED		3-25-86			
DATE COMP.		5-16-86			
FEET MAIN	SIZE	VALVE	VAULT	BOX	
225	8"	8"		#2	
F. H. COMP. 0					
F. H. STUB ONLY 0					
SERV. INS. BY: BECKLY HEATING					
MAIN INS. BY: " "					
NO. 3/4" SERV. INS. 1					
CITY OR CO. CITY					
DEPT. II ENGINEERING BILL DIVERS					

T# 6530102
3695 Thirlane Rd, N.W.

COMFORT INN PROPERTY

PROVIDE STANDARD
FIRE SERVICE CONN.

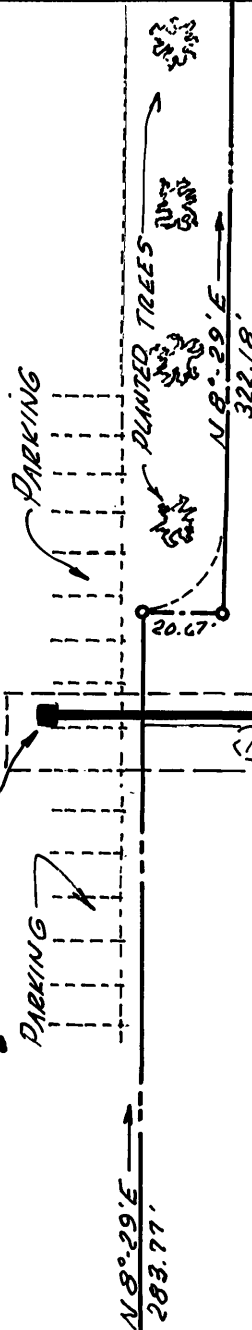

REMOVE PLUG AT EXISTING
8" X 6" TEE AND MAKE NEW
8" WATER LINE CONNECTION
AS SHOWN.

NOTE: SHADED AREA DESIGNATES
CONST. LIMIT & EXTENDED W.L. EASE.

T# 6530103
OUTLET MALL BUILDING

'Celebration Station'
3601 Thirlane Rd, N.W.

EDGE B.T.

225 FT. OF 8" WATER MAIN EXTENSION

EXIST. 8" WATER MAIN

EDGE B.T.

EXIST. W.L. EASE.

EXIST. 8" X 6" TEE, 6" GATE
VALVE, AND HYDR. ASSY.

AS-BUILT DISTRIBUTION MAP 653

ROANOKE OFFICE OF CITY ENGINEER VIRGINIA

**8" WATER MAIN EXTENSION
FROM OUTLET MALL
SERVING COMFORT INN PROPERTY**

APPROVAL

William J. Clark DATE 2/28/86
DIRECTOR OF PUBLIC WORKS
Art B. Lin DATE 2/28/86
DIRECTOR OF UTILITIES & OPERATIONS

SCALE 1" = 50'
DATE 02-28-86
FIELD BK. N/A
PLAN NO. 86-03

APPROVED: *Charles M. Huffine*
CITY ENGINEER

APPROVED: _____