

GENERAL NOTES

PRE-CONSTRUCTION MEETING AND CONSTRUCTION COMMENCEMENT:


- All construction methods and materials shall conform to the Construction Standards and Specifications of Roanoke County, the Western Virginia Water Authority, and the Virginia Department of Transportation.
- Stormwater Management Agreements with an attached 8 1/2" x 11" or 8 1/2" x 14" plat must be approved and recorded prior to the pre-construction meeting.
- Once all required items are submitted to the County of Roanoke, the developer must contact the Development Review Coordinator to indicate that a pre-construction meeting needs to be scheduled. The pre-construction meeting will be scheduled with the owner/developer two (2) working days later.
- All land disturbing projects that require approval of an erosion and sediment control plan, grading or clearing permit shall require that the applicant provide the name of an individual who will be responsible for land disturbing activities and that this individual hold a Responsible Land Disturber (RLD) Certificate from the Department of Environmental Quality. The Responsible Land Disturber can be anyone from the Project team that is certified by the Commonwealth of Virginia to be in charge of carrying out the land disturbing activity for the project.
- It is the responsibility of the owner/developer to notify the certified Responsible Land Disturber and the Utility Contractor to attend the pre-construction meeting.
- The Development Review Coordinator will schedule the pre-construction meeting with the County Review Engineer, the County Inspector, and the Western Virginia Water Authority and the Town of Vinton Public Works Department if applicable.
- An approved set of plans, Storm Water Pollution Prevention Plan (SWPPP), VSMP coverage letter, and all permits must be available at the construction site at all times.
- The developer and/or contractor shall supply all utility companies with copies of approved plans, advising them that all grading and installation shall conform to approved plans.
- The project engineer will inform the owner/developer verbally and in writing of the County's obligation to perform inspections on site. Everyone in the meeting will be required to sign a pre-construction checklist indicating their knowledge of Roanoke County's obligation to perform inspections on site.
- The Erosion Control Permit or Combined Erosion Control & VSMP Permit is given to the developer at this pre-construction meeting.
- Notify the County of Roanoke prior to beginning installation of ESC measures. The County will inspect initial installations to ensure compliance with approved plan prior to start of grading. The developer SHALL contact the project inspector 24 hours before beginning any grading or construction on the property.
- County inspectors must inspect storm drain / stormwater management / BMP installations during the process of installation. Please contact the site inspector 24 hours in advance.
- All work shall be subject to inspection by Roanoke County, the Western Virginia Water Authority and the Virginia Department of Transportation inspectors.
- Contractors shall notify utilities of proposed construction at least two (2), but not more than ten (10) working days in advance. Area public utilities may be notified thru "Miss Utility": 1-800-552-7001 or VA 811.
- The 100 year Floodway shall be staked prior to any construction.
- Grade stakes shall be set for all curb and gutter, culvert, sanitary sewer and storm sewer at all times of construction.
- The Department of Community Development shall be notified when a spring is encountered during construction.
- Construction debris shall be containerized in accordance with the Virginia Litter Control Act. No less than one litter receptacle shall be provided on site.
- The contractor shall provide adequate means of cleaning mud from trucks and/or other equipment prior to entering public streets or rights of ways. It is the contractors responsibility to insure that the streets are in a clean, mud and dust free condition at all times.
- Plan approval in no way relieves the developer or contractors of the responsibilities contained within the erosion and sediment control or stormwater management policies.
- Field construction shall honor proposed drainage divides as shown on plans.
- Field corrections shall be approved by the Roanoke County Engineering Division and/or the Western Virginia Water Authority and the Professional of Record, prior to such construction.
- The developer or contractor shall supply the County and the Western Virginia Water Authority with correct As-Built plans before final acceptance.

VIRGINIA DEPARTMENT OF TRANSPORTATION:

- Plan approval by Roanoke County does not guarantee issuance of any permits by the Virginia Department of Transportation.
- A permit must be obtained from the Virginia Department of Transportation, Salem Residency Office prior to construction in the highway right-of-way.
- The preliminary pavement designs should be based on a predicted sub-grade CBR value of 7.0 and with a Resiliency Factor (RF) of 2.0 as shown in Appendix I of the 2000 Virginia Department of Transportation Pavement Design Guide for Subdivision and Secondary Roads. The sub-grade soil is to be tested by an independent laboratory and the results submitted to the Virginia Department of Transportation prior to base construction. Should the sub-grade CBR value and/or the RF value be less than the predicted values, additional base material will be required in accordance with Departmental specifications. Refer to the same manual as the number and locations of the required soil samples to be tested. All pavement designs shall be submitted to the Department for review and approval. The sub-grade shall be approved by the Virginia Department of Transportation prior to placement of the base. Base shall be approved by the Virginia Department of Transportation for depth, template, and compaction before the surface is applied.
- Standard guardrail with safety end sections may be required on fills or in areas where hazards exist as deemed necessary. After completion of rough grading operations, the County Engineer and Virginia Department of Transportation shall be contacted to schedule a field review. Where guard rail is warranted, the standard shoulder width shall be provided and the guard rail shall be installed in accordance with the 2001 VDOT Road and Bridge Standards as part of this development.
- Standard street and traffic control signs shall be erected at each intersection by the developer prior to final street acceptance.
- All traffic devices shall be in accordance with current edition of the "Manual on Uniform Traffic Control Devices" (MUTCD).
- All unsuitable material shall be removed from the construction limits of the roadway before placing embankment.

See Sheet C06 for Stormwater Site Statistics Table.
See Sheet C08 for New BMP Information Table.

The Project Engineer shall provide electronic copies of the approved plans to the Development Review Coordinator within 5 working days of the pre-construction meeting.
The notes on this sheet shall not be modified.

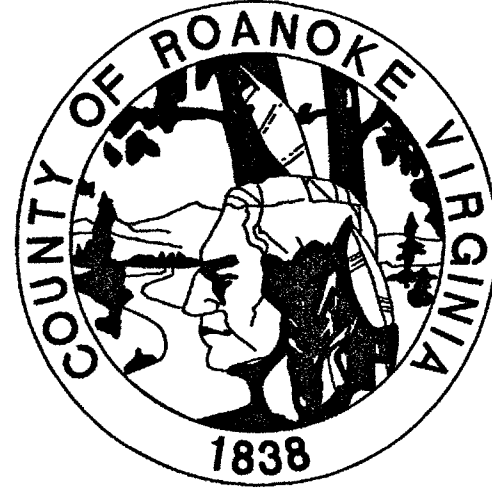

COUNTY OF ROANOKE, VA

NAME OF DEVELOPMENT	Commercial Retail Store	I, PARKER DESIGN GROUP , OWNER/DEVELOPER, AM AWARE OF THE SITE DESIGN REQUIREMENTS IMPOSED BY THIS SITE DEVELOPMENT PLAN AND OTHER APPLICABLE ROANOKE COUNTY CODES. I HEREBY CERTIFY THAT I AGREE TO COMPLY WITH THESE REQUIREMENTS AND THE THIRTY (30) POINTS SHOWN ON THIS COVER SHEET UNLESS MODIFIED IN ACCORDANCE WITH LOCAL LAW.	
MAGISTERIAL DISTRICT(S)	HOLLINS		
OWNER(S)	Douglas and Dana Kerfer 59 Eagle Ridge Roanoke, VA 24012	CONTACT: MELISSA BALLARD	RESPONSIBLE LAND DISTURBER: Jeremy Baker RLD #38678 (expires 6/27/2019) Phone: (423) 538-7135
DEVELOPER	The Broadway Group 216 Westside Square Huntsville, AL 35801 256-533-7287		
ENGINEER & SURVEYOR	PARKER DESIGN GROUP 2122 Carolina Ave, SW Roanoke, VA 24014 540-387-1153	CONTACT: SIMON RUTROUGH	
TAX MAP NO(S)	027.18-06-02, 027.18-06-03, 027.18-06-04, 027.18-06-05		

WATER NOTES

All water facilities shall be constructed according to the Western Virginia Regional Design and Construction Standards (Latest Edition).

A minimum cover of three (3) feet is required over proposed lines.

Contractor shall be responsible for locating and uncovering valve vaults after paving and adjustment to final grade if necessary.

All existing utilities may not be shown in their exact location. The contractor shall comply with the (State Water Works Regulations, Section 12VAC5-590-1150, where lines cross.

All trenches in existing or future highway right-of-ways shall be compacted according to Virginia Department of Transportation standards.


Lines shall be staked prior to construction.

Water main shall be minimum Class 350 Ductile Iron in accordance to AWWA C151 or DR-14 PVC in accordance with AWWA C-900.


Ductile Iron Pipe in accordance with the Western Virginia Regional Design and Construction Standards shall be required for all pipe with a working pressure equal to or greater than 100 p.s.i.

New water service is planned.

Western Virginia Water Authority
Availability letter number: AL 16-348

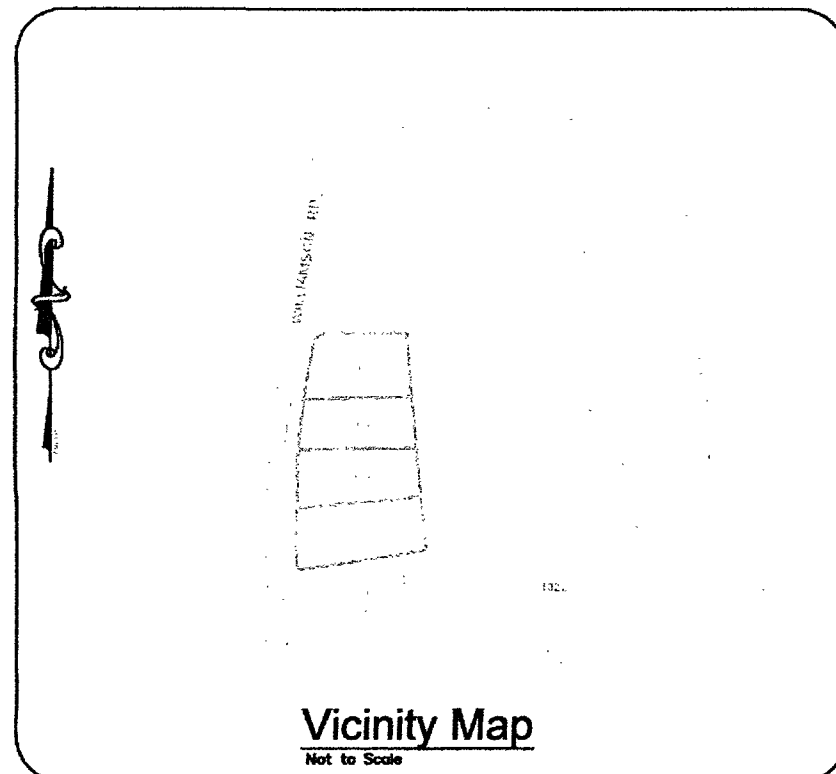

LEGEND

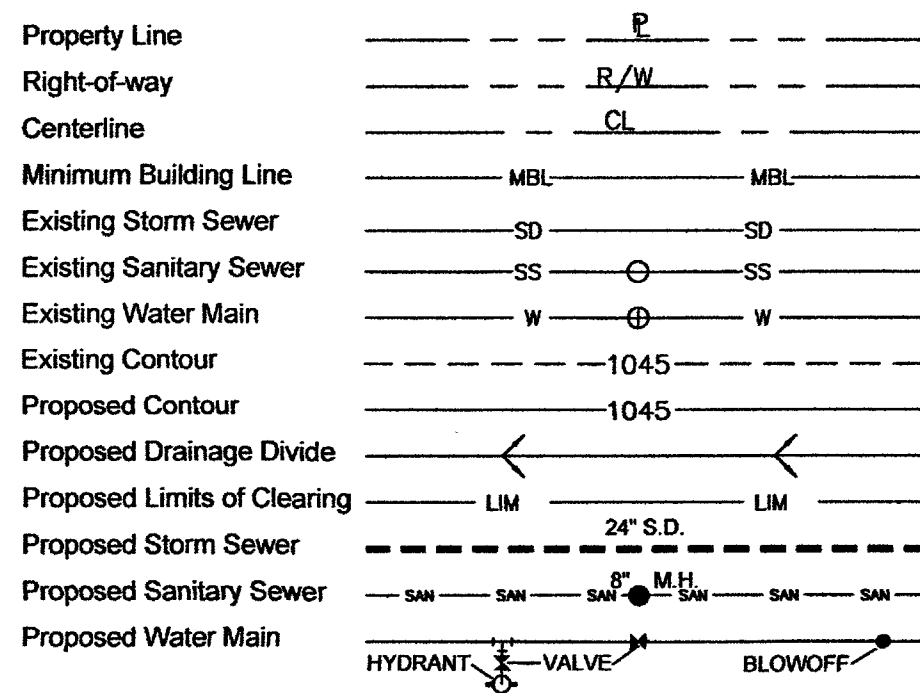

SEWER NOTES

All sanitary sewer facilities shall be installed according to the Western Virginia Regional Design and Construction Standards (Latest Edition).

A minimum cover of three (3) feet is required over proposed lines.

Contractor shall be responsible for locating and uncovering all manholes after paving. Manhole tops shall be adjusted to grade if necessary.

All existing utilities may not be shown in their exact location. The contractor shall comply with (State Water Works Regulations, Section 12VAC5-590-1150, where lines cross.)

All trenches in existing or future rights-of-way shall be compacted according to Virginia Department of Transportation standards.

Lines shall be staked prior to construction.

New sewer service is planned.

PRIVATE UTILITIES

Underground utilities installed on private property or in private utility easements and building related storm drains shall be designed and installed per the current edition of the Virginia Uniform Statewide Building Code. Design and installation requirements issued by the Western Virginia Water Authority that meet or exceed the USBC requirements are acceptable for private utilities. All private utilities are to be permitted through and inspected by the Roanoke County Inspections Office. Vaults, valves and other devices installed by or under the control of the Western Virginia Water Authority may not be substituted for the code required devices.

- C01 COVER SHEET
- C02 EXISTING COND, DEMO, & INITIAL ESC PLAN
- C03 SITE LAYOUT, DIMENSIONAL, & UTILITY PLAN
- C04 STORM SEWER SYSTEM
- C05 WATER SYSTEM LAYOUT AND PROFILES
- C06 GRADING & ESC PLAN
- C07 ESC NARRATIVE
- C08 ESC DETAILS
- C09 STORM PROFILES
- C10 STORM DETAILS
- C11 SANITARY SEWER DETAILS & PROFILES
- C12 WATER SYSTEM DETAILS
- C13 SITE DETAILS
- C14 WALL DESIGN DETAILS
- C15 LANDSCAPING PLAN
- C16 VDOT SIGHT DISTANCE PROFILES
- C17 TRANSPORTATION MANAGEMENT PLAN

Sheet Index

SURVEY INFORMATION

Horizontal and vertical control surveys were performed in year: 2016
By: PARKER DESIGN GROUP

All vertical elevations must be referenced to the National Geodetic Vertical Datum of 1929 or 1983.
All horizontal elevations must be referenced to the North American Datum of 1927 or 1983.

Source of topographic mapping is dated June 29, 2016.

Boundary was performed by: PARKER DESIGN GROUP

Benchmark information: ELEVATIONS FROM GPS ESTABLISHED (NAVD'88, NAD'83)
BENCHMARK = top of nail 1040.16 - see plan for location
BENCHMARK = top of nail 1039.37 - see plan for location

The professional seal and signature certifies the boundary survey and topographic mapping to be accurate and correct.

QUANTITY & COST ESTIMATE

ITEM	QUANTITY	UNIT	UNIT PRICE	COST	BONDABLE
CLEARING AND GRUBBING	14	AC	\$2500	\$3500	\$3500
EXCAVATION	15000	C.Y.	\$3.50	\$52500	\$52500
EMBANKMENT		C.Y.			
CURB INLET DI-3C	3	EA	\$2200	\$6600	\$6600
CURB INLET DI-		EA			
MANHOLE MH-2	1	EA	\$1500	\$1500	\$1500
MANHOLE MH-		EA			
15-IN. CONCRETE PIPE, CLASS III		LF			
15-IN. CONCRETE PIPE, CLASS IV	140	LF	\$24	\$3360	\$3360
-IN. C.M. CULVERT		LF			
-IN. C.M. CULVERT		LF			
BOX CULVERT		LS			
PAVED SWALE		LF			
RIPRAP - CLASS 1A	15	TON	\$20	\$300	\$300
PERMANENT GRASS SWALE		LF			
15-IN. CONCRETE ENDWALL EW-6PC	2	EA	\$1000	\$2000	\$2000
15-IN. END SECTION ES-1		EA			
CURB & GUTTER CG-2 W/ GRAVEL BASE	500	LF	\$22	\$11000	\$11000
CURB & GUTTER CG-6 W/ GRAVEL BASE	240	LF	\$30	\$7200	\$7200
VALLEY GUTTER		EA			
GRAVEL SHOULDER		SY			
HEAVY DUTY PAVEMENT (1.5" SM, 3" BM, 8" GRAVEL BASE)	1200	SY	\$35	\$42000	\$42000
REGULAR PAVEMENT (2" SM, 8" GRAVEL BASE)	550	SY	\$26	\$14300	\$14300
-IN. BIT. CONC. TYPE S-		SY			
-IN. BASE MATERIAL		C.Y.			
-IN. SUBBASE MATERIAL		C.Y.			
TRAFFIC BARRICADE		EA			
12" WATER LINE	660	LF	\$28	\$18480	\$18480
6" WATER LINE		LF			
FIRE HYDRANT ASSEMBLIES	1	EA	\$2500	\$2500	\$2500
BLOW OFFS W/ VAULT, FRAME & COVER	1	EA	\$1500	\$1500	\$1500
-IN. GATE VALVES, W/ VAULT, FRAME & COVER	2	EA	\$750	\$1500	\$1500
-IN. GATE VALVES, W/ VAULT, FRAME & COVER		EA			
6" SANITARY SEWER	152	LF	\$20	\$3040	\$3040
8" SANITARY SEWER	116	LF	\$28	\$3248	\$3248
STANDARD MANHOLE W/FRAME & COVER		EA			
SAMPLING MANHOLE/PORT		EA			
LANDSCAPING (22 TREES & 192 SHRUBS)	1	LS	\$15000	\$15000	\$15000
AMENITIES (INCLUDING BUT NOT LIMITED TO TRAILS, ETC...)		LS			
PERMANENT STORMWATER BASIN	1	LS	\$25000	\$25000	\$25000
AS-BUILT PLANS (STORM SEWER SYSTEMS)	1	LS	\$1500	\$1500	\$1500
AS-BUILT PLANS (STORMWATER MANAGEMENT)	1	LS	\$1500	\$1500	\$1500
SUBTOTAL				\$217528	\$217528
10% CONTINGENCY				\$21753	\$21753
ESTIMATED TOTAL				\$239,281	\$239,281
BY SEALING THE PLANS, THE DESIGN PROFESSIONAL HEREBY CERTIFIES THAT THE FOREGOING ESTIMATE REFLECTS THE CURRENT IMPROVEMENT COSTS OF THIS PROJECT.					

parker DESIGN GROUP

2122 Carolina Ave, SW
Roanoke, Virginia 24014
Phone: 540-387-1153
Fax: 540-389-5767
www.parkerdg.com

These documents are the property of Parker Design Group (PDG) and may not be reproduced or used without the express permission of PDG. Any reuse of these documents without authorization of PDG will be at the sole risk of the individual or entity utilizing said documents.

Commercial Retail Store
Prepared for The Broadway Group
Tax #: 027.18-06-02.00 thru 027.18-06-05.00
Hollins Magisterial District
Roanoke County, Virginia

REVISIONS:

Addressed County Comments	2-8-2017
Addressed Comments	2-8-2017
Field Revision #1	4-14-2017
Field Revision #3	4-19-2017
Field Revision #4	10-31-2017
Field Revision #5	11-06-2017

DESIGNED BY: SLR/SRB

DRAWN BY: SRB

CHECKED BY: SLR

SCALE: AS SHOWN

DATE: 30 September 2016


SHEET TITLE:

COVER SHEET

C01
01 OF 17
PROJECT NUMBER:
16-0087-03

DEVELOPER/PLANNING	APPROVED
FOR CONSTRUCTION	
BY ROANOKE COUNTY	
Department	
Preparation Review	10/12/18
Engineering	12/4/2018
Water & Sewer	5/4/2018
Planning & Zoning	12-1-18

APPROVED

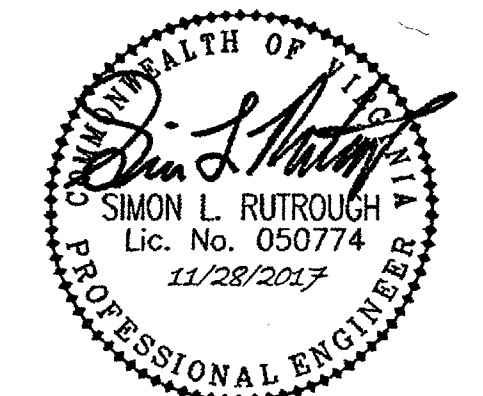

COMMERCIAL
RETAIL STORE
ROANOKE COUNTY
(Dollar General)

SHEET
01
OF
17

AS BUILT 3-28-18 Jeff Carter