
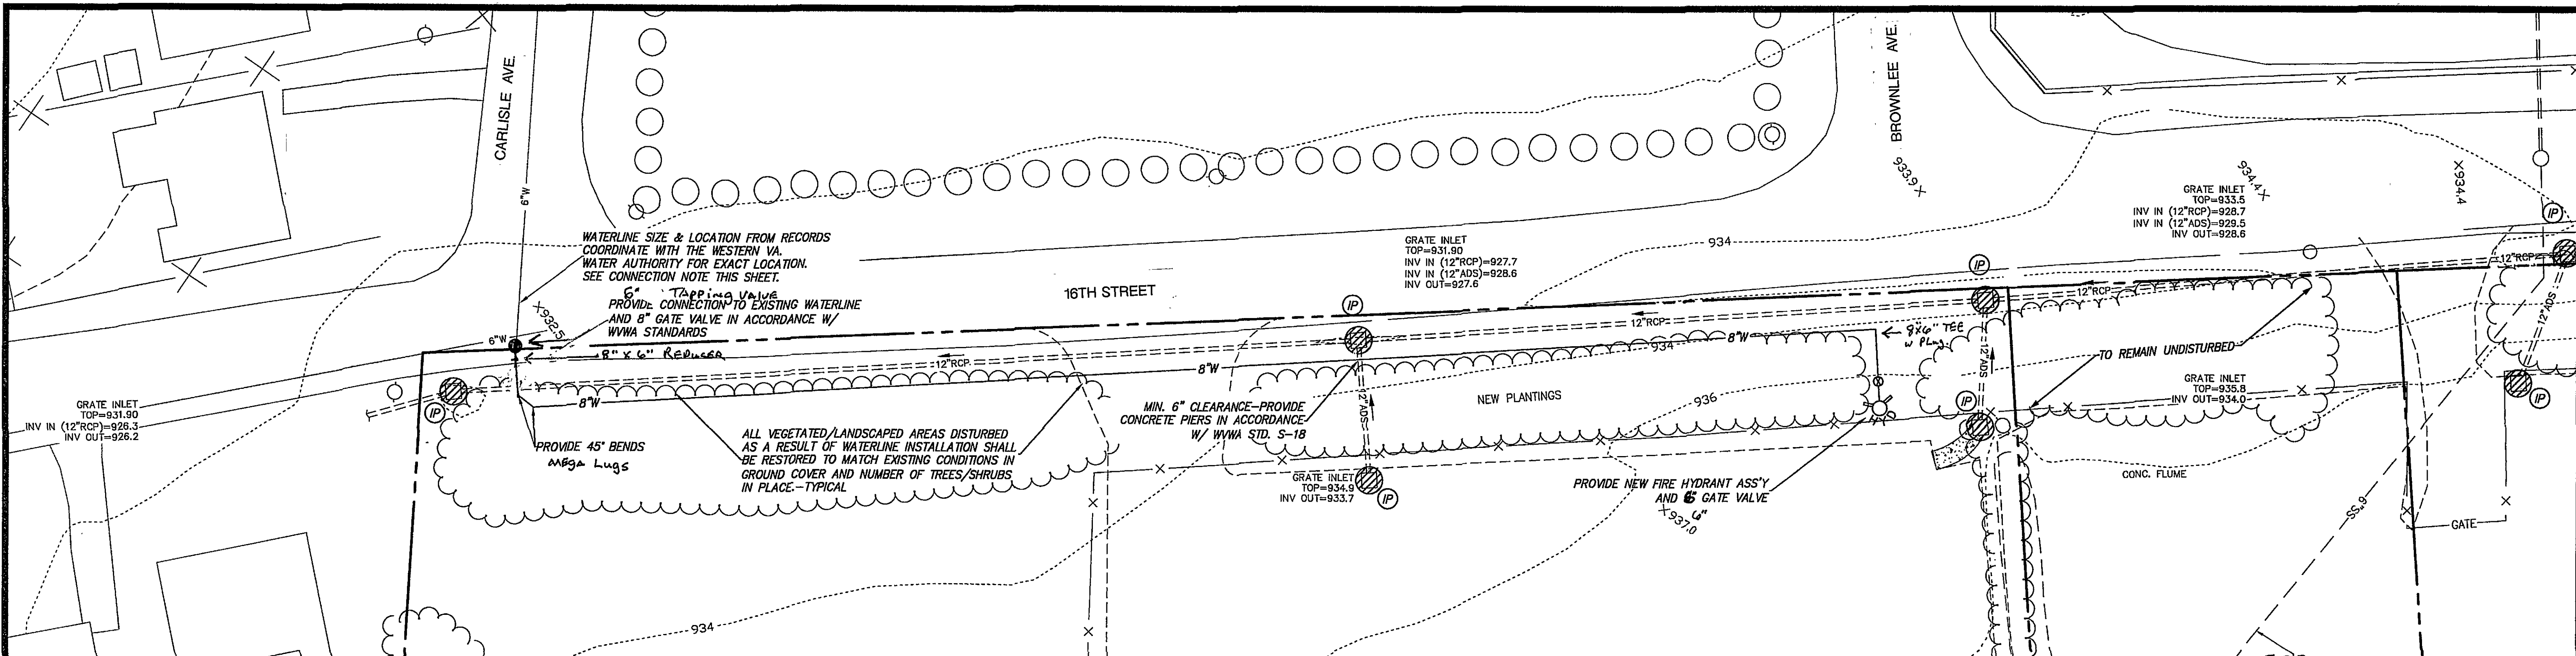


WATERLINE CONNECTION NOTE:
 THE CONTRACTOR SHALL PROVIDE CONNECTION TO THE EXISTING WATERLINE IN ACCORDANCE WITH WESTERN VA. WATER AUTHORITY STANDARDS. THE METHOD OF CONNECTION SHALL BE DICTATED BY FIELD CONDITIONS. THE CONTRACTOR SHALL PROVIDE TO THE WVA THE METHOD OF CONNECTION TO BE USED AND COORDINATE ALL ACTIVITIES RELATED TO WATERLINE CONSTRUCTION WITH THE WVA.

as Built
Caldwell
 6-17-09

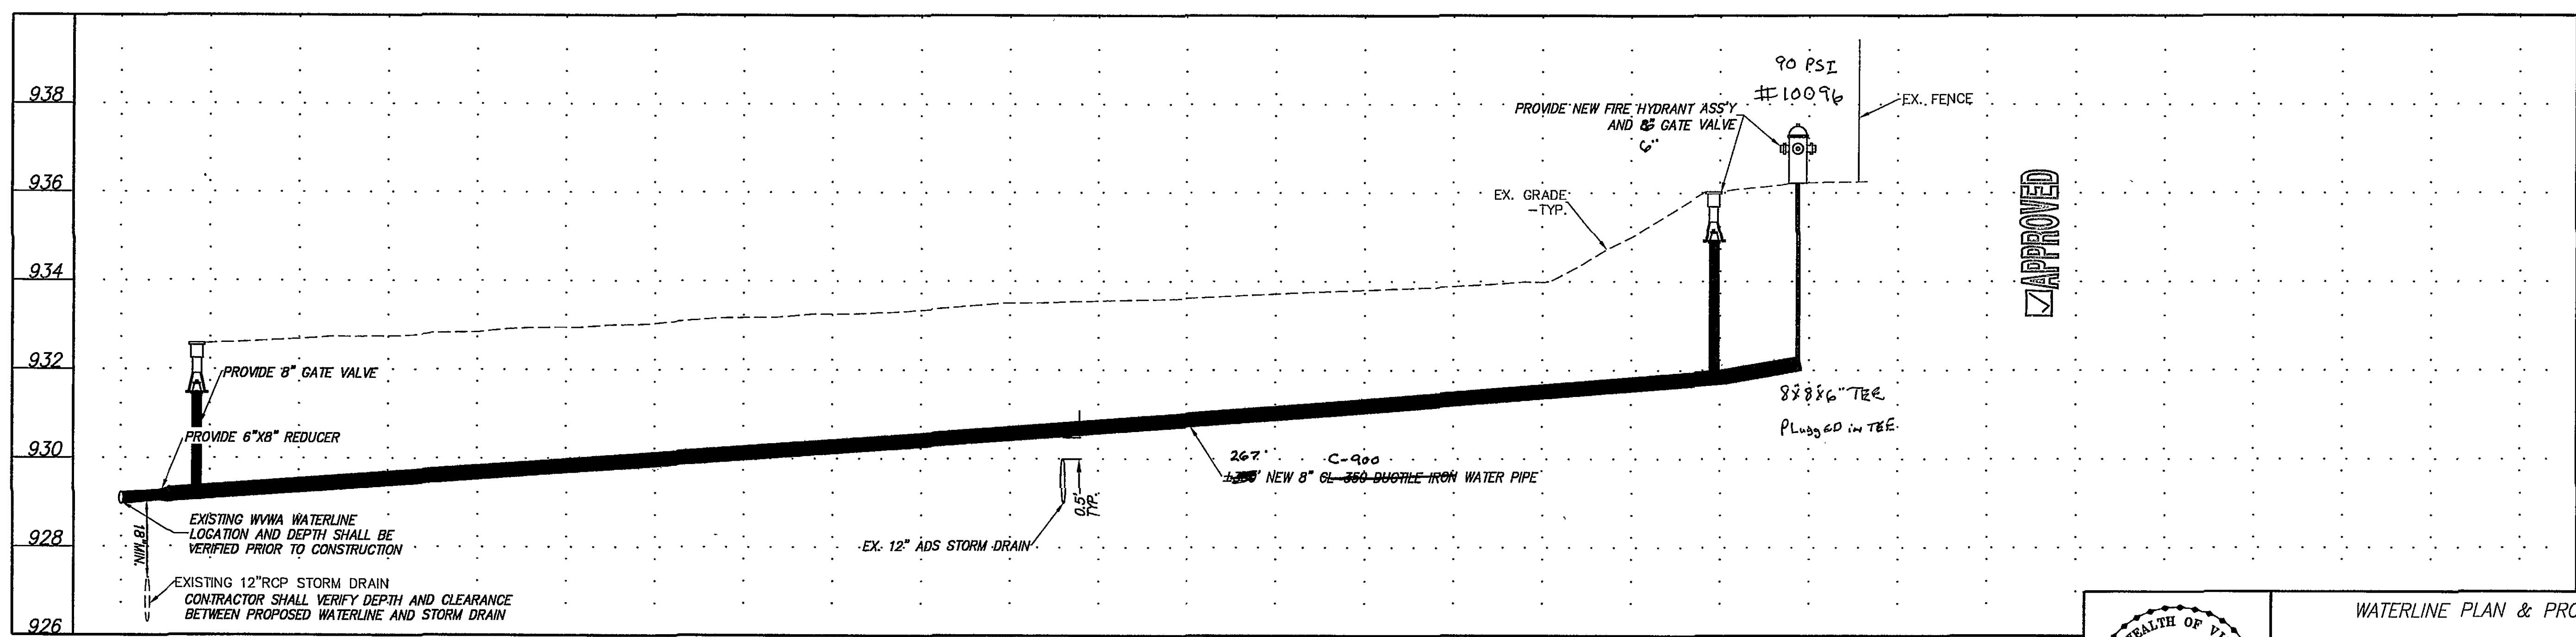

WATERLINE PROFILE
 SCALE: HORIZONTAL 1"=20'
 VERTICAL 1"=2'

APPROVED

	WATERLINE PLAN & PROFILE FOR CONCRETE SPECIALTIES, INC. SITUATE 16TH STREET AND UNDERHILL AVENUE VINTON MAGISTERIAL DISTRICT ROANOKE COUNTY, VIRGINIA
	CALDWELL WHITE ASSOCIATES ENGINEERS / SURVEYORS / PLANNERS 4203 MELROSE AVENUE, N.W. P.O. BOX 6280 ROANOKE, VIRGINIA 24017 (540) 366-3400 FAX: (540) 366-8702
Designed: JWK Drawn: JWK Checked: FBC Date: NOV. 4, 2008 Rev: JAN. 27, 2009 Scale: 1" = 20' Tax Parcel: 20.11-1-20.21.1.22 W.O. No.: 08-0074	