


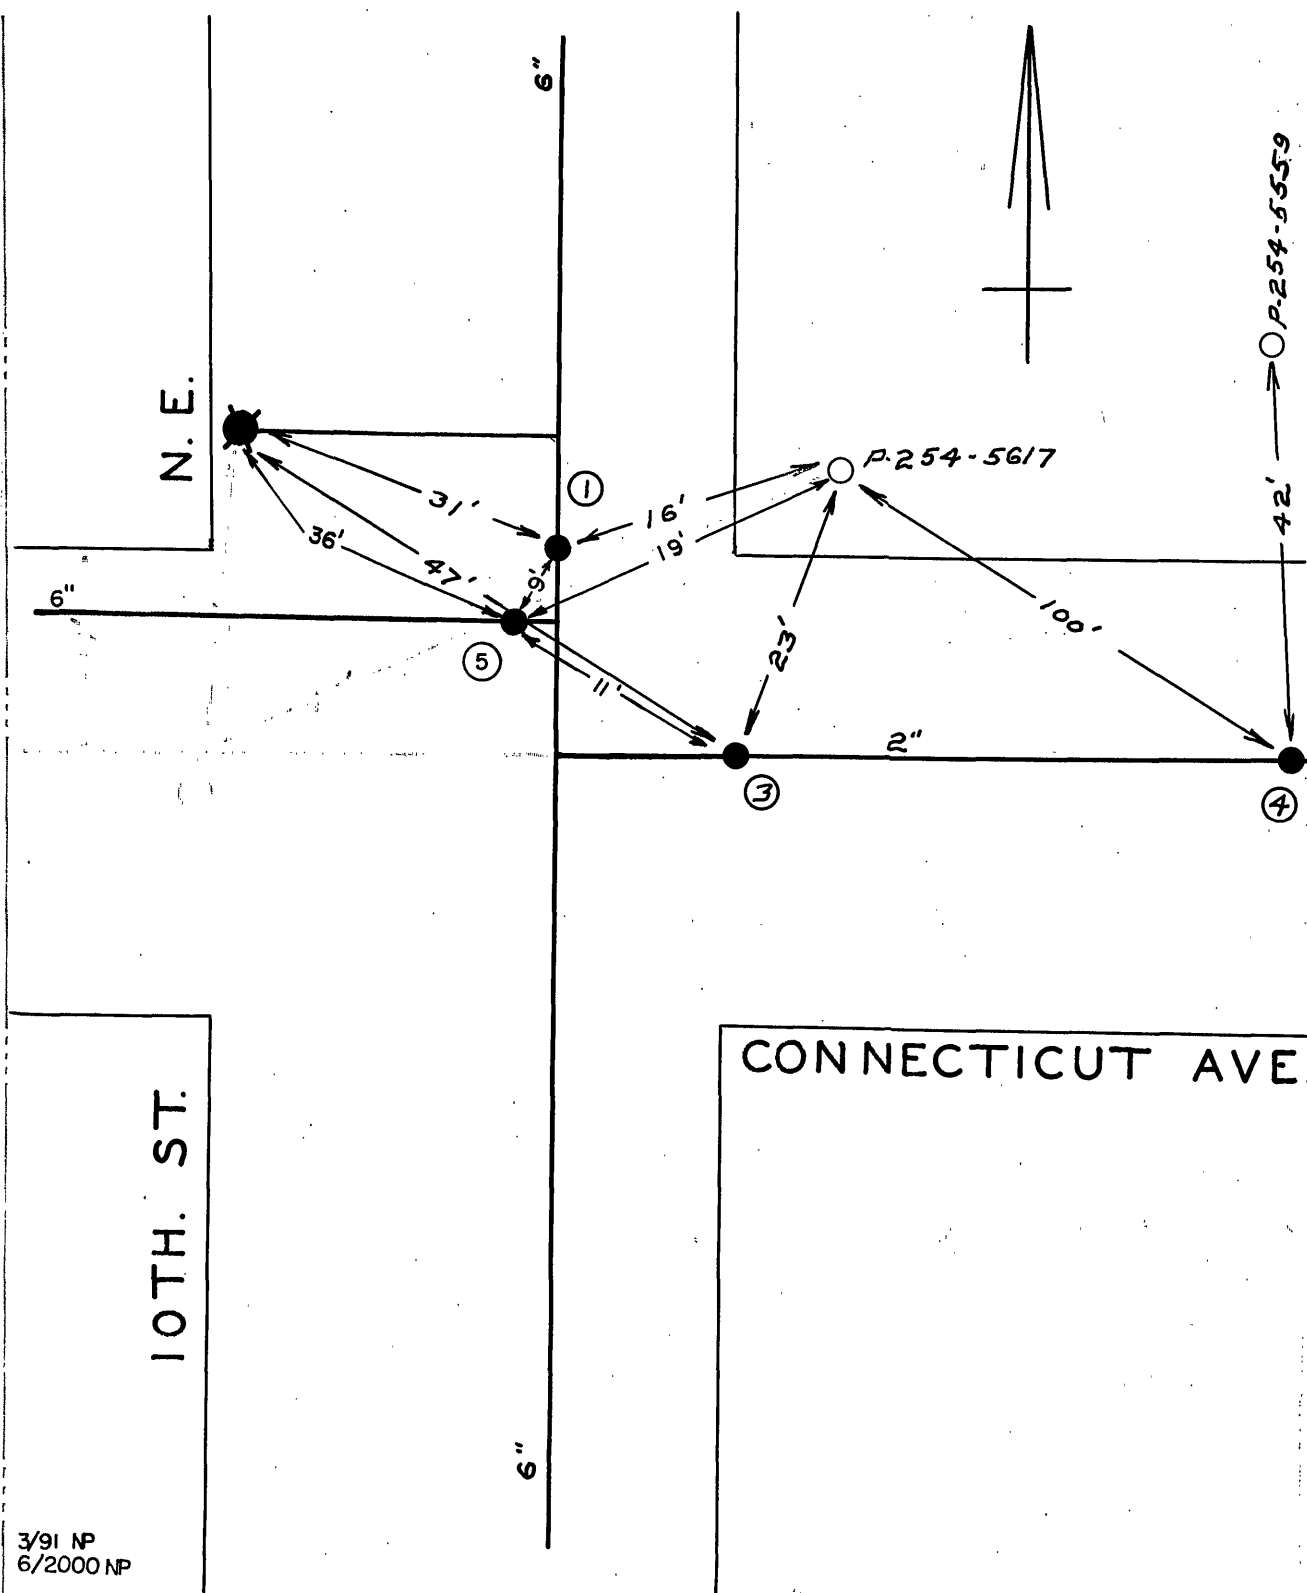

DATE	NO.	SIZE	MAKE	OPEN	TURNS
1953	1	6"			
1953	2				
1925	3	2"	DARLING	R	7 V2
6-56	4	2"			
4-2000	5	6"	MUELLER	R	21
	1	0	NPL		
	2	0	WPL		
	3	0	EPL		
	4	105'-E	EPL		

CITY OF ROANDOME - WATER DEPT.
VALVE DIAGRAM

CONNECTICUT AVE. &
10TH. ST.

SEC. MAP 306 NE.

DATE PAGE NO.