GENERAL NOTES


- ALL PLANTS SHALL CONFORM TO CURRENT AAN STANDARDS AND SHALL BE GUARANTEED FOR A PERIOD OF ONE YEAR FROM FINAL ACCEPTANCE.
- 2 OWNERS' REPRESENTATIVE RESERVES THE RIGHT 10 INSPECT ALL MATERIALS AT SOURCE.
- 3 PLANTING MIX SHALL CONSIST OF A UNIFORM MIXTURE OF 75% TOPSOIL, 20% CLEAN SAND AND 5% COMPOSTED COW MANURE.
- 4 F TILIZE ALL PLANTS PRIOR TO COMPLETION WITH QSMOCOTE 14-14-14 PER MANUFACTURER'S LABEL.
- 5 CONTRACTOR SHALL BE RESPONSIBLE FOR THE PROTECTION OF ALL UTILITIES AND SHALL MAINTAIN A CURRENT MISS UTILITY NUMBER THROÚGHOUT WORK PERIOD
- 6. CONTRACTOR SHALL BE RESPONSIBLE FOR MAINTLNANCE AND WATERING OF ALL PLANT MATERIAL UNTIL FINAL ACCEPTANCE.
- 7 CONTRACTOR SHALL PROVIDE OWNERS REPRESENTATIVE WITH DETAILED WRITTEN LANDSCAPE MAINTENANCE INSTRUCTIONS PRIOR TO FINAL ACCEPTANCE.
- 8 REMOVE ALL HOSE, WIRE AND STAKES AT END OF GUARANTEE
- 9 ALL SELECTIVE THINNING AND CLEAR VIEWING SHALL BE DONE AT THE DIRECTION OF OWNER'S REPRESENTATIVE,
- 10. LANDSCAPE CONTRACTOR SHALL PROTECT EXISTING TREES FROM ANY DAMAGE DUE TO LANDSCAPE WORK


11. IN AREAS WHERE PLANTING OCCURS IN WET SOILS, RAISE PLANT 4" ABOVE NORMAL PLANTING DEPTH AND PROVIDE 4" #68 STONE AT BOTTOM OF PLANTING PIT SHAPE SURROUNDING GRADE TO MATCH.

REQUIRED GANOPY CALCS


- 12 ALL PLANT BEDS SHALL BE MULCHED (MIN. 3") AND EDGED CLEANLY WHERE ADJACENT TO ANY EXISTING LAWN, SODDED, OR SEEDED AREA.
- 13 FIELD ADJUSTMENTS MAY BE NECESSARY BECAUSE OF SITE CONDITIONS (EX. ROOT BALL AND UTILITY CONFLICT) MAJOR ADJUSTMENTS MUST BE APPROVED BY LANDSCAPE ARCHITECT
- 14. ROUGH GRADING SHALL BE DONE BY GENERAL SITE CONTRACTOR ANY FINE GRADING SHALL BE DONE BY THE LANDSCAPE CONTRACTOR
- 15 IF SOMEONE OTHER THAN THE LANDSCAPE ARCHITECT (OWNER, BUILDER, ETC) ADVERTISES, SOLICITS AND/OR RECEIVES BIDS FOR WORK, THE LANDSCAPE CONTRACTOR SHALL STILL PROVIDE UNIT COPIES OF UNIT PRICE BID TO THE LANDSCAPE ARCHITECT
- 16 PLANT SIZES ARE SPECIFIED IN PLANT MATERIAL LIST ARE MINIMUM SIZES

| 1250 35,000 1250 18,730 1250 17,500 250 2,000 250 2,000 10 370 10 390 10 440 Total 76,450 | 28 15 14 8 A 8 37 39 44 | `Acer rubrum 'Oatober Glory' Acer platanoides 'Royal Red' Quercus rubra Amelanchier x grandiflora 'Autumn Brilliance' x Gupressocyparis leylandif Myrica pensylvanica Juniperus chinensis 'Sea Green' Itea virginica 'Henry's Garnet' | Öctober Glory Red Maple Rayal Red Maple Red Oak Autumn Brilliance Serviceberry Leyland Cypress Northern Bayberry Sea Green Juniper Henrey's Garnet Swaetspire | 1 ½ " 1 ½ " 1 ½ " 1 ½ " | 5' 18" 18" | | 8&8 8&8 8&8 8&8 8&8 | |
|--|--|--|--|---------------------------------------|--|--|---------------------------------------|---|
| 1250 17,500 250 2,000 250 2,000 10 370 10 390 10 440 | 14 8 A 8 8 37 39 | Quercus rubra Amelanchier x grandıflora 'Autumn Brilliance' x Gupressocyparıs leylandıf Myrica pensylvanica Juniperus chinensis 'Şea Green' | Red Oak Autumn Brilliance Serviceberry Leyland Cypress Northern Bayberry Sea Green Juniper | 1 ½ " | 18" 18" | | 8&8 8&8 8&8 8&8 | |
| 250 2,000 250 2,000 10 370 10 390 10 440 | 8 A 8 37 39 | Amelanchier x grandıflora 'Autumn Brilliance' x Cupressocyparıs leylandıf Myrıca pensylvanıca Juniperus chinensis 'Şea Green' | Autumn Brilliance Serviceberry Løyland Cypress Northern Bayberry Soa Green Juniper | | 18" 18" | | 8&B 8&B #3 | |
| 250 2,000 10 370 10 390 10 440 | 8 37 39 | x Gupressocyparis leylandif Myrica pensylvanica Juniperus chinensis 'Sea Green' | Løyland Cypress Northern Bayberry Sea Green Juniper | 1 1/2 " | 18" 18" | | 8&B #3 | |
| 10 370 10 390 10 440 | 37 39 | Myrica pensylvanica Juniperus chinensis 'Sea Green' | Northern Bayberry Soa Green Juniper | | 18" 18" | | #3 | |
| 10 390 10 440 | 39 | Juniperus chinensis 'Sea Green' | Soa Green Juniper | | 18" | | | *************************************** |
| 10 390 10 440 | 39 | Juniperus chinensis 'Sea Green' | Soa Green Juniper | | 18" | | | |
| 10 440 | Harris and the state of the sta | | | | | | | |
| | A4 | itea virginica Henry's Garnet | Henrey's Garnet Sweetspire | 1 1 | | | #3 | |
| Total 76,450 | | | | · · · · · · · · · · · · · · · · · · · | 18" | | #3 | |
| Total 76,450 | | | | | | ··· | | |
| | 5 | | | | , | | | |
| | | | | | | | | |
| | | | | | | | | |
| | | | | | | | | |
| | | | | | | | | |
| | | | | | | | · · · · · · · · · · · · · · · · · · · | |
| | | | | | 4 ((| | | , |
| | | | | | ************************************** | | | |
| | | | | | | | | |
| | | | | | | | | |
| | | | | 77 | | | | |
| | | | | | | on the same of the same of | | |
| | | | | | | | | |
| | | , | | | (| | | |
| | | | | | | 70) T. | | |
| | | | | | | | أسيي والمساووا والماري | |

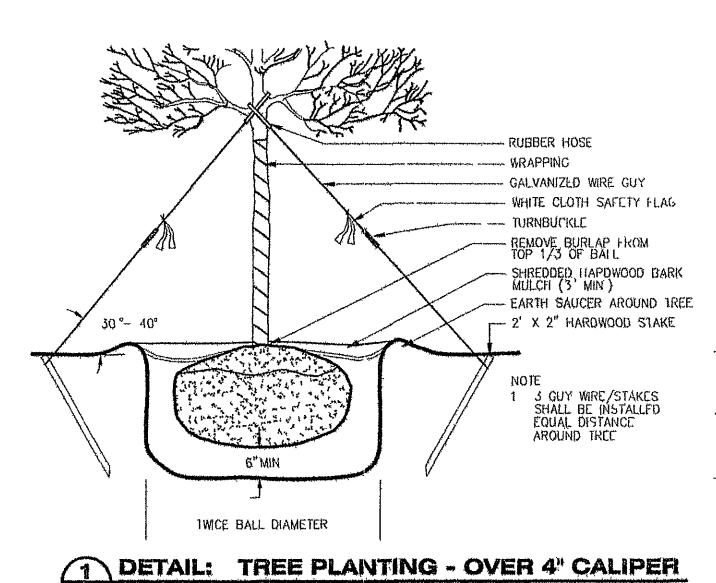


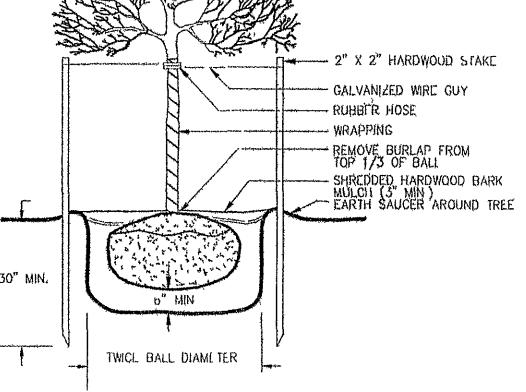

2 DETAIL: TREE PLANTING - UP TO 4" CALIPER N.T.S.

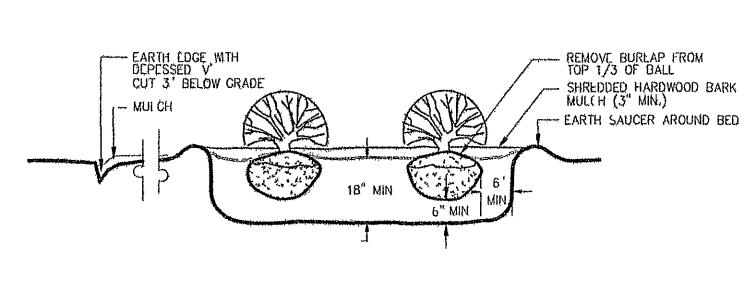


3 DETAIL: SHRUB PLANTING BED UN.T.S.

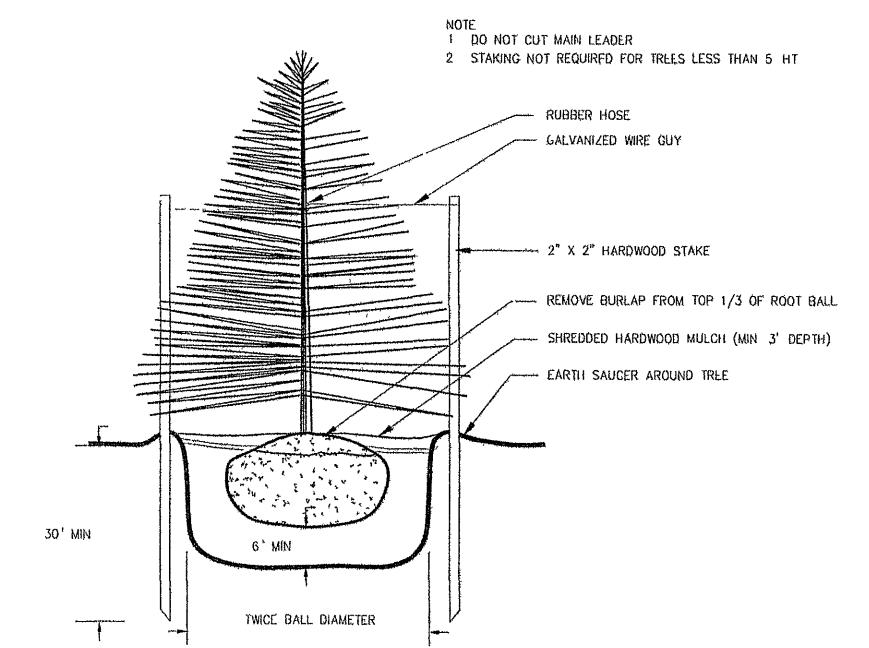

CONIFEROUS TREE PLANTING - OVER 5' HT. AS-BUILT

WVWA ID# 6HJPWY

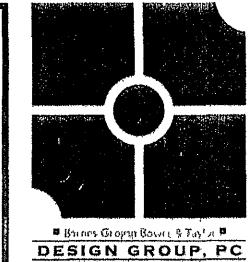

I AMPLY STORY SHE STORY HAND MATCHANA

These documents are the property of Barnes Grogan Bower & Taylor DESIGN GROWF(BGBT) and may not be reproduced or used without the express permission of BGBT. Any reuse of stess documents without authoritation of BGBT will be as the sole risk of the tridividual or entity utilizing said documents.

No 000855

201 E Main Street


Salem, Virginia 24153

Phone 540 387 9100

www bgbt-design com

Fax 540 387-9101

Suite 100

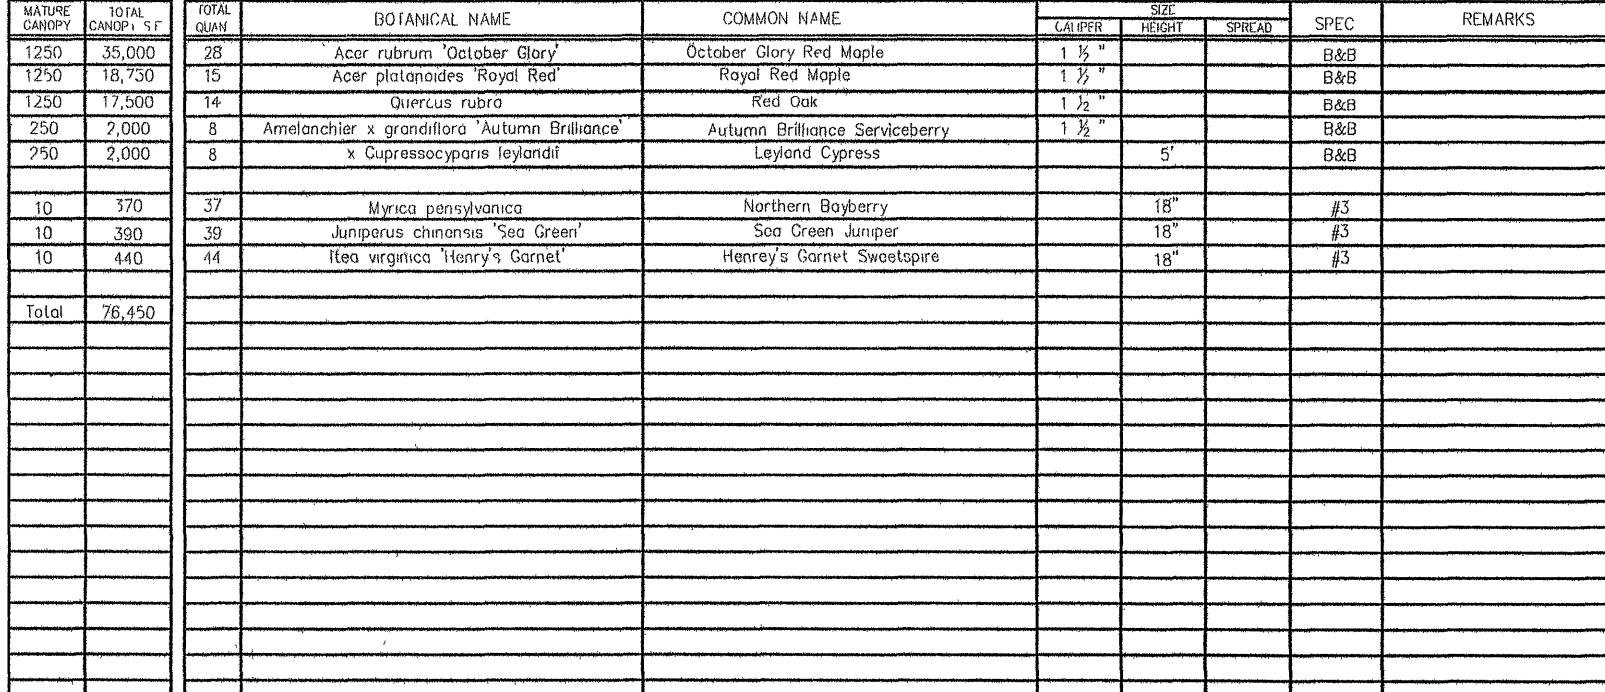

s at Stonelyn evelopement Stonelyn LLC ns Magisterial District ottages nome Dev 호 호 호 호 epared しら

DESIGNED BY: DRAWN BY

JCG CHECKED BY. N/A SCALE. MAY 28, 2004

SHEET TITLE

Landscape **Notes & Details**

