


PLAN	DATE	BY	DATE
SURVEYED		S.B.B.	
PLOTTED			
CHECKED			
DATE			
BY			
DATE			

PROFILE	DATE	BY	DATE
SURVEYED		S.B.B.	
PLOTTED			
CHECKED			
DATE			
BY			
DATE			

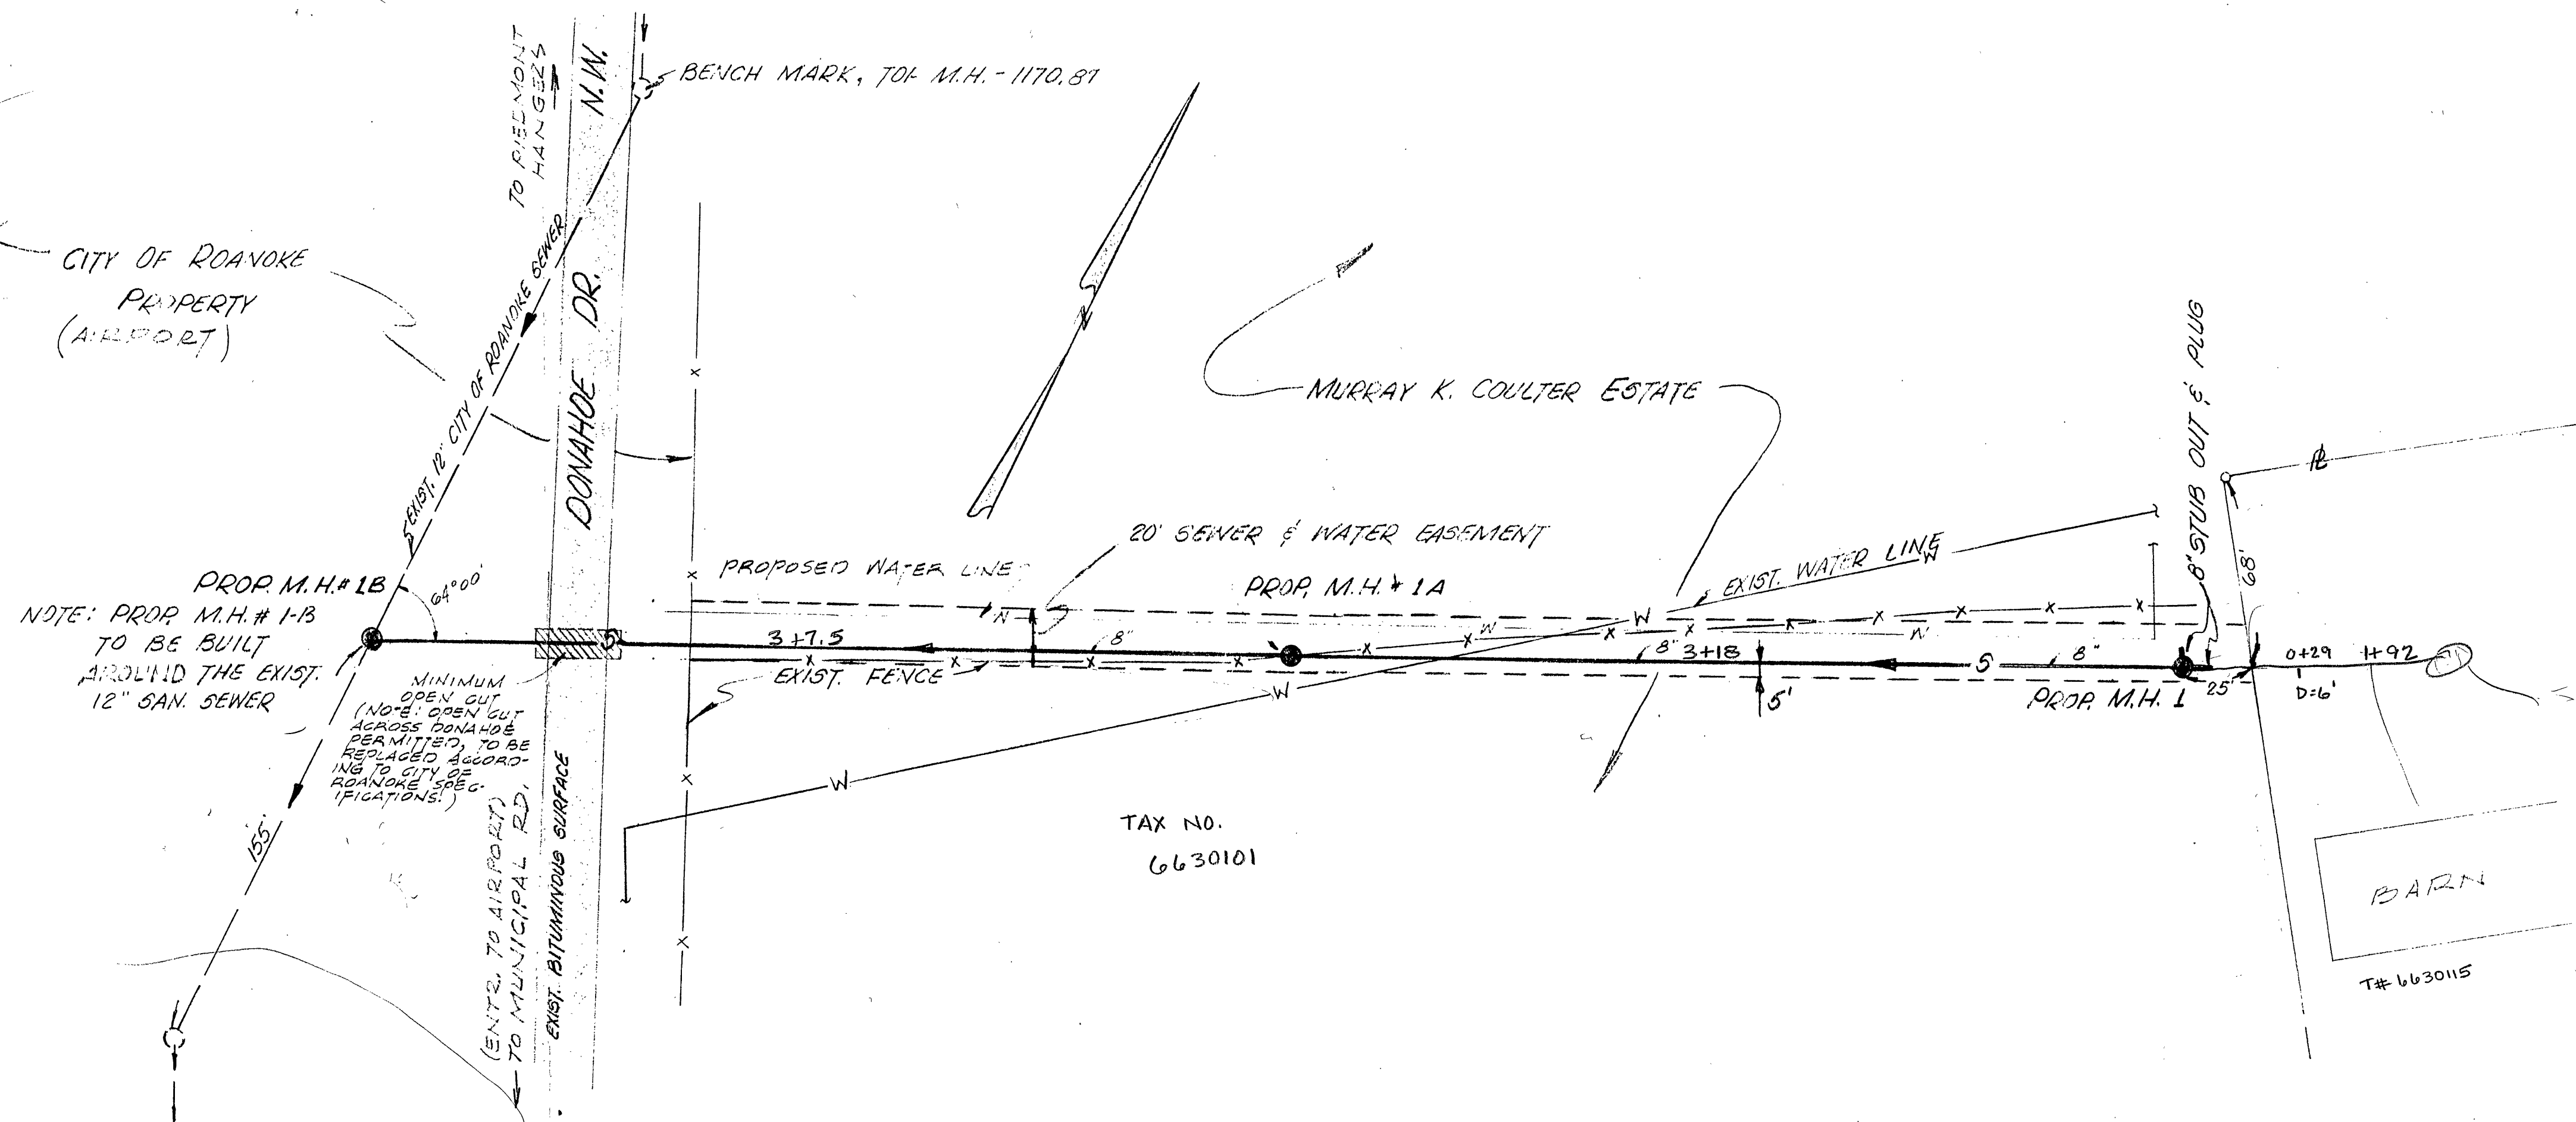

GENERAL NOTES

1. THIS PROJECT SHALL BE CONSTRUCTED IN ACCORDANCE WITH THE ROANOKE COUNTY PUBLIC SERVICE AUTHORITY'S SPECIFICATIONS, STANDARDS, AND CONSTRUCTION PRACTICES.
2. BASE BID SHALL BE BASED ON ASBESTOS CEMENT PIPE.
3. LOCATION OF EXISTING WATER AND SANITARY SEWER LINE SHALL BE FIELD VERIFIED PRIOR TO CONSTRUCTION.
4. ALL EASEMENTS SHALL BE DEEDED TO THE AUTHORITY ACCORDING TO ITS STANDARD POLICIES.

MAP #663
DONE BY N.H.

AS BUILT




APPROVED

CITY ENGINEER, ROANOKE, VIRGINIA

DATE

PLAN SCALE: 1" = 40'

SCALE: VERT. 1" = 10'
HORIZ. 1" = 40'

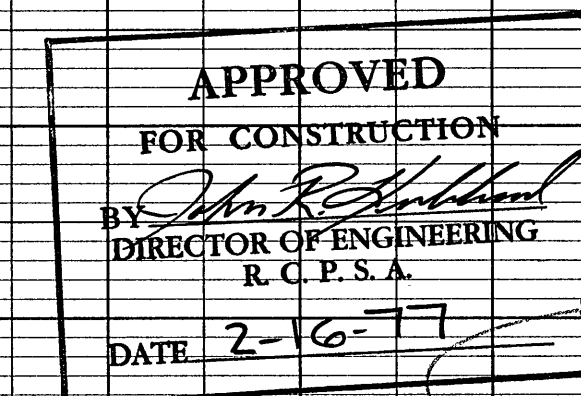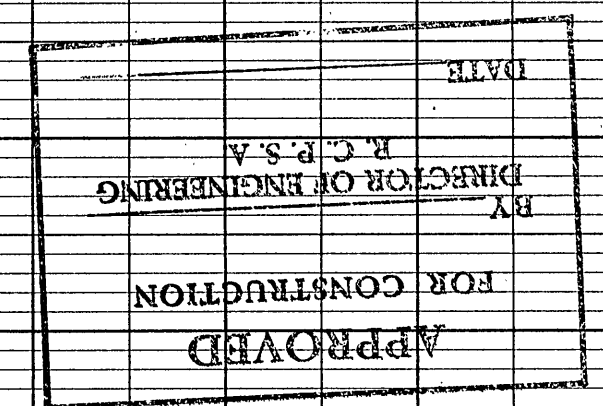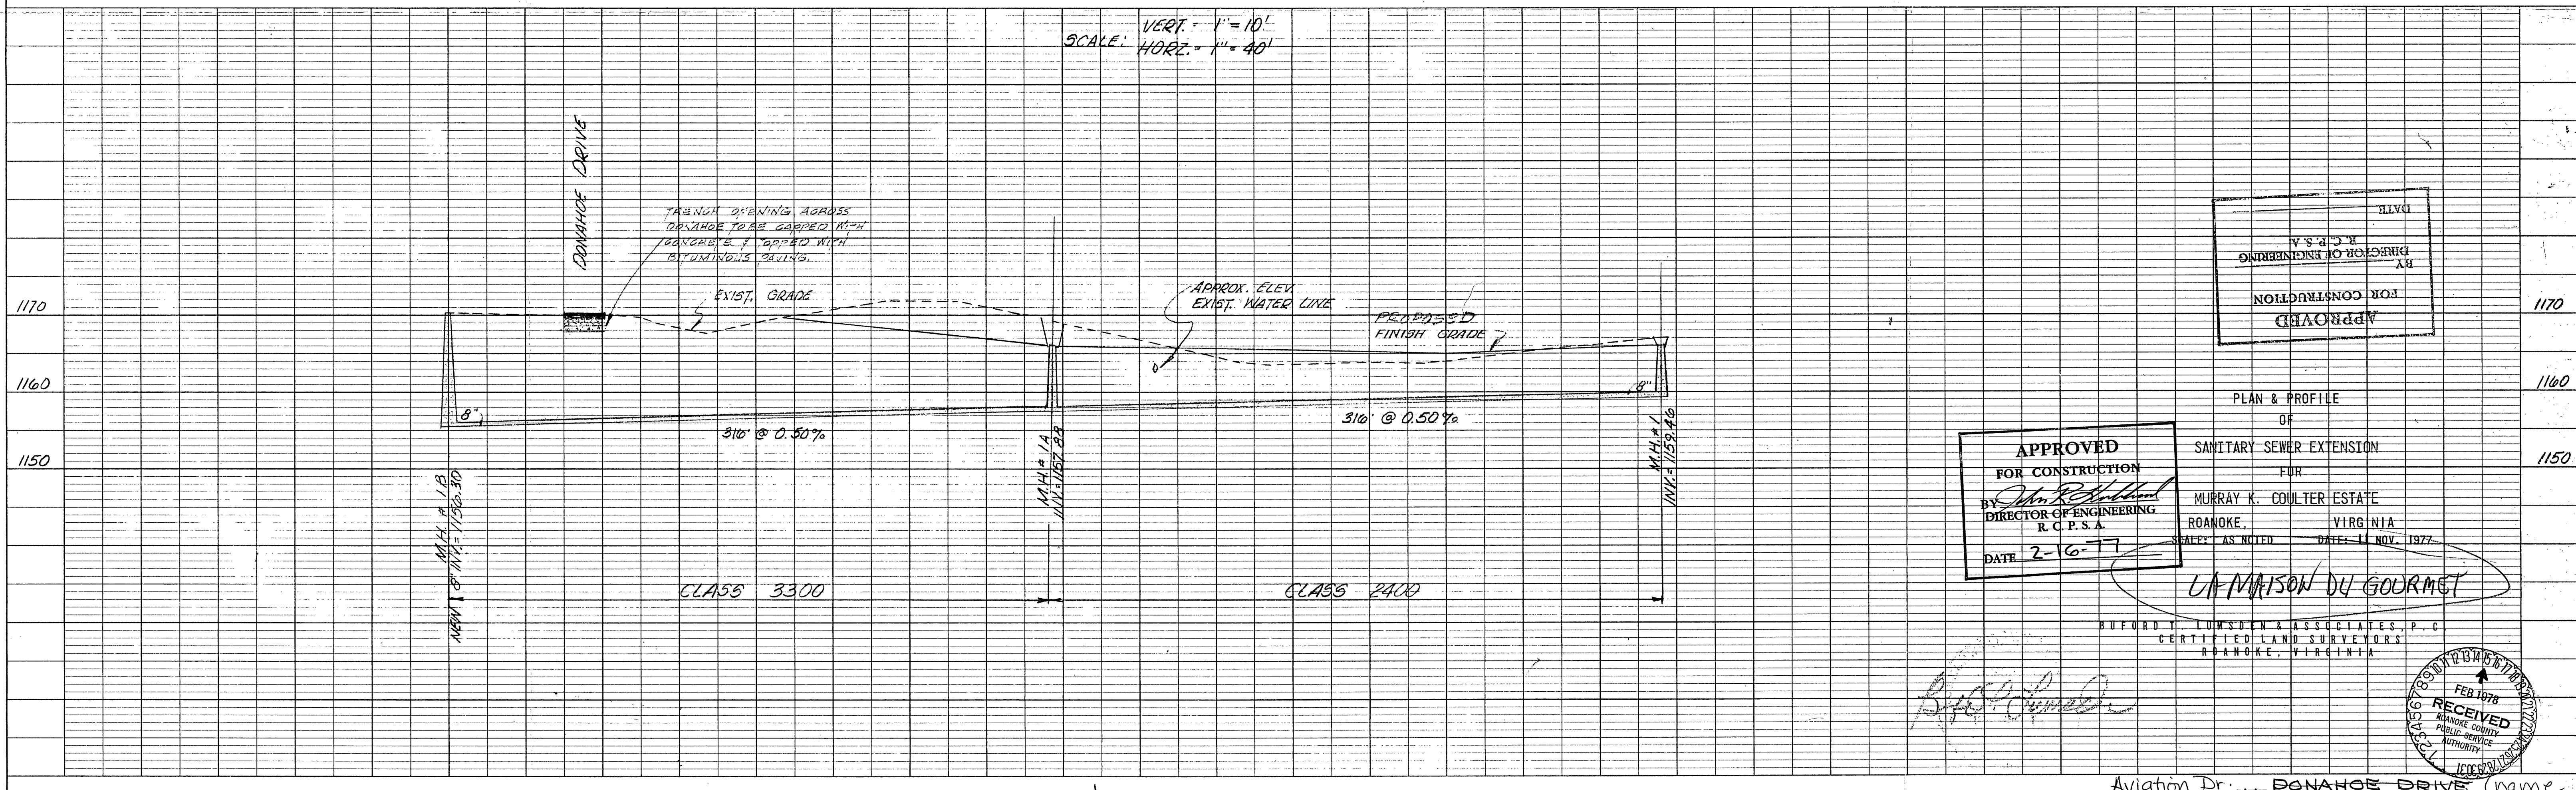

PLAN & PROFILE

SANITARY SEWER EXTENSION

FOR


MURRAY K. COULTER ESTATE

ROANOKE, VIRGINIA

SCALE: AS NOTED DATE: 11 NOV. 1977

LA MAISON DU GOURMET

MURPHY LUMSDEN & ASSOCIATES, P.C.
CERTIFIED LAND SURVEYORS
ROANOKE, VIRGINIA

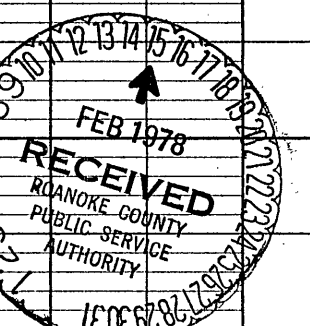

Aviation Dr. DONAHOE DRIVE (name changed)
DWG FILE 418 COMM 77/027 (REV. 75/156)