
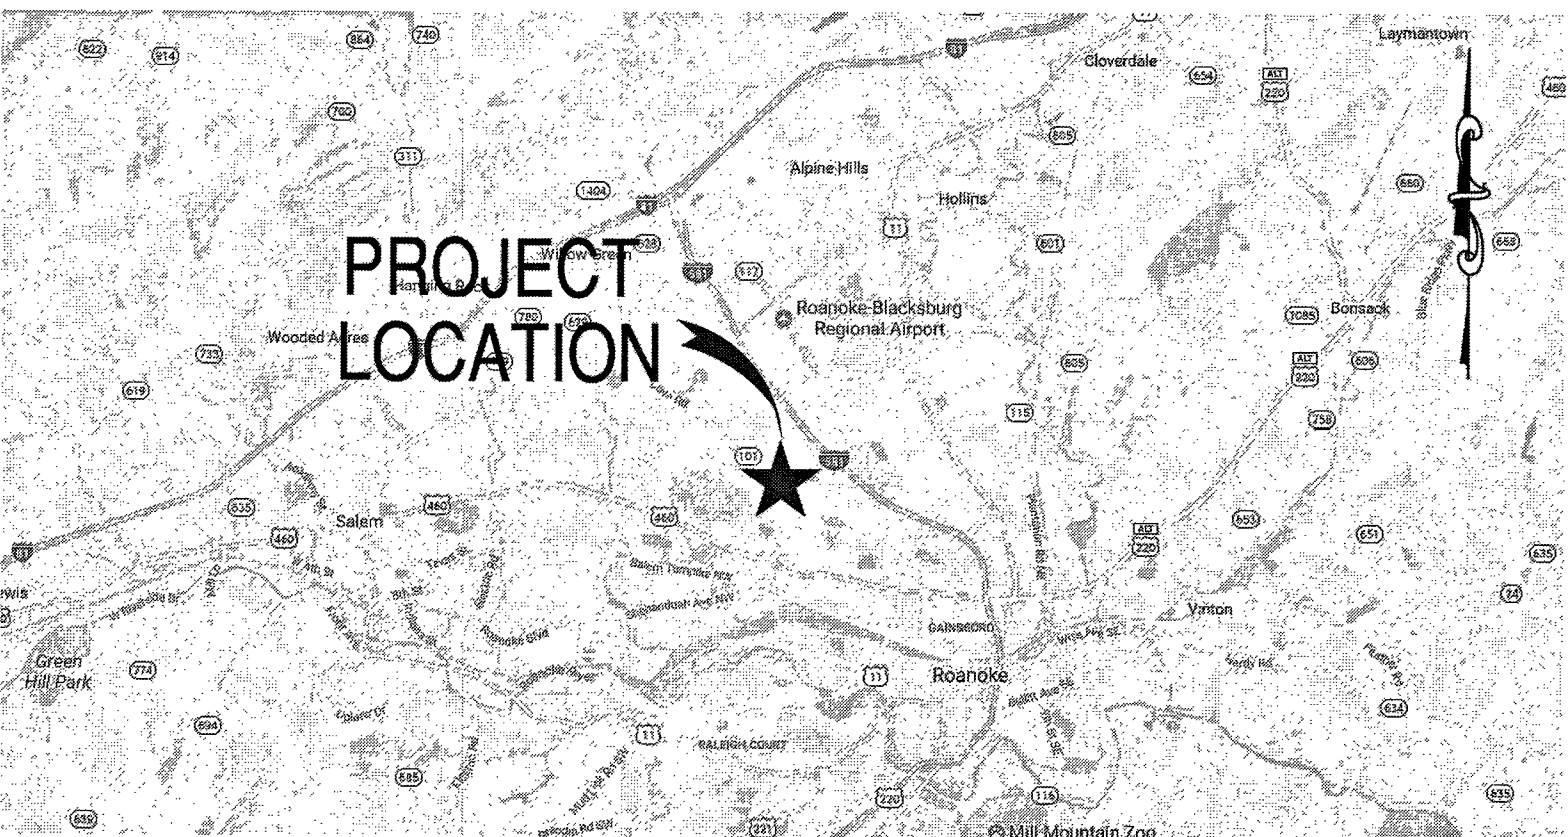


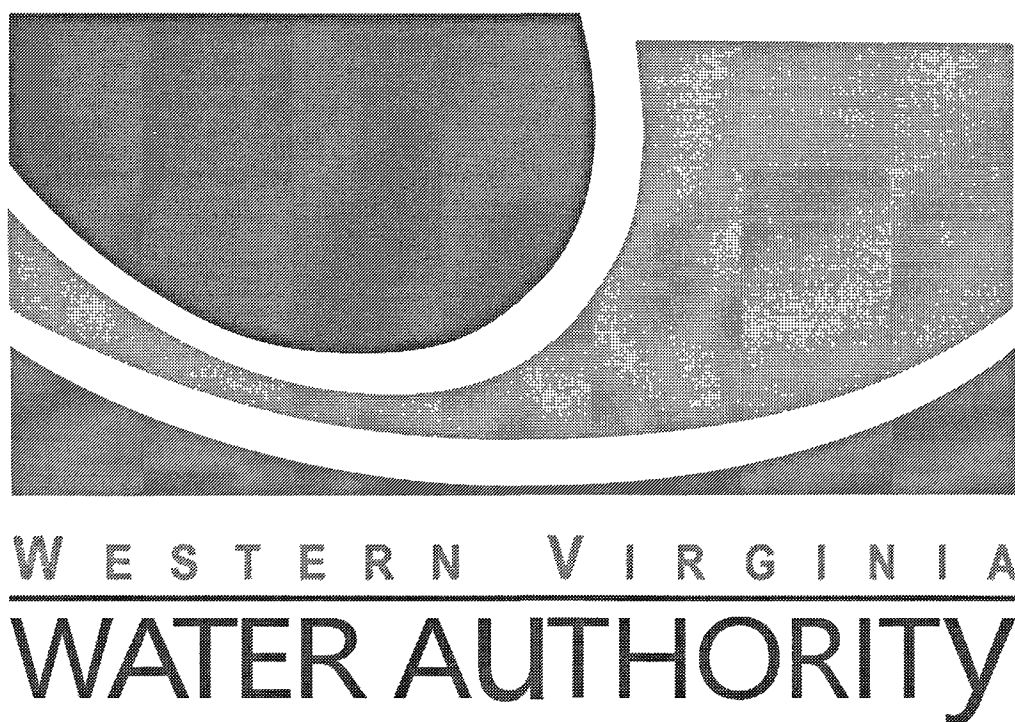


LOCATION MAP
NO SCALE

WESTERN VIRGINIA WATER AUTHORITY COVE ROAD WATER MAIN REPLACEMENT

Start Date - 7/23/18
E.C. PACE - David Harmon

SHEET	TITLE
1.	COVER
2.	GENERAL NOTES & PROPOSED LEGEND
3.	SURVEY SCHEDULES, NOTES, & EXISTING LEGEND
4.	SHEET LAYOUT & FIRE HYDRANT COVERAGE MAP
5.	PLAN - PROFILE, STA. 10+00 TO STA. 15+12
6.	PLAN - PROFILE, STA. 15+12 TO STA. 20+62
7.	PLAN - PROFILE, STA. 20+62 TO STA. 26+12
8.	PLAN - PROFILE, STA. 26+12 TO STA. 30+68 PLAN - PROFILE, STA. 50+00 TO STA. 50+84
9.	TEMPORARY TRAFFIC CONTROL PLAN NOTES
10.	TEMPORARY TRAFFIC CONTROL PLAN FIGURE 1
11.	TEMPORARY TRAFFIC CONTROL PLAN FIGURE 1
12.	TEMPORARY TRAFFIC CONTROL PLAN FIGURE 2

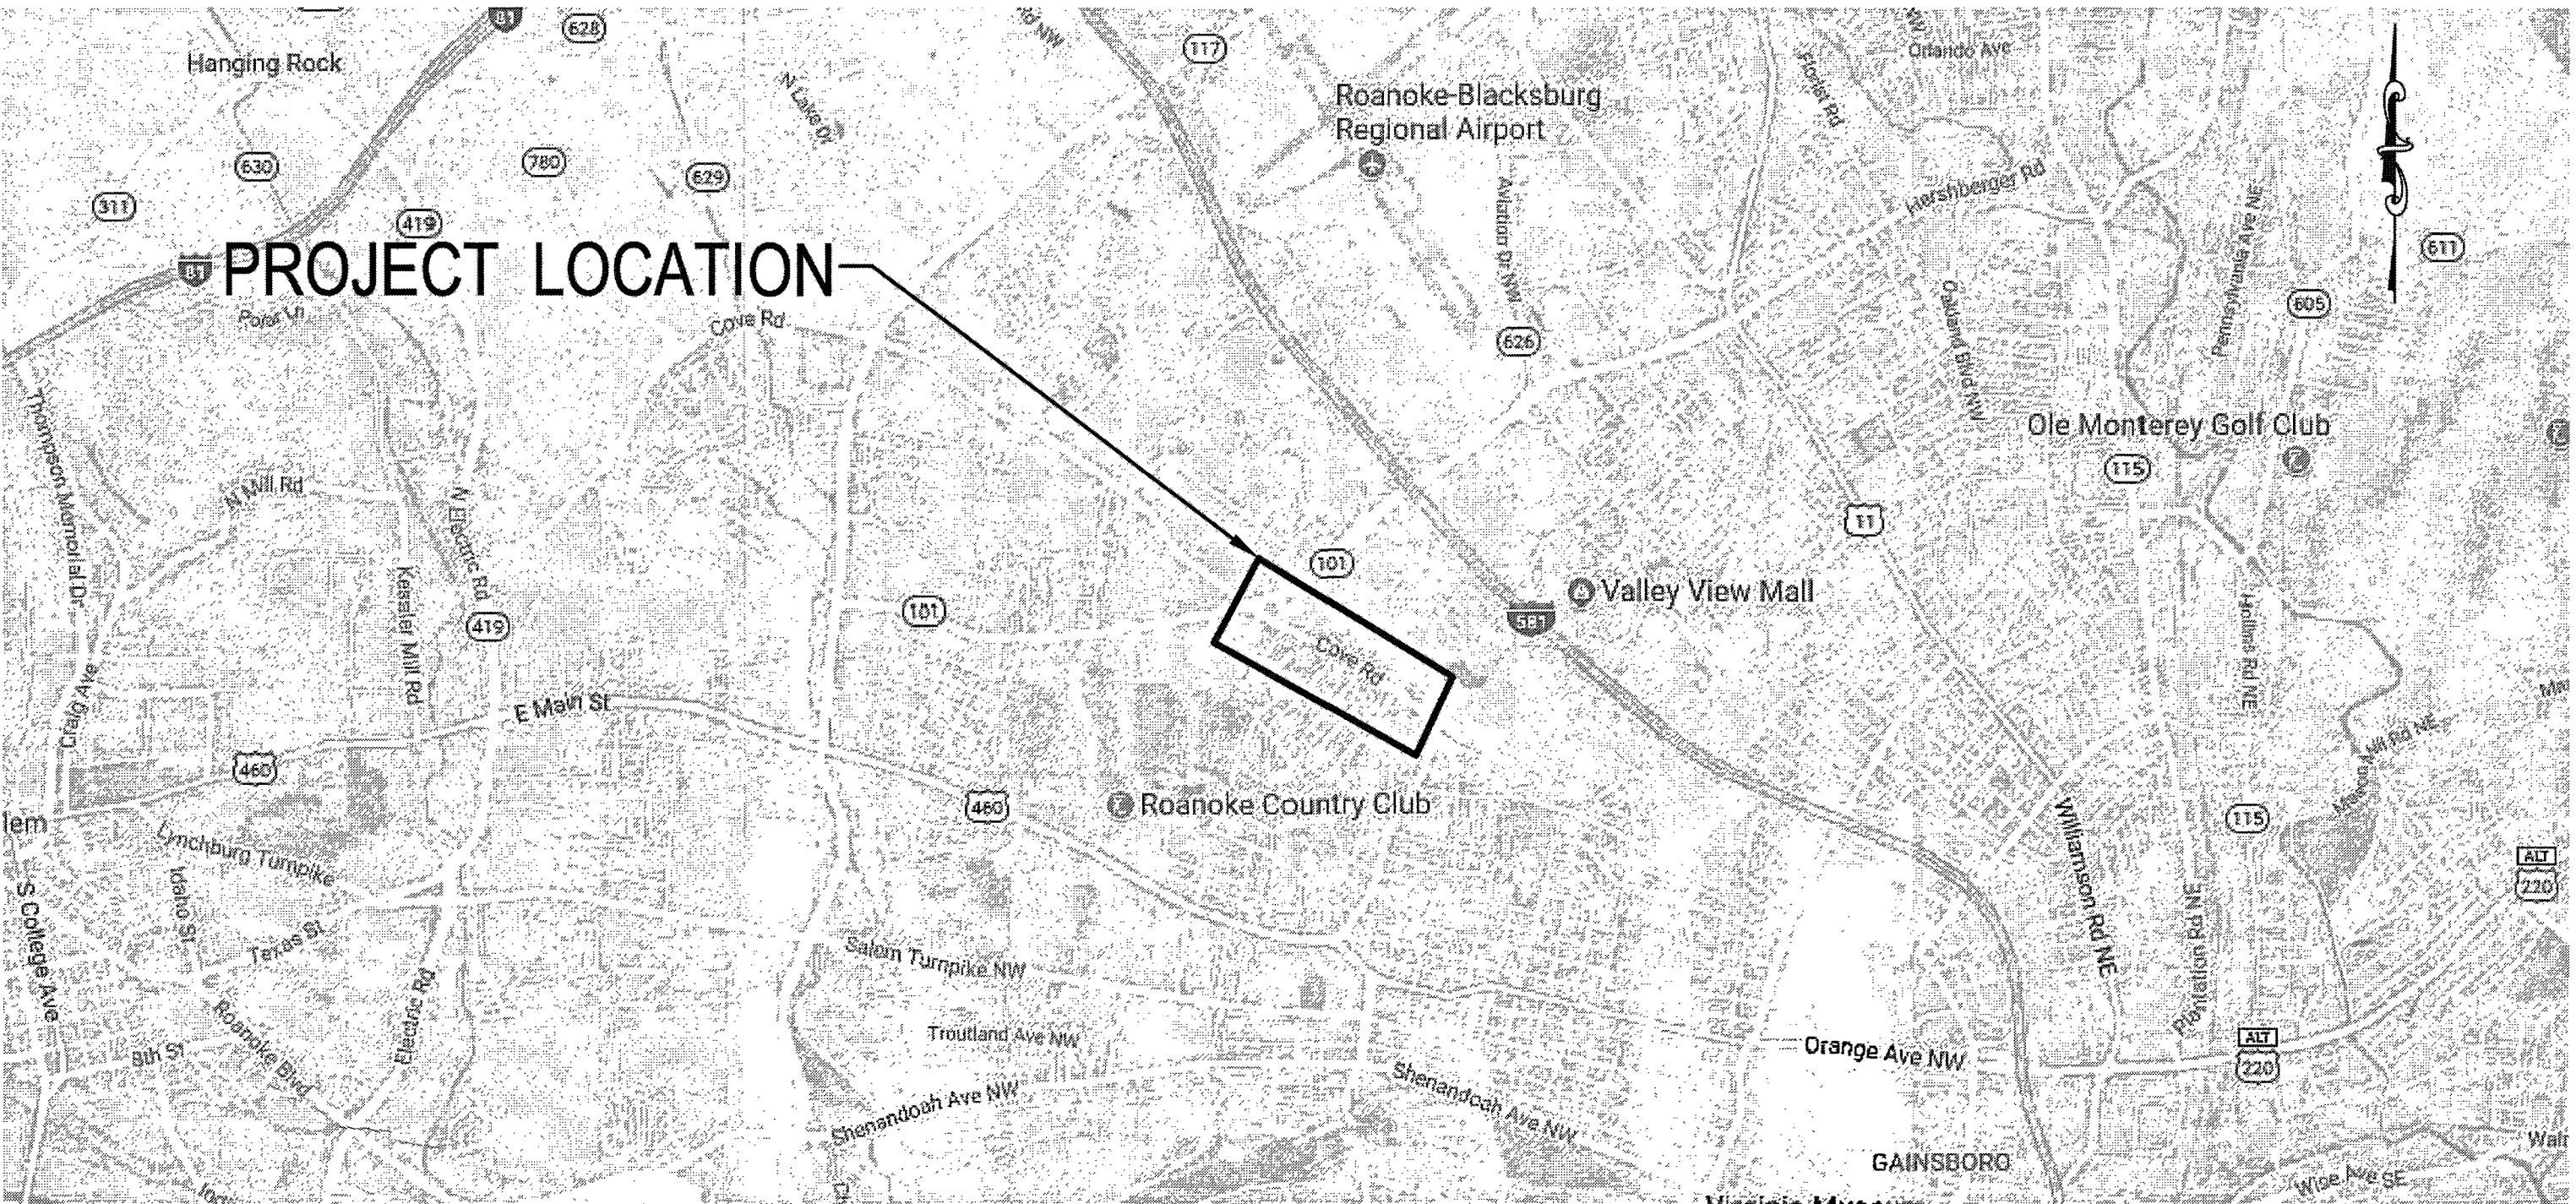

VICINITY MAP
NO SCALE


FEBRUARY 2018

WATER
Material: 12", 8", 6" DIP U.S Pipe CL350
Valves: Mueller 12", 8", 6"
Turns off to 36" 24/18 Right
Services: 1" + 2" Polyflex Endot

Sewer: Manholes - CPTP
Main: SDR35 8" National

Inspector: Brian Whitcraft
Contractor: E.C. PACE
AS Builts - 1/14/19

APPROVED FOR CONSTRUCTION

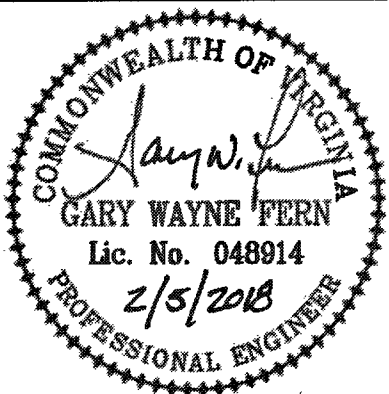

WESTERN VIRGINIA WATER AUTHORITY
601 South Jefferson Street, Suite 300
Roanoke, Virginia 24011

DES: PJM	SCALE: N/A
DRAWN: JES	HORIZ: N/A
CHECK: GWF	VERT: N/A
DATE: 02/05/18	

COVE ROAD WATER MAIN REPLACEMENT

COVER

REV	DATE	DESCRIPTION

DRAWING	SHEET
-	1