


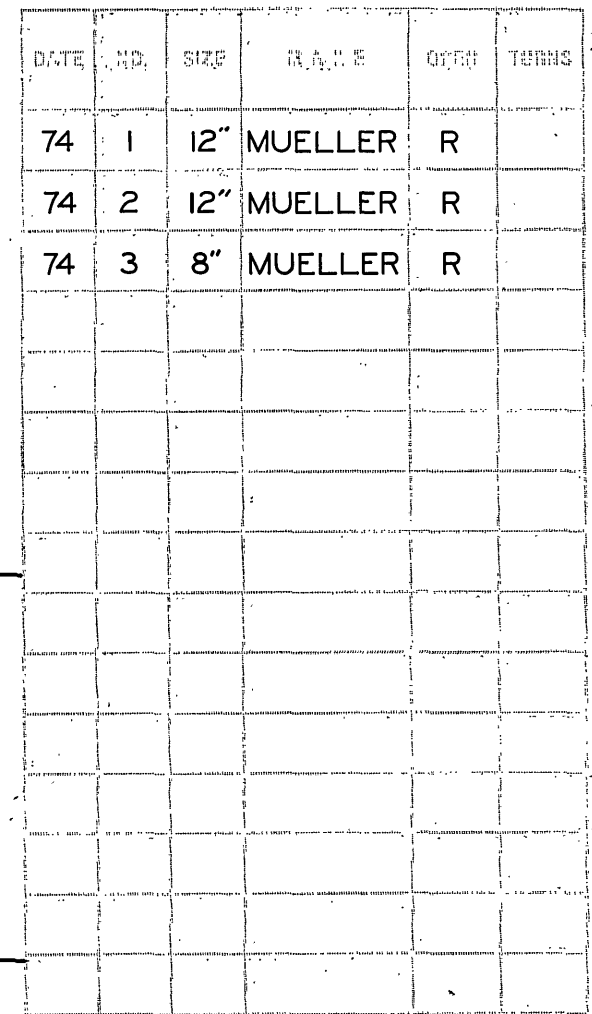

CITY OF PORTLAND - WATER DEPT
PLANS DIAGRAM
COVE ROAD &
PORTLAND AVENUE N.W.
SEC. MAP 641
DATE 1911