


Coyner Springs
1988

COYNER SPRINGS

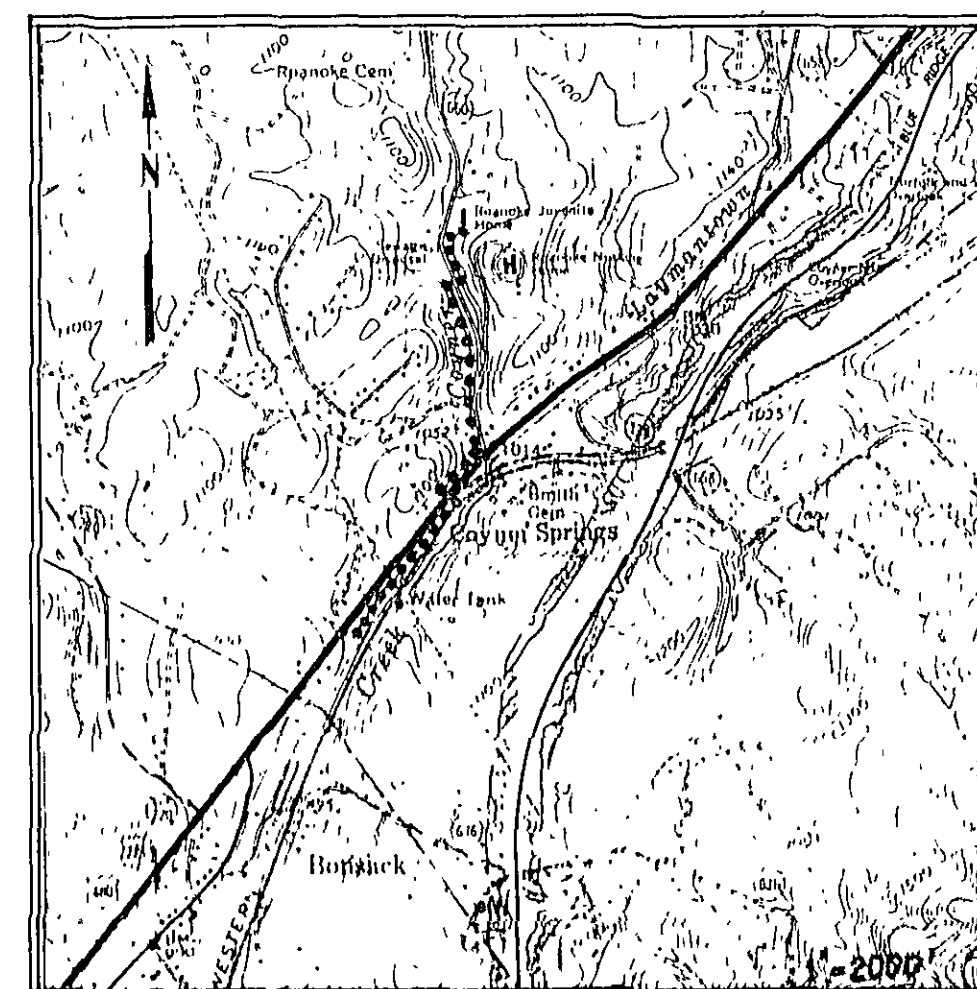


VICINITY MAP

SEWER LINE EXTENSION

BOTETOURT COUNTY, VIRGINIA

NOTE:
RECORD DRAWINGS PRODUCED DECEMBER 1987
FROM "AS BUILT" INFORMATION PROVIDED
BY DIXON CONTRACTING, INC.

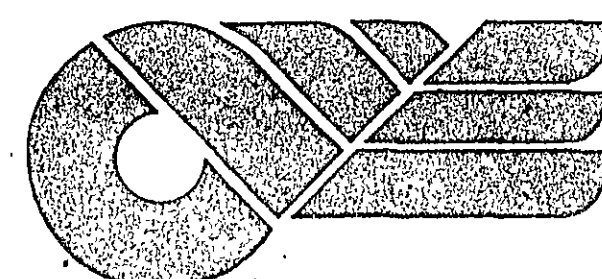

CLEAN WATER ENGINEERS, INC.
P.O. BOX 218
FINCASTLE, VIRGINIA 24090

PROJECT NO. F-88060
DATE: SEPTEMBER, 1988

PLAN No. 6453
RECORD DRAWING
DECEMBER 1987