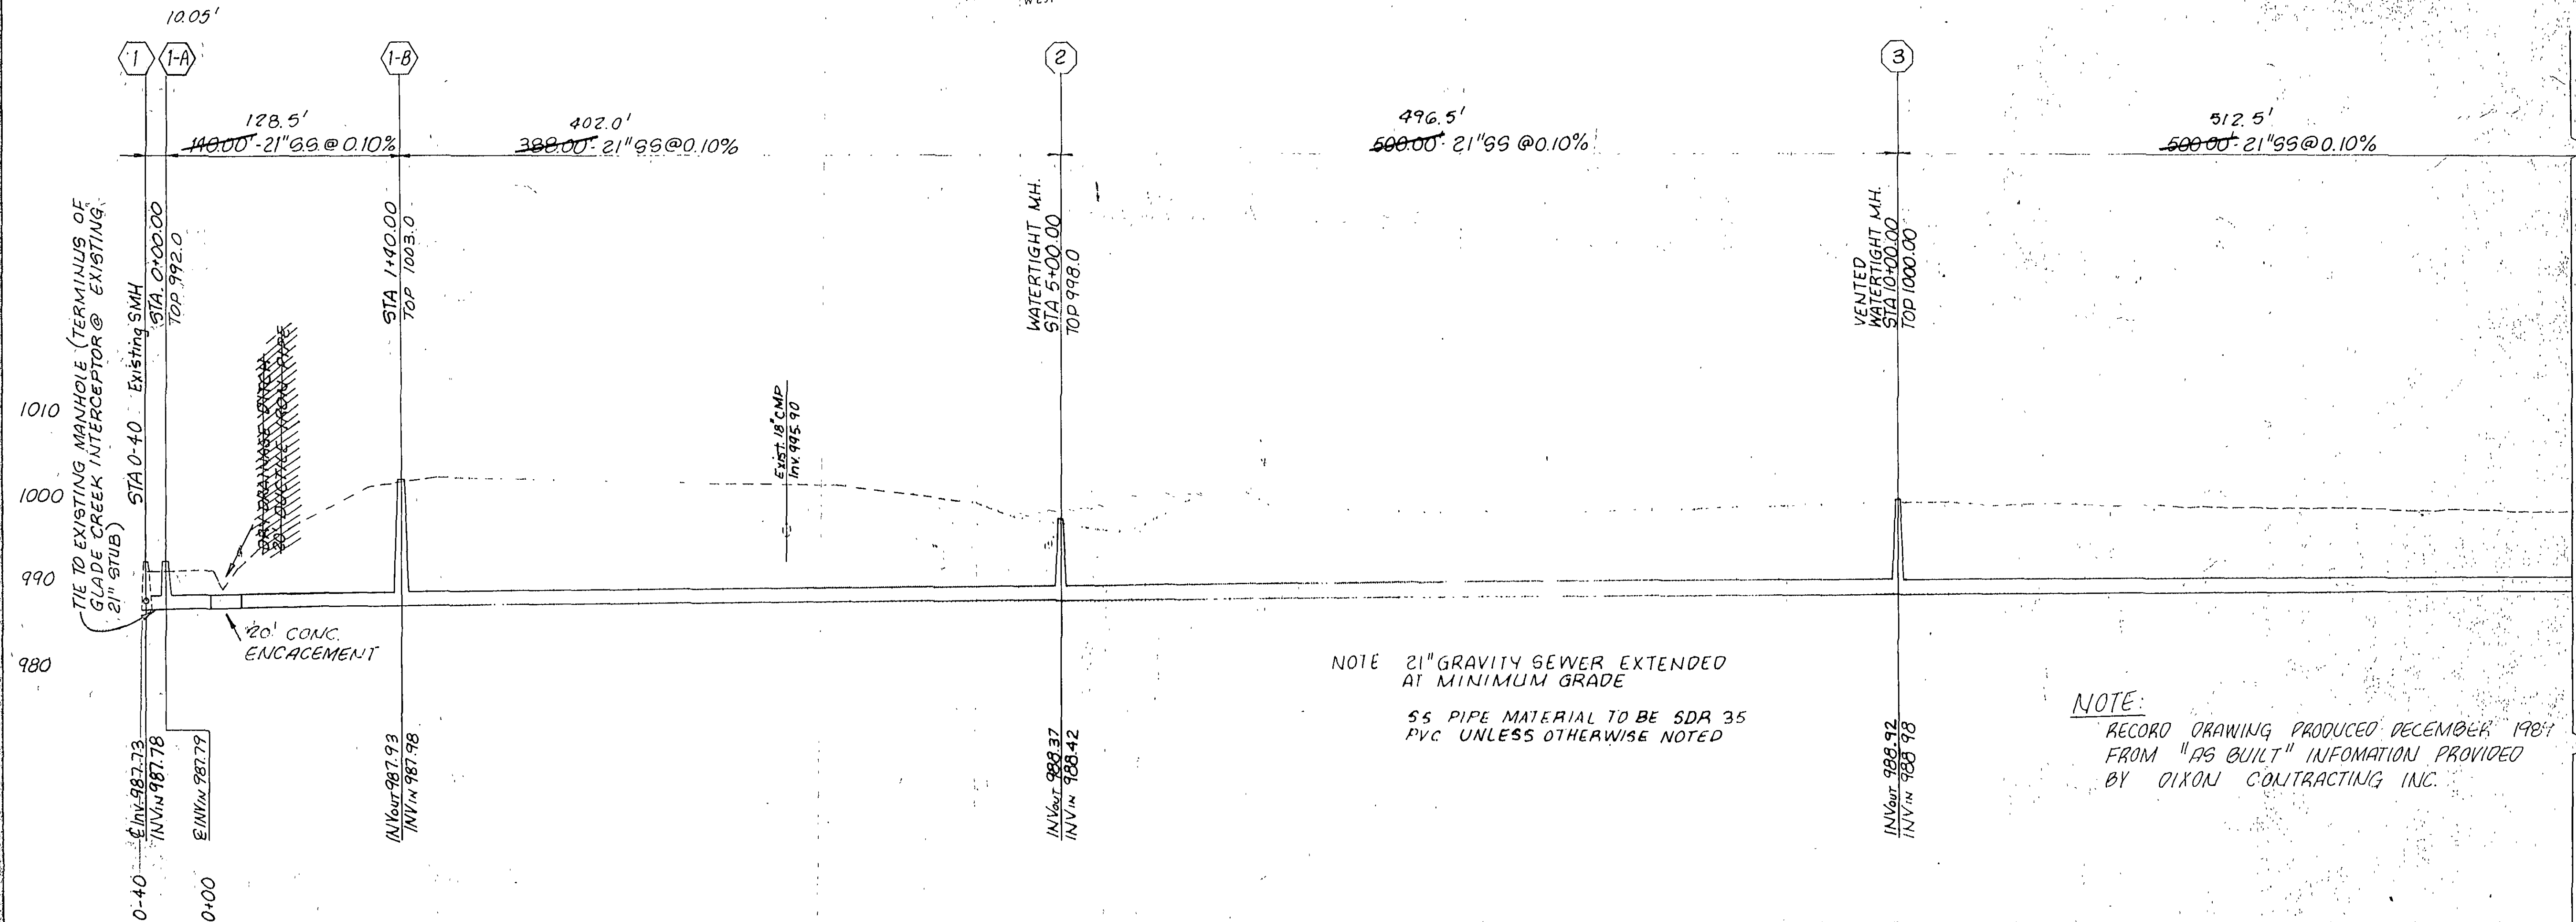
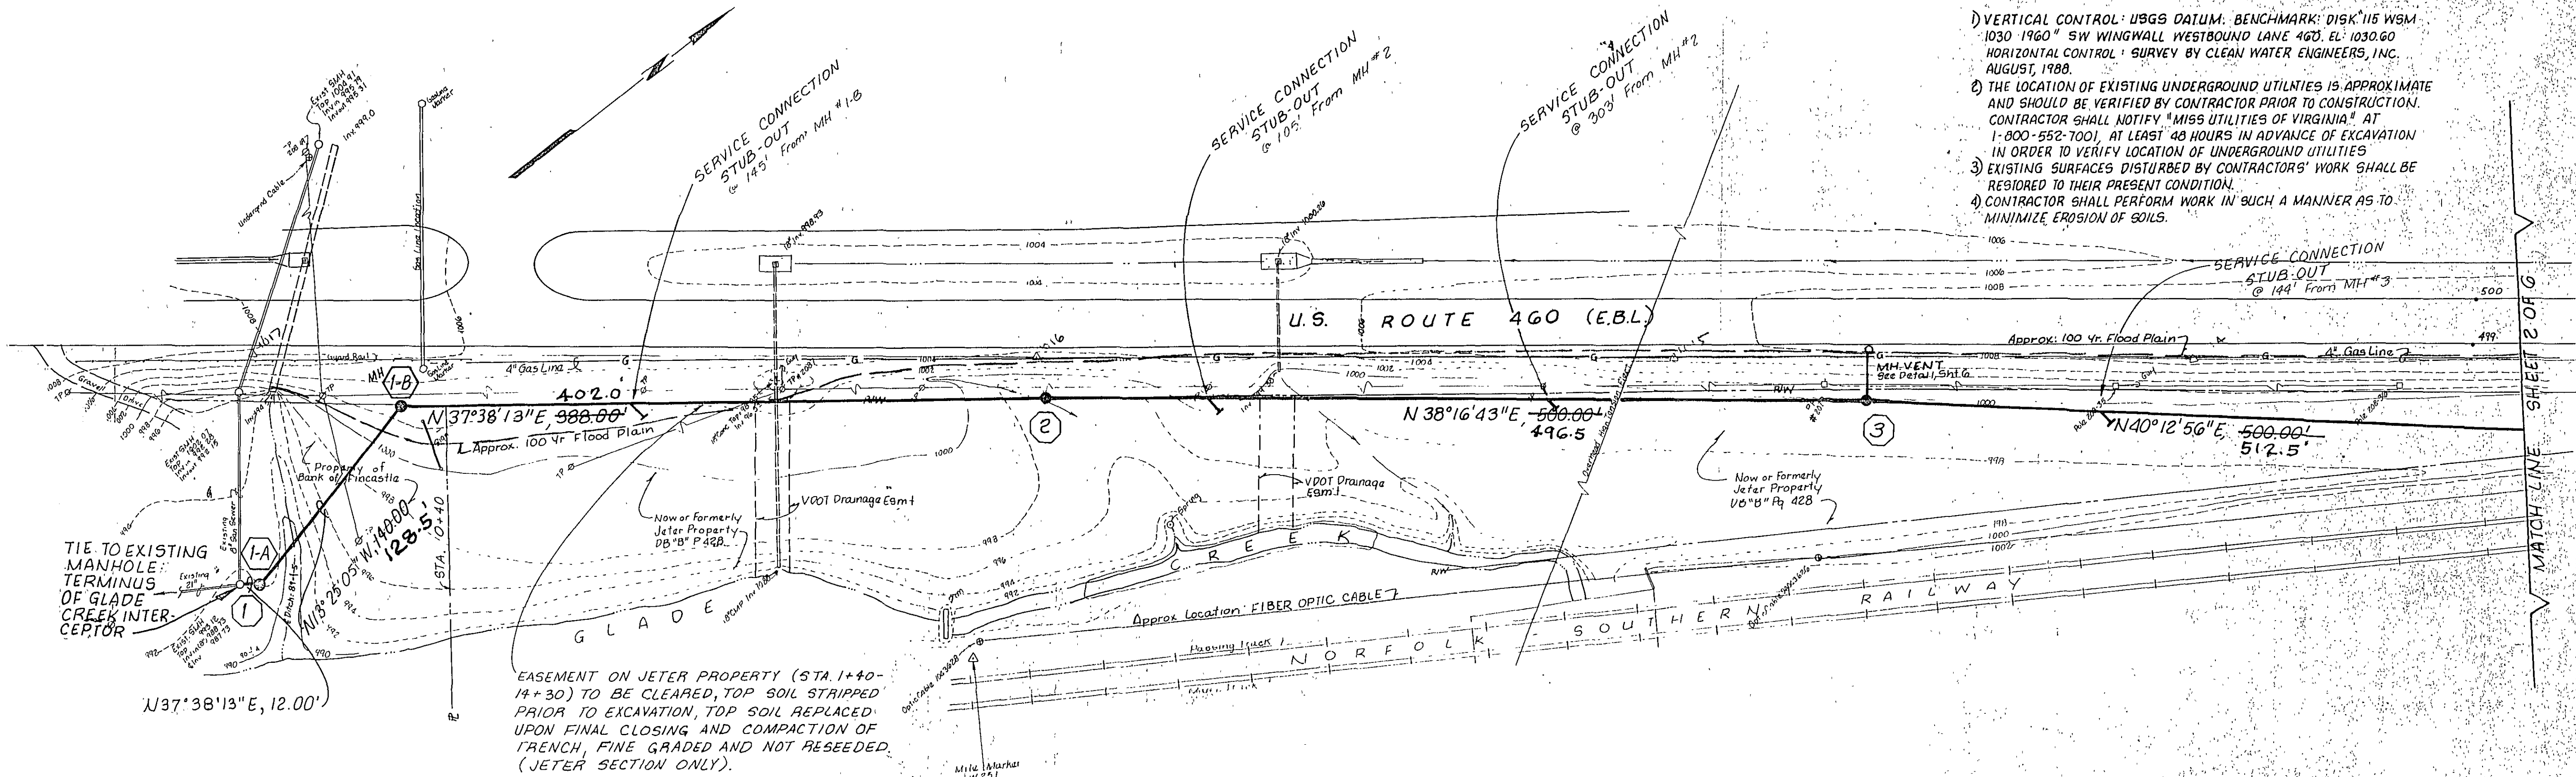


CLEAN WATER ENGINEERS, INC.

P.O. BOX 218
FINCASTLE, VIRGINIA 24090

**COYNER SPRINGS
SEWER LINE EXTENSION
BOTETOURT COUNTY, VIRGINIA**

RECORD DRAWINGS
DEC. 1987

David J. Rigby

REVISIONS		
NO.	DATE	BY
1	2/7/89	KAS
2	3/3/89	KAS
3	4/25/89	DJR
4	5/30/89	DJR

DESIGNED: DJR	SHEET 1 OF 6
DRAWN: LHJ/JTR	SCALE: HORIZ. 1"=50' VERT. 1"=10'
CHECKED: LHJ	DATE: SEPT. 1988
APPROVED: DJR	PROJECT: 88060