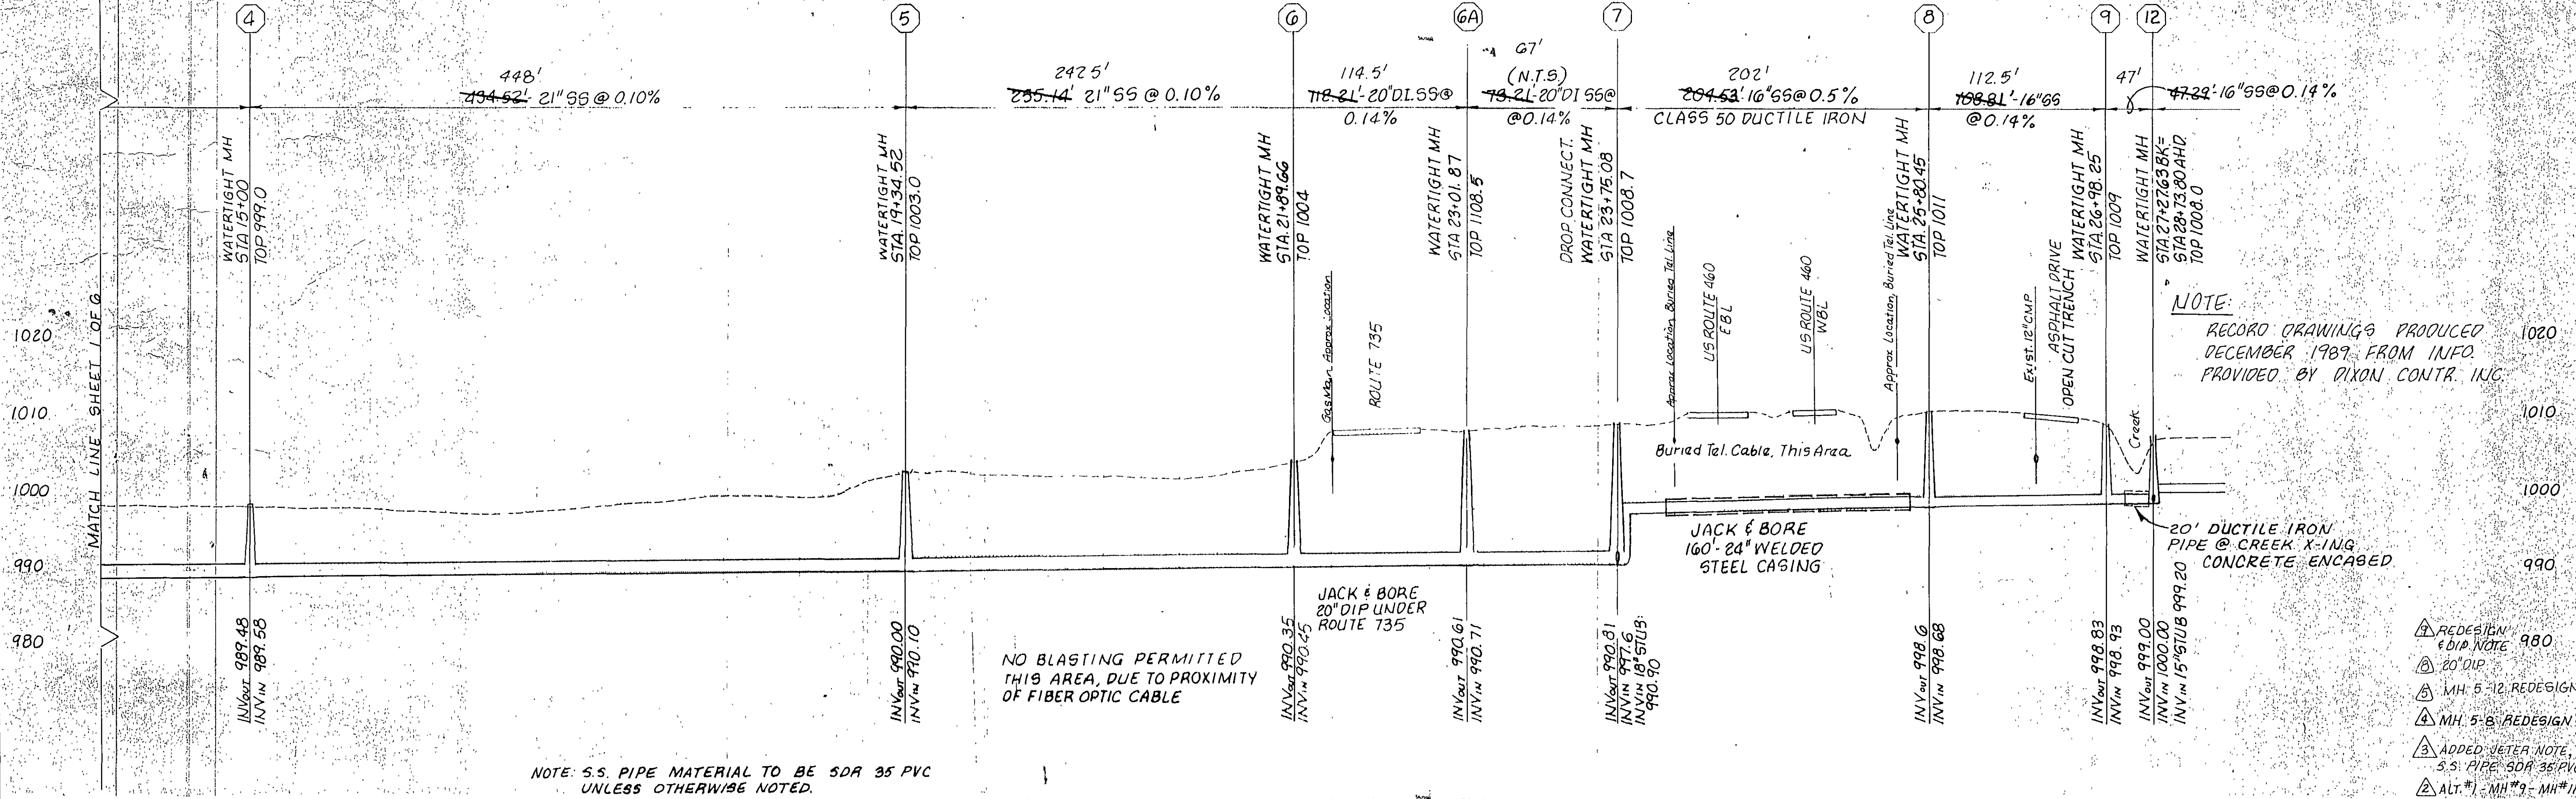
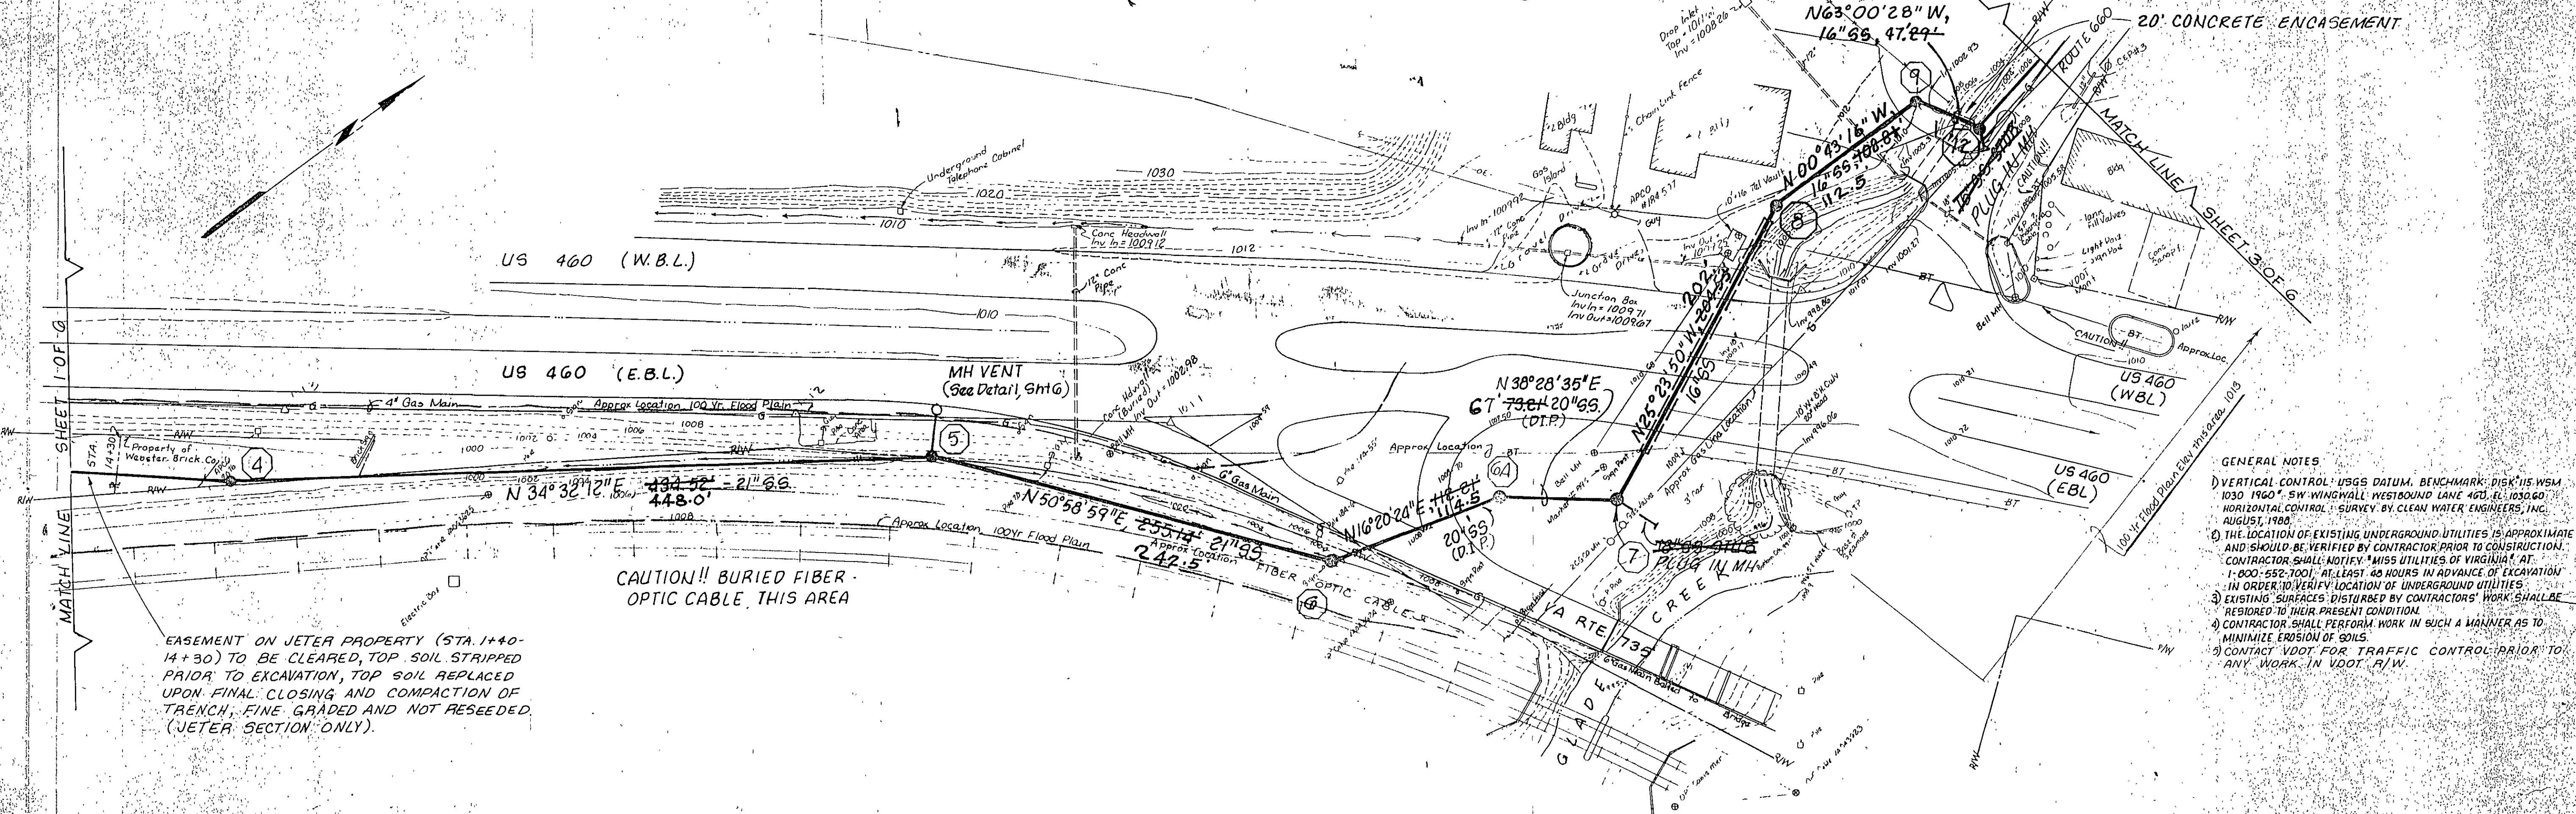


CLEAN WATER ENGINEERS, INC.

P.O. BOX 218
FINCastle, VIRGINIA 24090

**COYNER SPRINGS
SEWER LINE EXTENSION
BOTETOURT COUNTY, VIRGINIA**

RECORD DRAWINGS
DEC. 1989

David J. Ryby

REVISIONS			DESIGNED:	SHEET
NO.	DATE	BY	DJR	2 OF 6
1	10/14/88	CEB	DRAWN:	SCALE:
2	2/1/89	KAS	LHJ	HORIZ. 1"=50'
3	3/3/89	KAS	CHECKED:	VERT. 1"=10'
4	4/25/89	DJR	LHJ	DATE:
			APPROVED:	SEPT. 1988
			DJR	PROJECT:
				88060