



- GENERAL NOTES
- 1) VERTICAL CONTROL: USGS DATUM. BENCHMARK: DISK #115 WSM 1030 1960" SW WINGWALL WESTBOUND LANE 460. EL: 1030.60
HORIZONTAL CONTROL: SURVEY BY CLEAN WATER ENGINEERS, INC. AUGUST, 1988.
 - 2) THE LOCATION OF EXISTING UNDERGROUND UTILITIES IS APPROXIMATE AND SHOULD BE VERIFIED BY CONTRACTOR PRIOR TO CONSTRUCTION. CONTRACTOR SHALL NOTIFY "MISS UTILITIES OF VIRGINIA" AT 1-800-652-7001, AT LEAST 48 HOURS IN ADVANCE OF EXCAVATION IN ORDER TO VERIFY LOCATION OF UNDERGROUND UTILITIES.
 - 3) EXISTING SURFACES DISTURBED BY CONTRACTOR'S WORK SHALL BE RESTORED TO THEIR PRESENT CONDITION.
 - 4) CONTRACTOR SHALL PERFORM WORK IN SUCH A MANNER AS TO MINIMIZE EROSION OF SOILS.

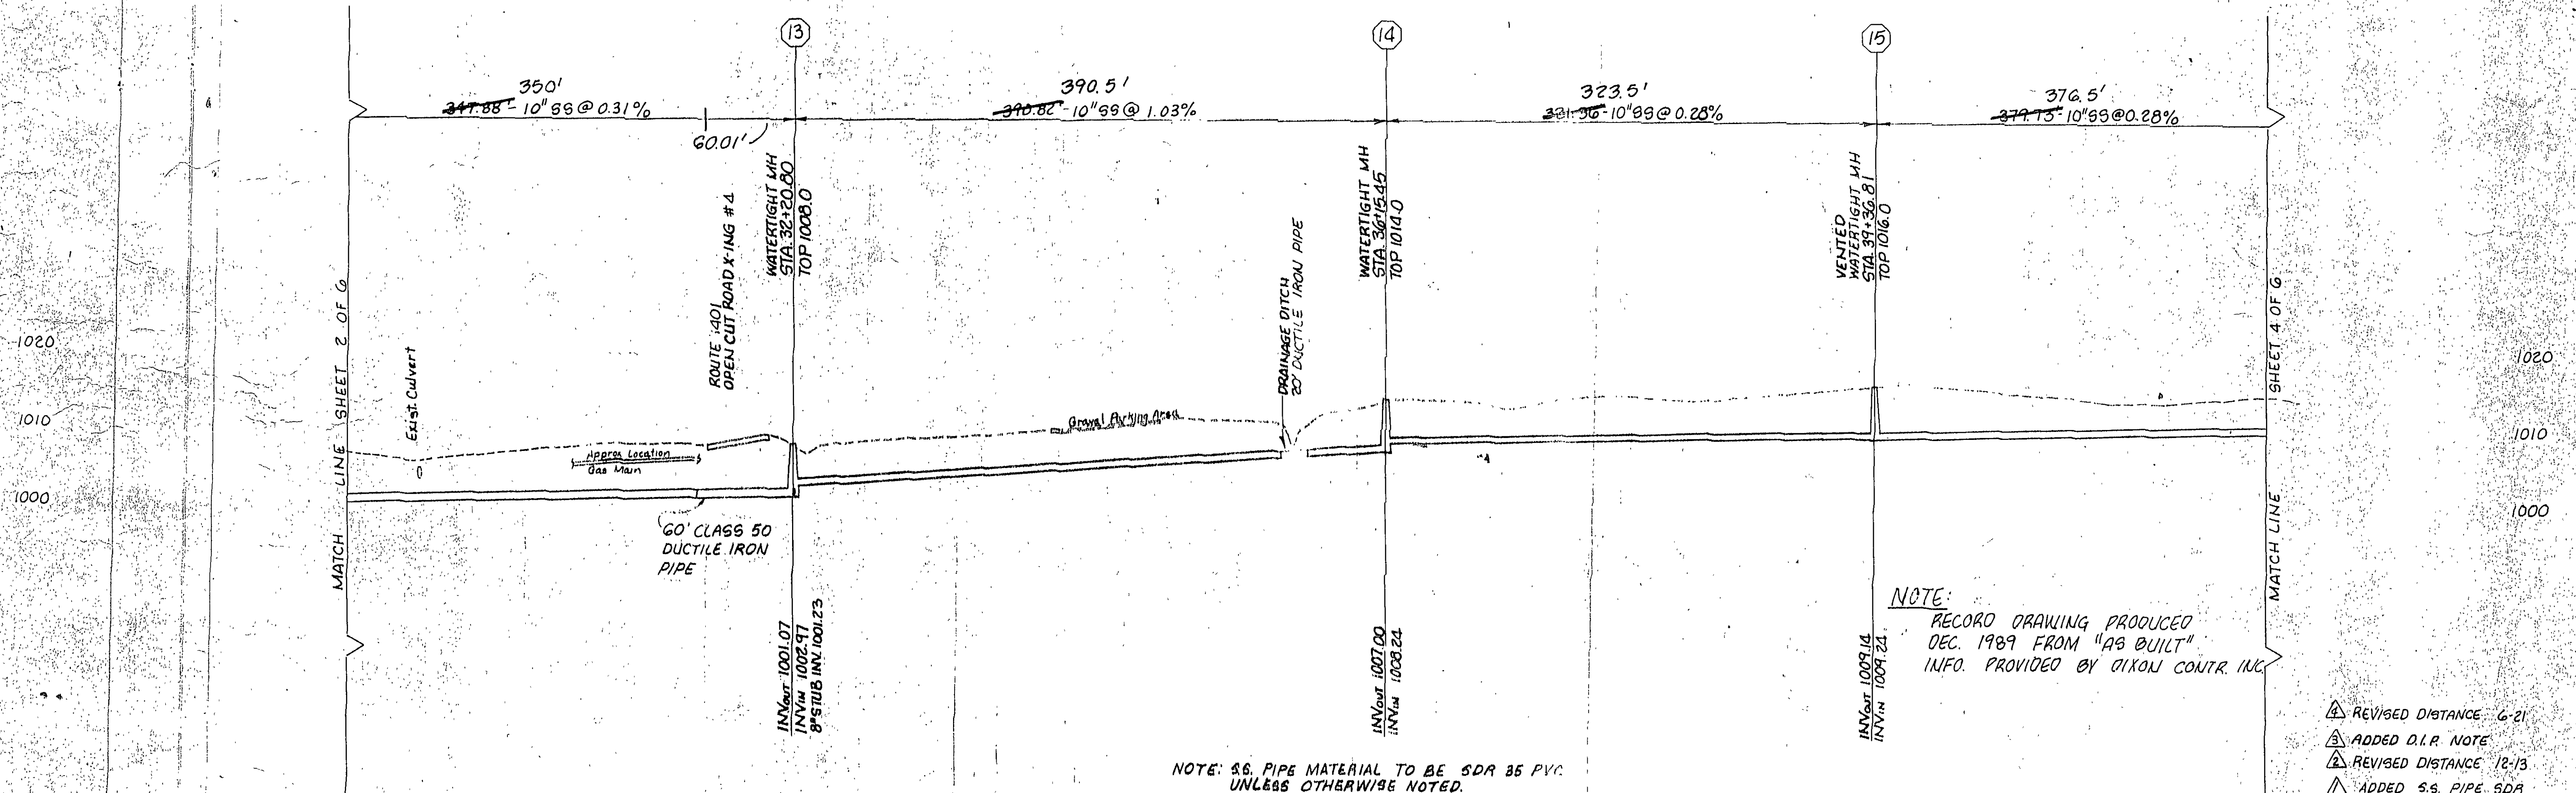

NOTE:
RECORD DRAWING PRODUCED
DEC. 1989 FROM "AS BUILT"
INFO. PROVIDED BY DIXON CONTR. INC.

- △ REVISED DISTANCE 6-21
- △ ADDED D.I.R. NOTE
- △ REVISED DISTANCE 12-13
- △ ADDED S.S. PIPE SDR 35 PVC

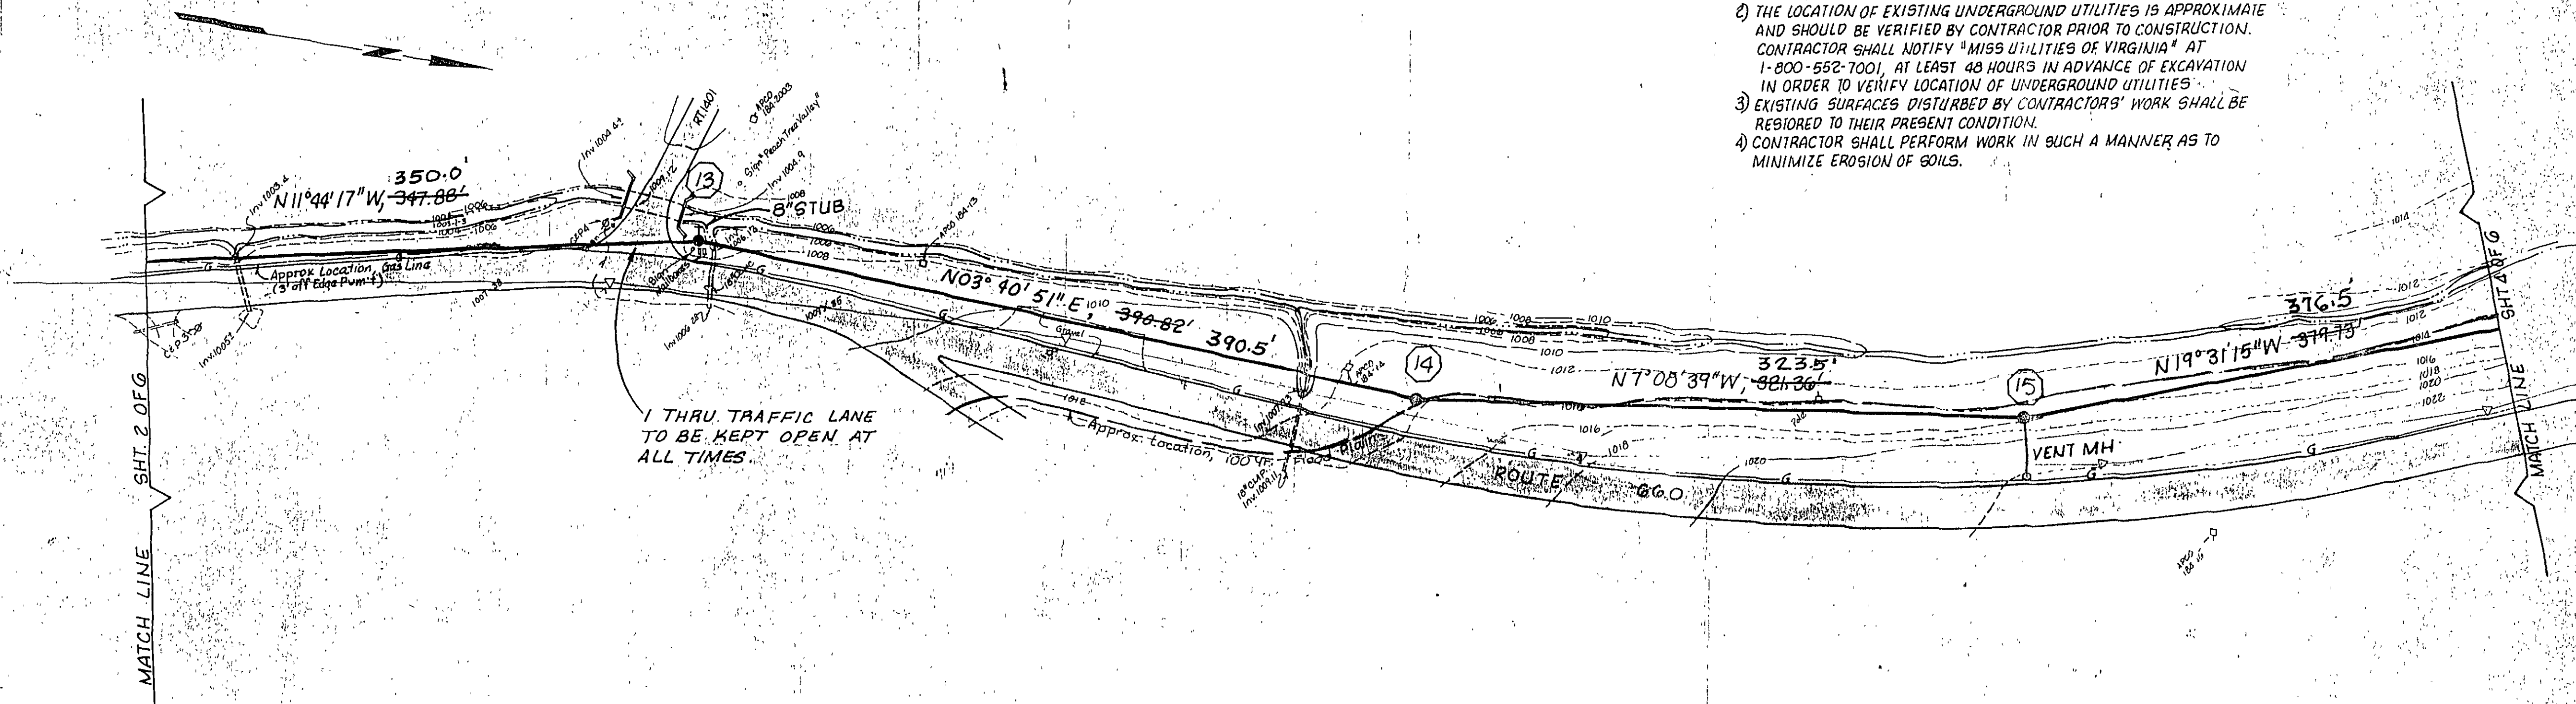

CLEAN WATER ENGINEERS, INC.

P.O. BOX 218
FINCastle, VIRGINIA 21090

COYNER SPRINGS
SEWER LINE EXTENSION
BOTETOURT COUNTY, VIRGINIA

RECORD DRAWINGS
DEC. 1989

REVISIONS		
NO.	DATE	BY
1	3/3/89	KAS
2	4/25/89	DJR
3	6-19-89	WGP
4	6/21/89	DJR

DESIGNED: DJR	SHEET 3 OF 6
DRAWN: LHJ/JRM	SCALE: HORIZ. 1"=50' VERT. 1"=10'
CHECKED: LHJ	DATE: SEPT. 1988
APPROVED: DJR	PROJECT: 88060