


PROJECT LOCATION MAP

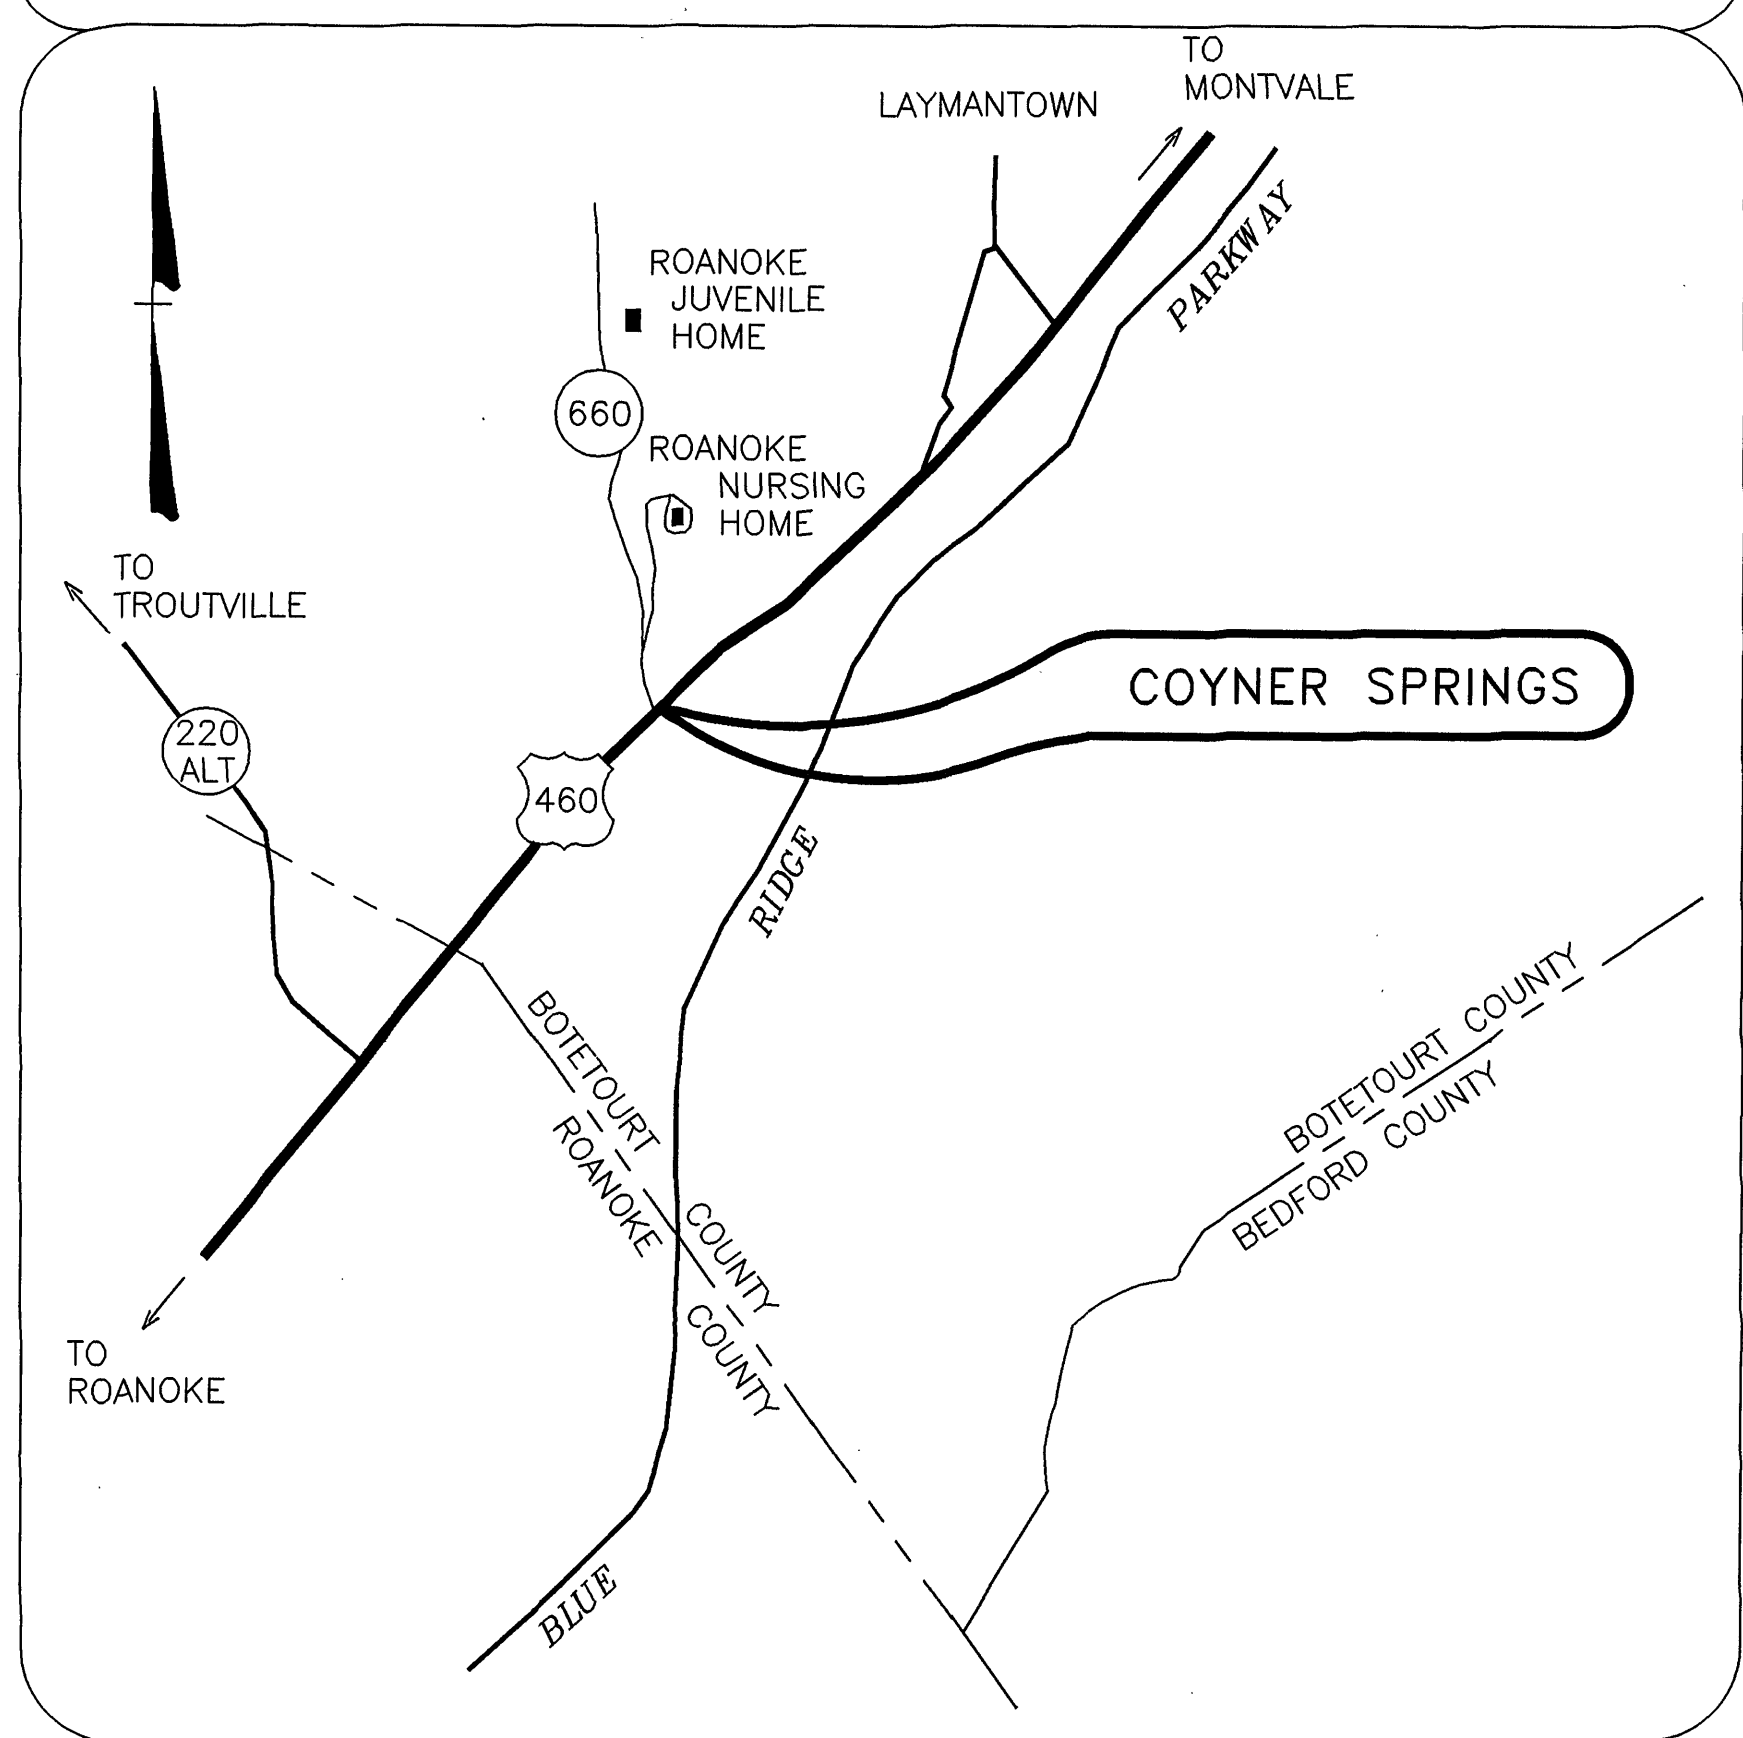

INDEX OF SHEETS

- 1 TITLE
- 2 SUMMARY OF QUANTITIES
- 3 GENERAL ABBREVIATIONS & LEGEND
- 4 SHEET INDEX & GENERAL NOTES
- 5 PLAN & PROFILE
- 6 PLAN & PROFILE
- 7 PLAN & PROFILE
- 8 PLAN & PROFILE
- 9 PLAN & PROFILE
- 10 PLAN & PROFILE
- 11 PLAN & PROFILE
- 12 PLAN & PROFILE
- 13 METER VAULT DETAILS

OFFICE OF CITY ENGINEER
ROOM 350
MUNICIPAL BUILDING
215 CHURCH AVENUE, S.W.
ROANOKE, VIRGINIA 24011

RECORD DRAWINGS

CONSULTING ENGINEERS

Mattern & Craig


CONSULTING ENGINEERS

SURVEYORS

701 FIRST STREET

ROANOKE, VIRGINIA

COMMISSION NUMBER: 1417

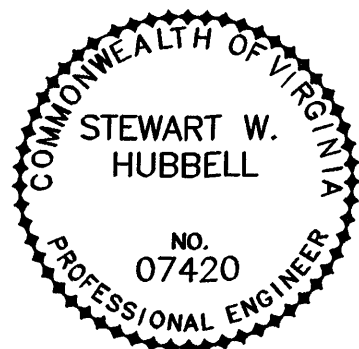

PROJECT NAME

COYNER SPRINGS WATER LINE
CITY OF ROANOKE, VIRGINIA

PROJECT NUMBER: 6309

REVISION BY	DESCRIPTION:	DATE
REVISION BY	DESCRIPTION:	DATE
REVISION BY	DESCRIPTION:	DATE
REVISION BY	DESCRIPTION:	DATE

APPROVED FOR CONSTRUCTION

ROANOKE CITY ENGINEER	DATE
DIRECTOR OF PUBLIC WORKS	DATE
DIRECTOR OF PUBLIC UTILITIES AND OPERATIONS	DATE
	DATE
	DATE

ADVERTISED DATE:

SET NUMBER:

SHEET NUMBER: 1 OF 13

Coyner Springs Water Line - 1975