



PLAN - WATER METER VAULT #1 SCALE: 1/2" = 1'-0"

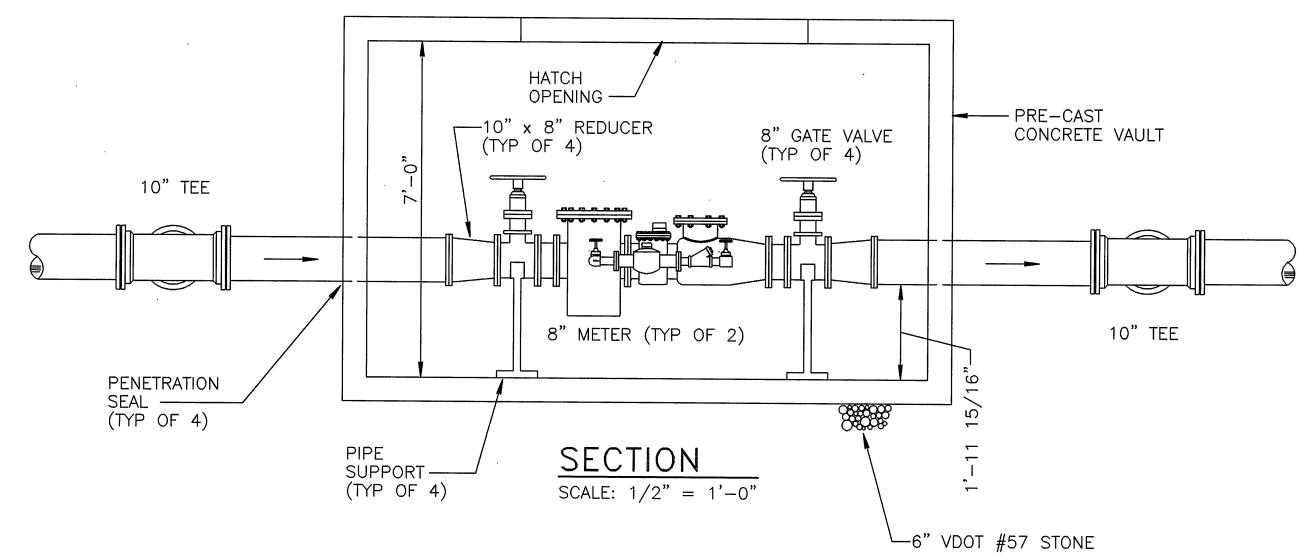



- * NOTES:
- 1. Meters to be Neptune Protectus III Fire Service Meter Assemblies by Schlumberger Industries. Meter size to be 8—inch main meter and 2—inch disc meter.
- 2. Valves to be 8—inch flanged, resilient seat gate valves.
- 3. Vault to be 8' wide x 12' long x 7' high (inside dimensions).

 Vault to be Model No. 8127 as manufactured by Penn—Cast Products.
- 4. Hatch to be Bilco Traffic Type w/ double door entry Hatch dimensions to be 72"x54".
- 5. Install valve, pipe and meter supports as required for complete installation.
- * THESE NOTES APPLY ONLY TO VAULT METER #1 (WHICH ADHERE TO COUNTY OF ROANOKE STANDARDS) SEE SPECIFICATIONS FOR VAULT EQUIPMENT IN METER VAULTS #2 AND #3.

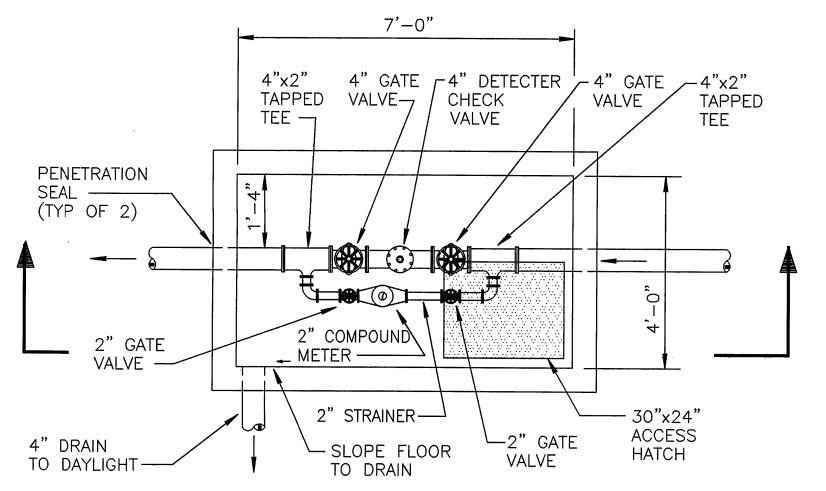


PLAN - WATER METER VAULT #2 SCALE: 1/2" = 1'-0"

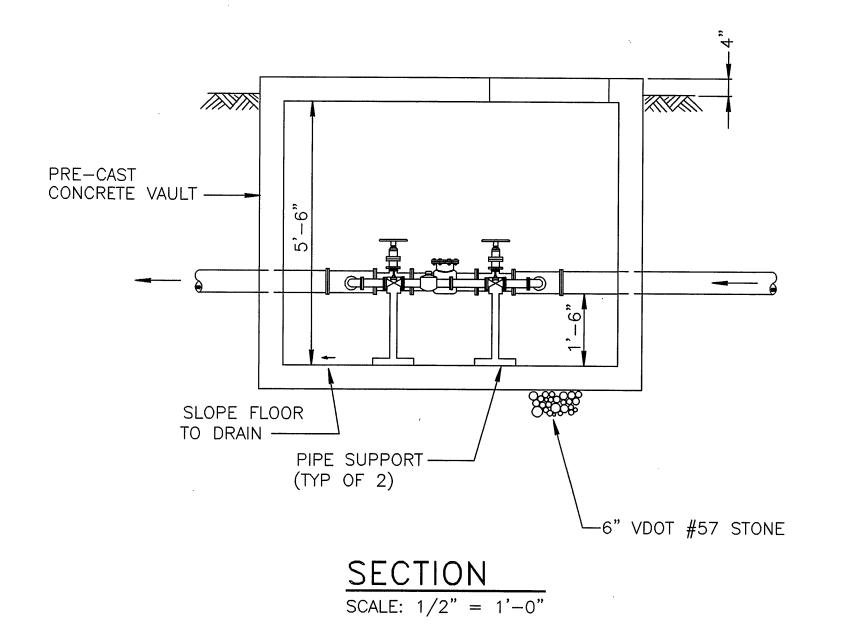

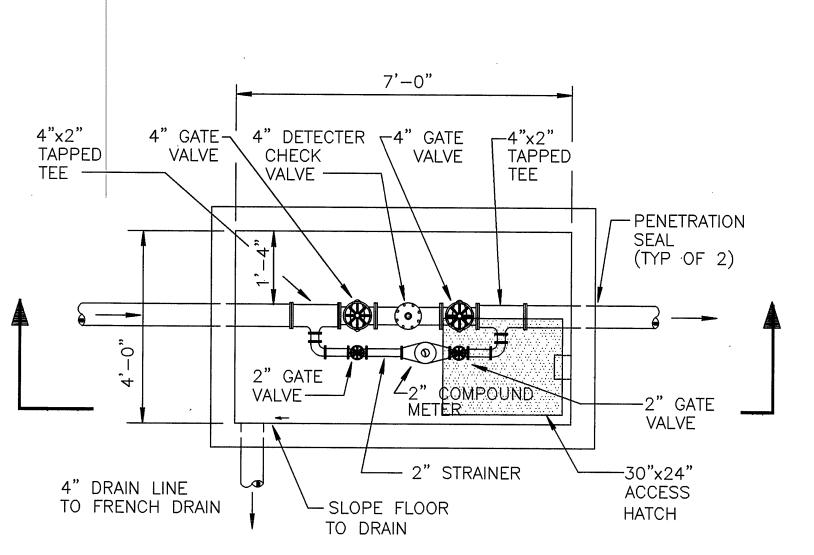


PLAN - WATER METER VAULT #3 SCALE: 1/2" = 1'-0"

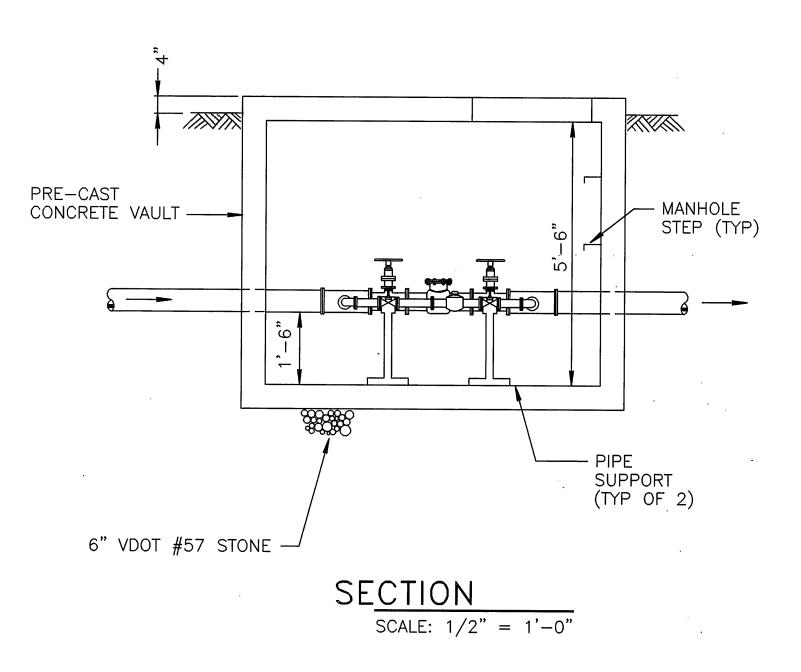

RECORD DRAWINGS



	DESIGNED:		
		BCC	
	DRAWN:		
•		FMP	
	CHECKED:		
		SWH	

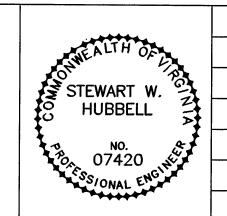

***	REV.	DATE	DESCRIPTION	BY	APP.	DATE
WART W.						
WART W.						NOVEM
₽ }						199
NO. 07420 NO. ONAL ENGINE						COMM.
ONAL ENG.						141
		1	·			

MBER 95 <u>/I. NO.</u>

COYNER SPRINGS WATER LINE DETAILS CITY OF ROANOKE,

SCALE: AS NOTED

VIRGINIA

PROJECT NO.

SHEET