



# VICINITY MAP

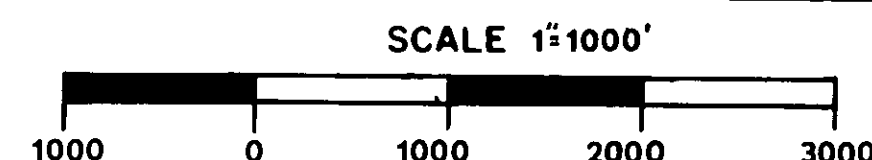

## INDEX OF SHEETS



| SHEET NUMBER | DESCRIPTION              |
|--------------|--------------------------|
| 1            | TITLE                    |
| 2            | QUANTITIES & DETAILS     |
| 3            | PLAN & PROFILE, LINE F   |
| 4            | PLAN & PROFILE, LINE F   |
| 5            | PLAN & PROFILE, LINE E-G |
| 6            | PLAN & PROFILE, LINE H   |
| 7            | PLAN & PROFILE, LINE I   |

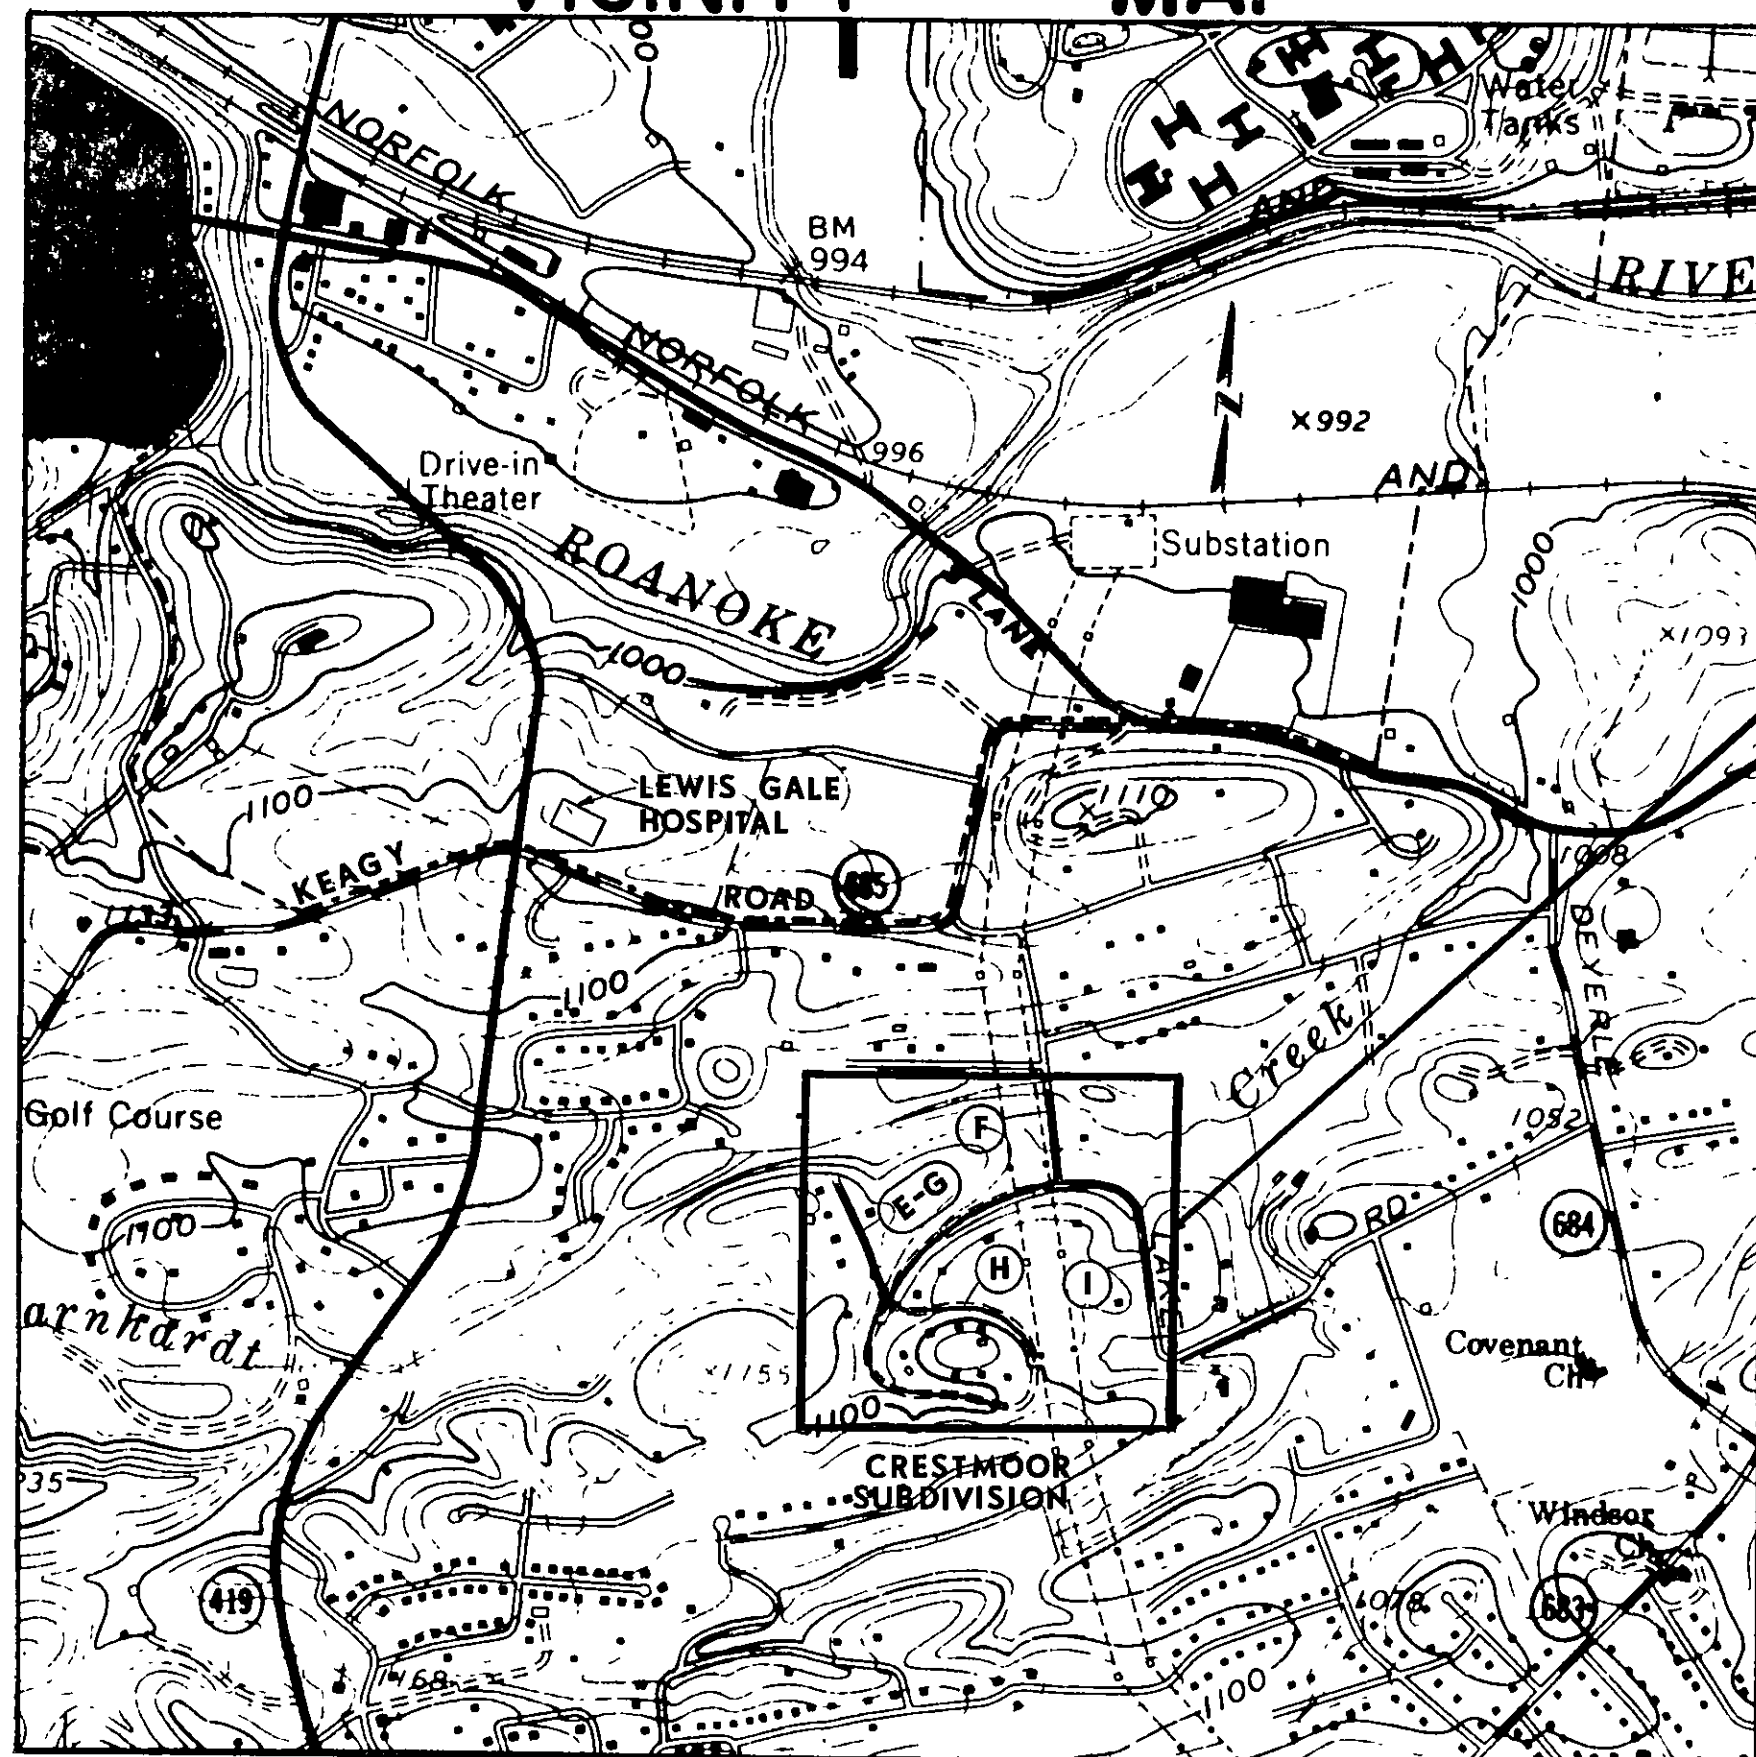

# ROANOKE , VIRGINIA

## OFFICE OF CITY ENGINEER CONSTRUCTION PLAN CRAVENS-BARNHART SEWAGE COLLECTION SYSTEM PROJECT II

PREPARED BY  
BUFORD T. LUMSDEN & ASSOCIATES, P.C.  
CERTIFIED LAND SURVEYORS  
ROANOKE, VIRGINIA  
DATE : 17 OCTOBER 1980

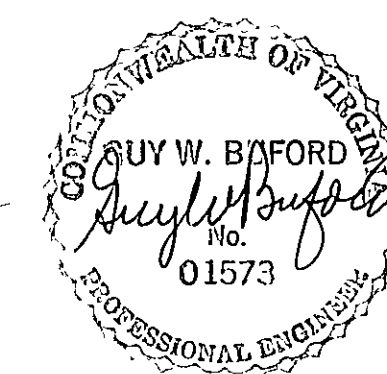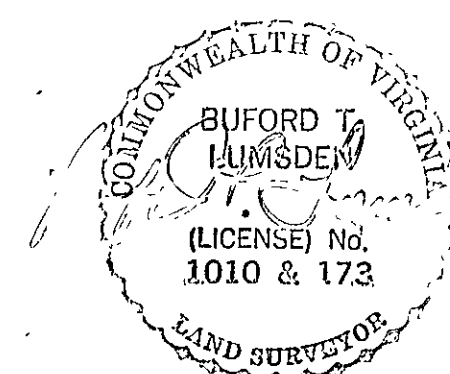

|               |      |           |      |
|---------------|------|-----------|------|
|               |      |           |      |
|               |      |           |      |
|               |      |           |      |
| SHEET NO.     | DATE | SHEET NO. | DATE |
| PLANS REVISED |      |           |      |

| APPROVED FOR CONSTRUCTION |                                                        |
|---------------------------|--------------------------------------------------------|
| 22 Dec 80<br>DATE         | Robert B. Bunker<br>CITY ENGINEER                      |
| 10-22-80<br>DATE          | Thomas A. B. Bunker<br>DIRECTOR OF PUBLIC WORKS        |
| 10-22-80<br>DATE          | Robert B. Bunker<br>DIRECTOR OF UTILITIES & OPERATIONS |
| DATE                      |                                                        |
| DATE                      |                                                        |
| DATE                      |                                                        |

AS BUILT

|          |
|----------|
| APPROVED |
| DATE     |
| APPROVED |
| DATE     |

SHEET 1 OF 7

PLAN NO. 5699