

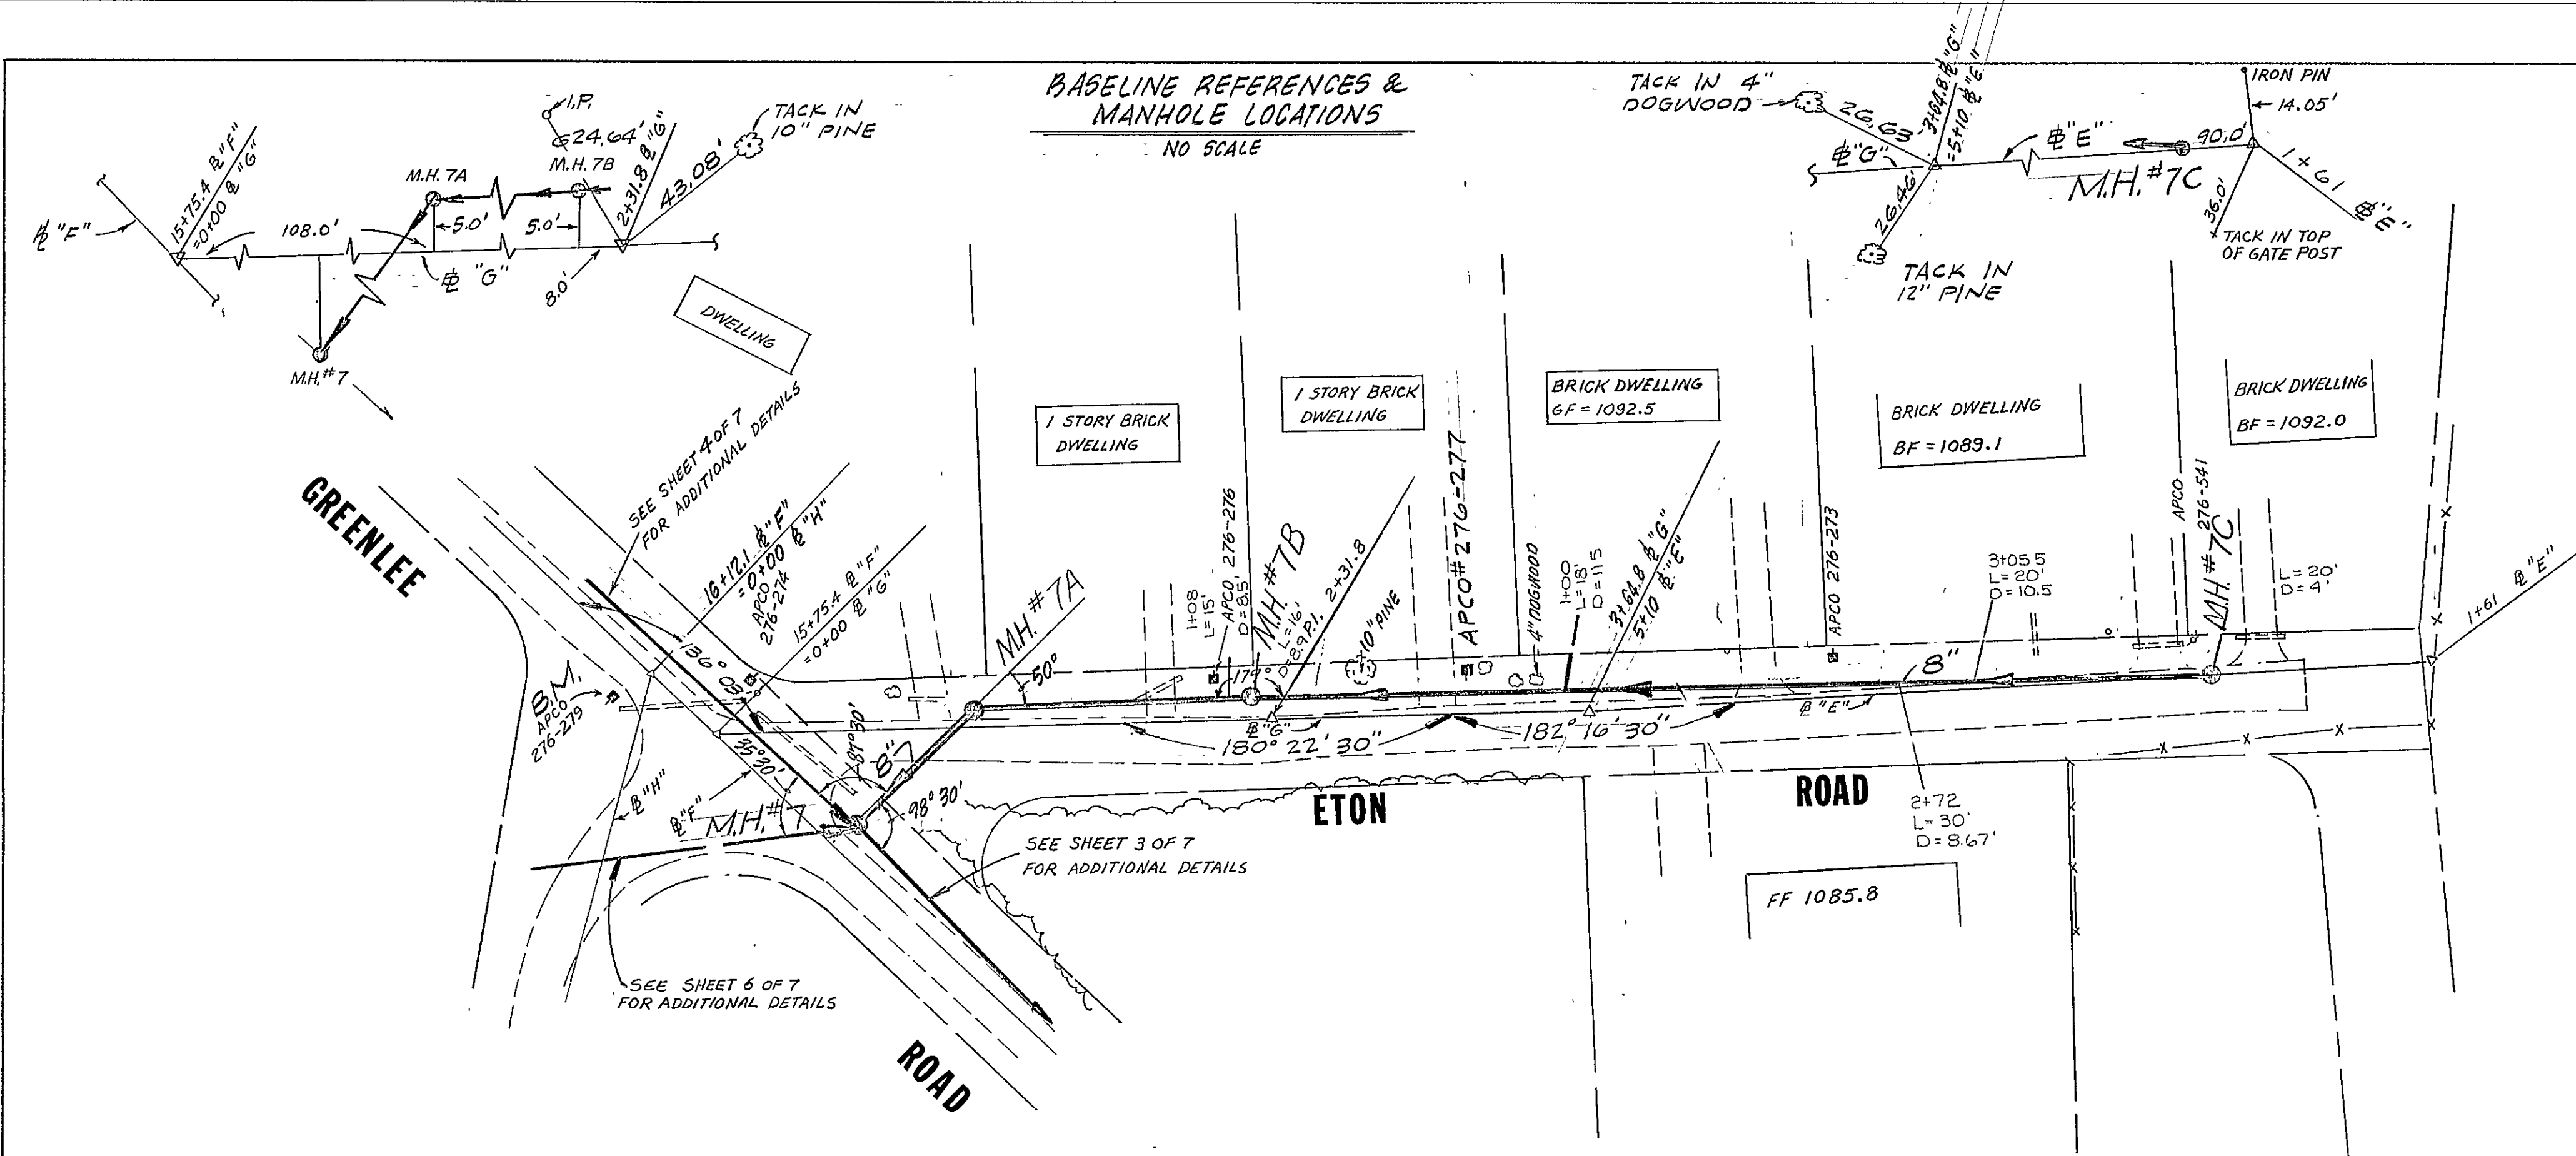


DATE	BY	REVISIONS
		1. SUBMITTER'S PLANS CHECKED
		2. NOTE BOOK ALIGNMENT CHECKED
		3. STRUCTURE NOTATION CHECKED
		4. NO. OF WAY CHECKED
		5. NO.

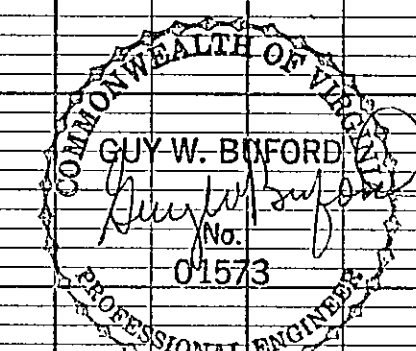

DATE	BY	REVISIONS
		1. SUBMITTER'S PLANS CHECKED
		2. NOTE BOOK GRADES CHECKED
		3. STRUCTURE NOTATION CHECKED
		4. NO.

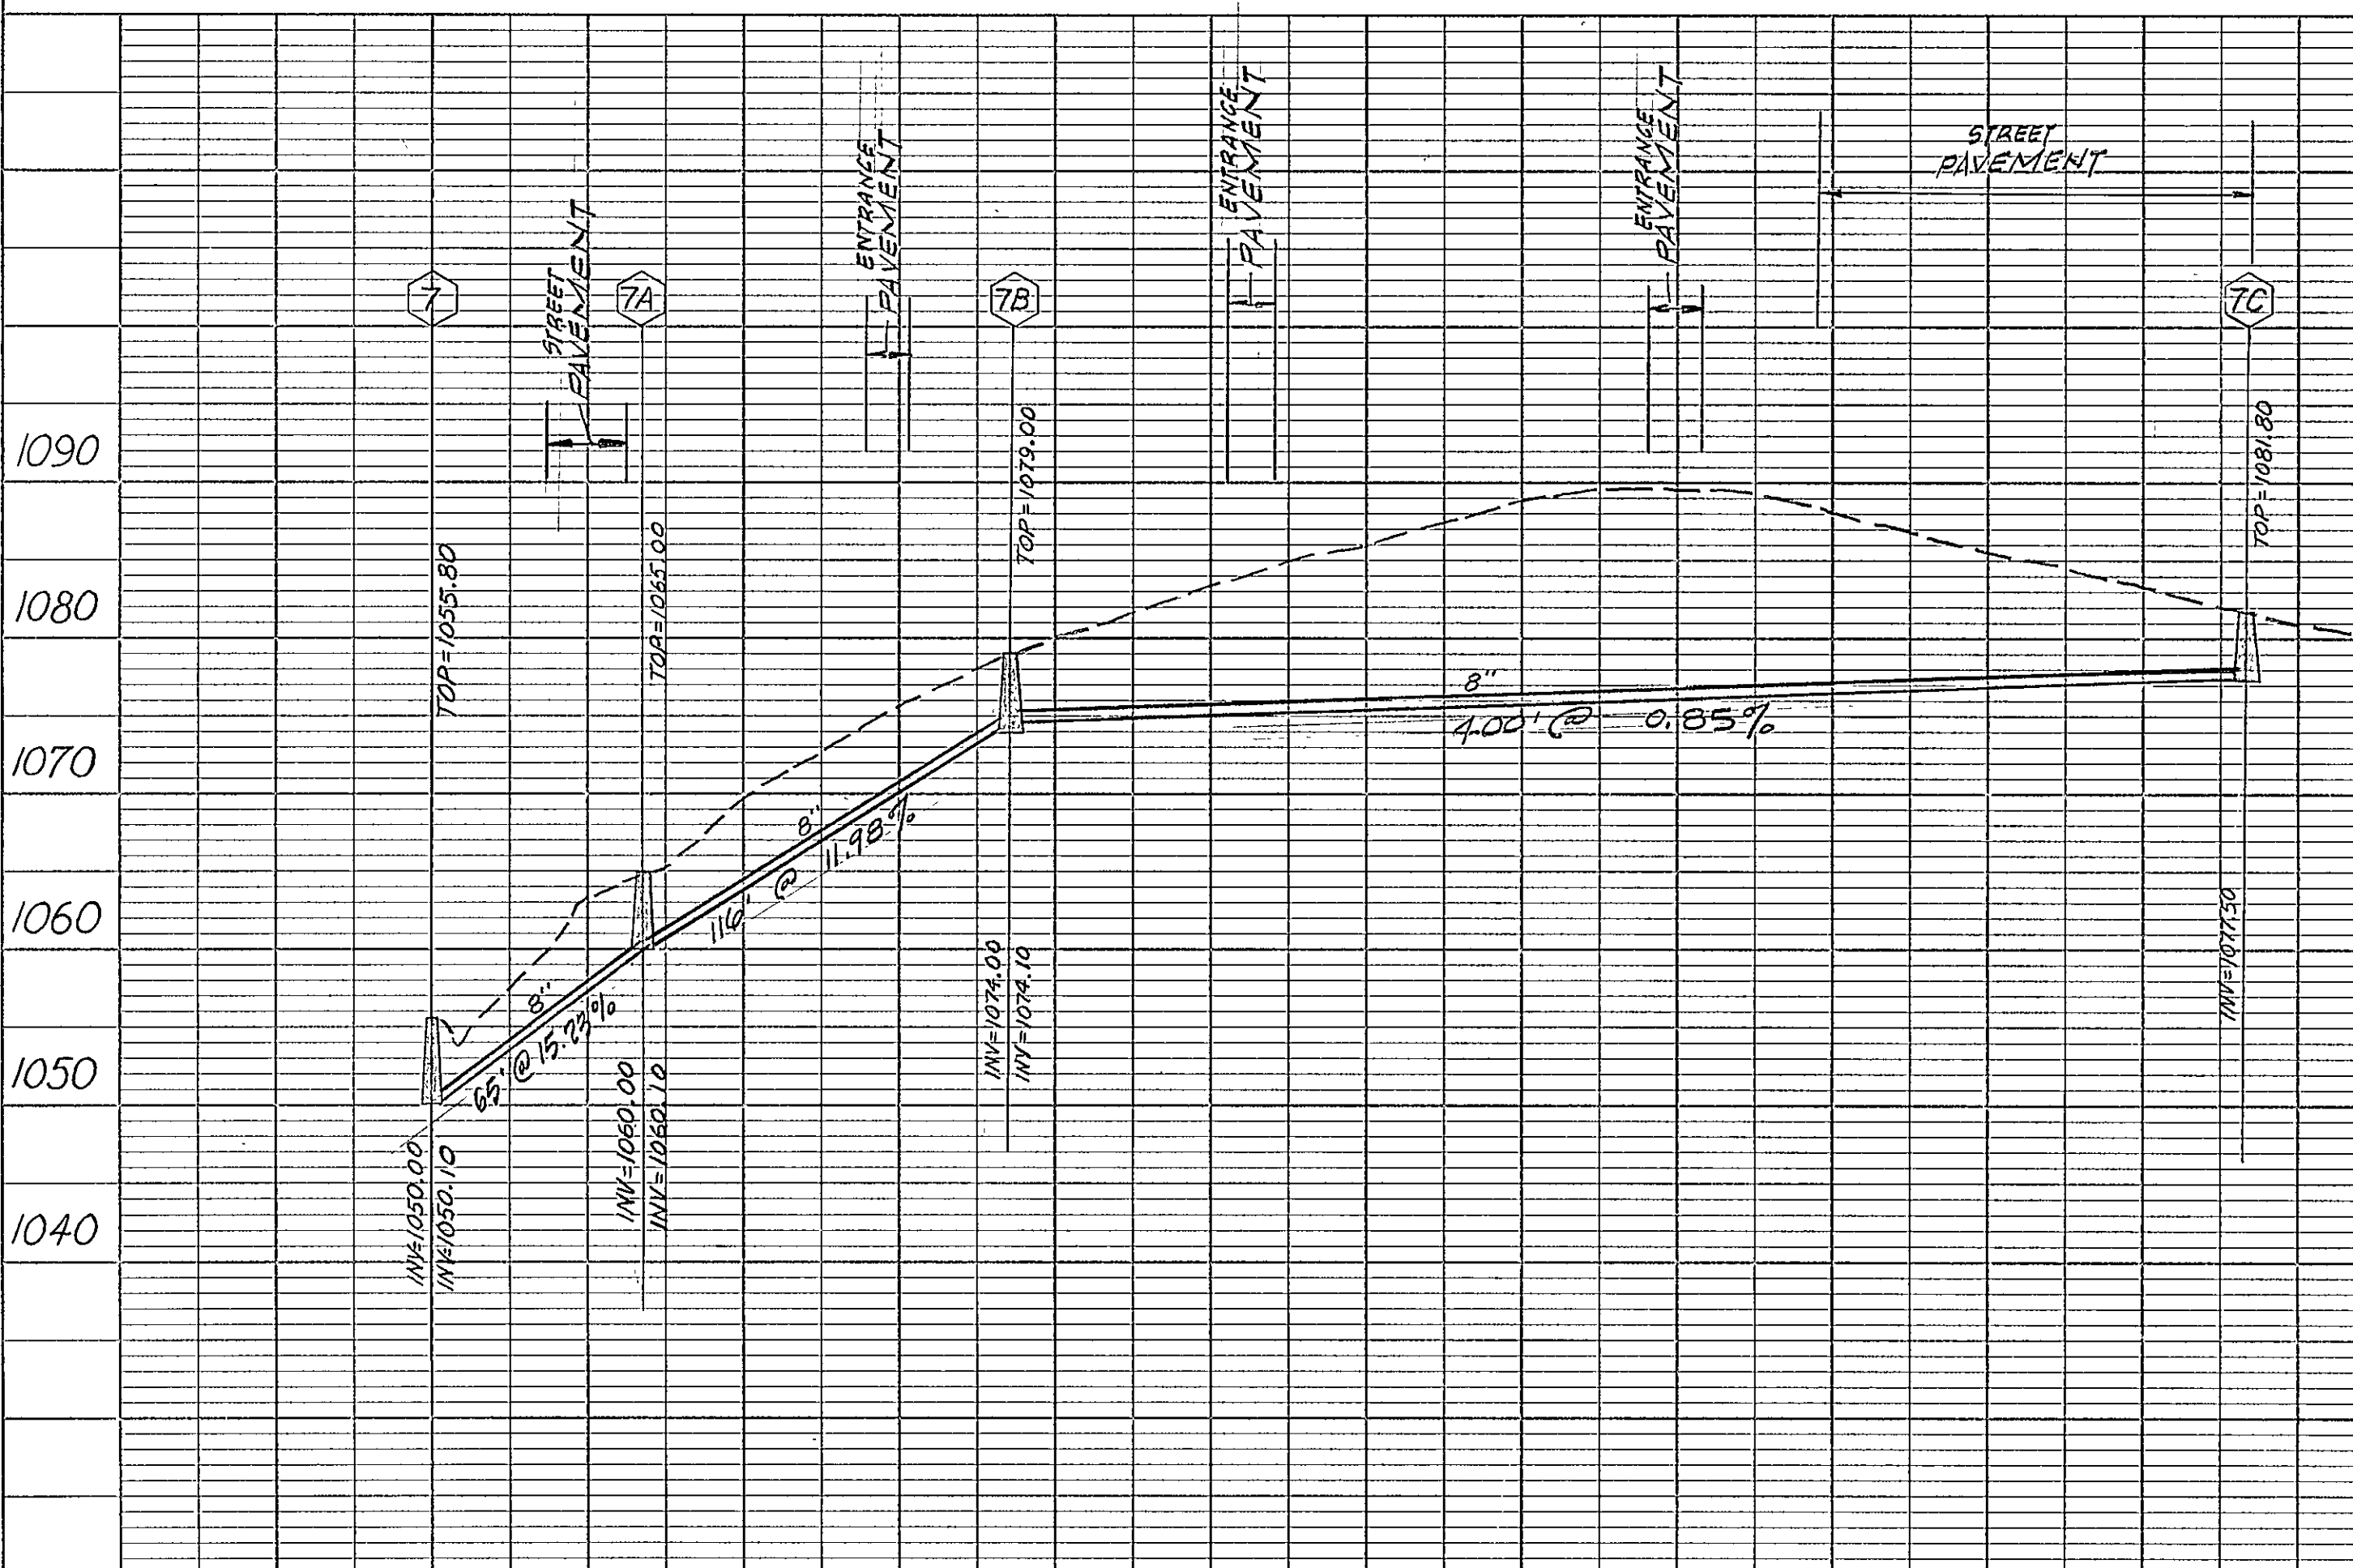

BENCHMARK: PK NAIL IN APCO PIPE NO. 276-279, 17.5' AT STATION 16+16.00 B "F" ELEV. = 1060.39

AS BUILT

PLAN & PROFILE
OF
**CRAVENS-BARNHART
SEWAGE COLLECTION SYSTEM**

PROJECT II
LINE E-G

CITY OF ROANOKE, VIRGINIA

SCALE: AS NOTED DATE: 17 OCT. 1980

BU-FORD T. LUNSDEN & ASSOCIATES, P.C.
CERTIFIED LAND SURVEYORS
ROANOKE, VIRGINIA

PLAN NO. 5699

SHEET 5 OF 7